



Pumping Arrangement S.S. No 91.

Iron S.S. "TAPOENON" report No 11639

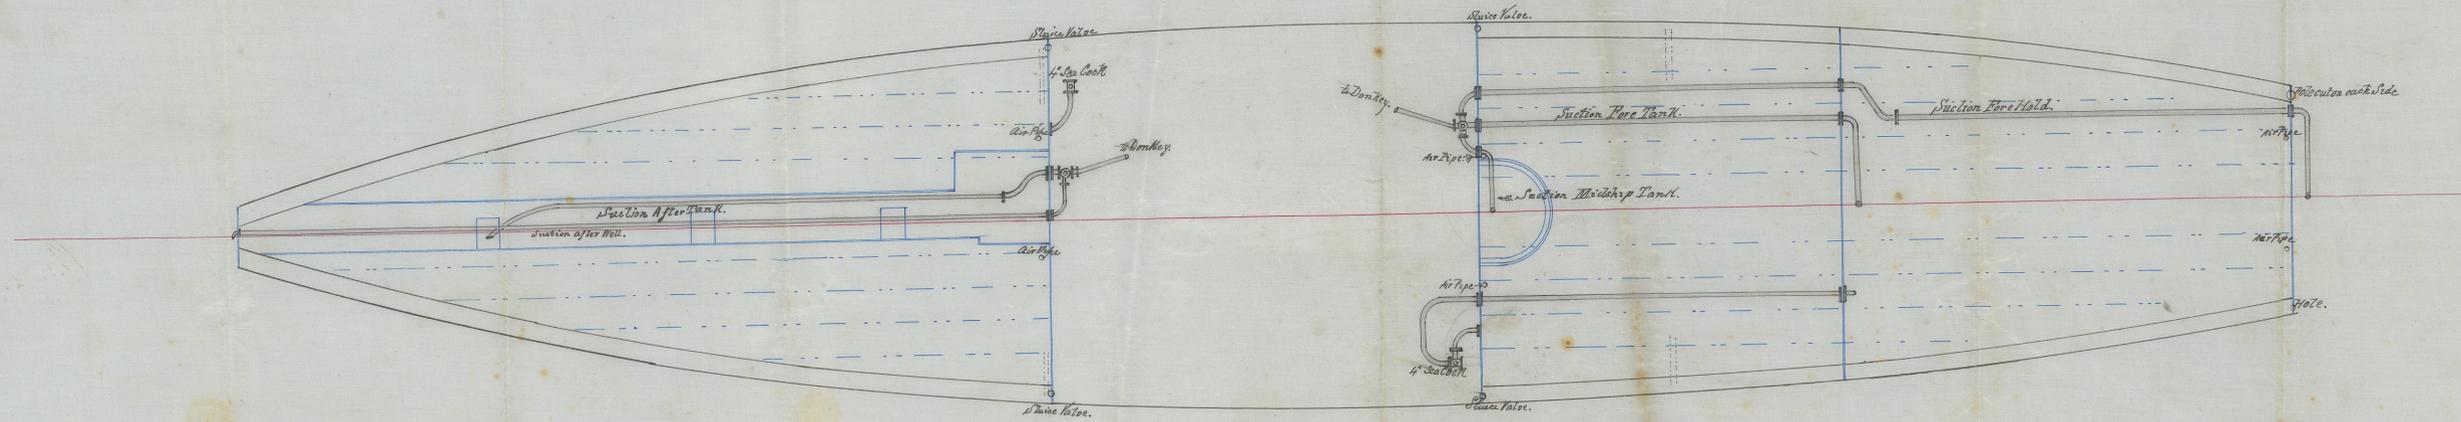

Ms. 28/4-77

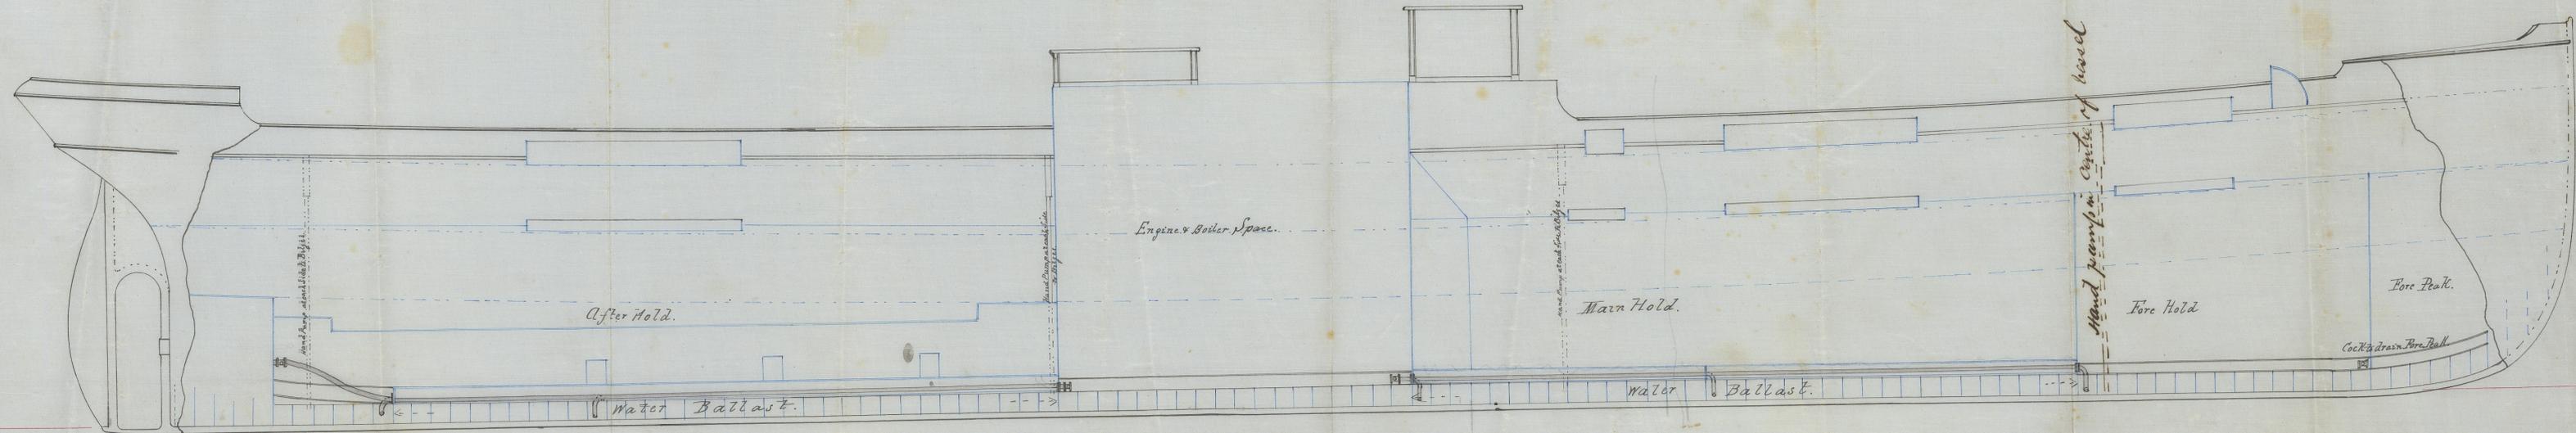

1R0520 - 0144

