


Oct. 6th 1846

Recd 18/10/76 - 246

Scale $\frac{1}{2}'' = 1 \text{ Foot}$

— Class 100 A Ilyods —

See Sunder Land Surveyors' Letter 19/10/76
Recd 20/10/76 & 28/10/76

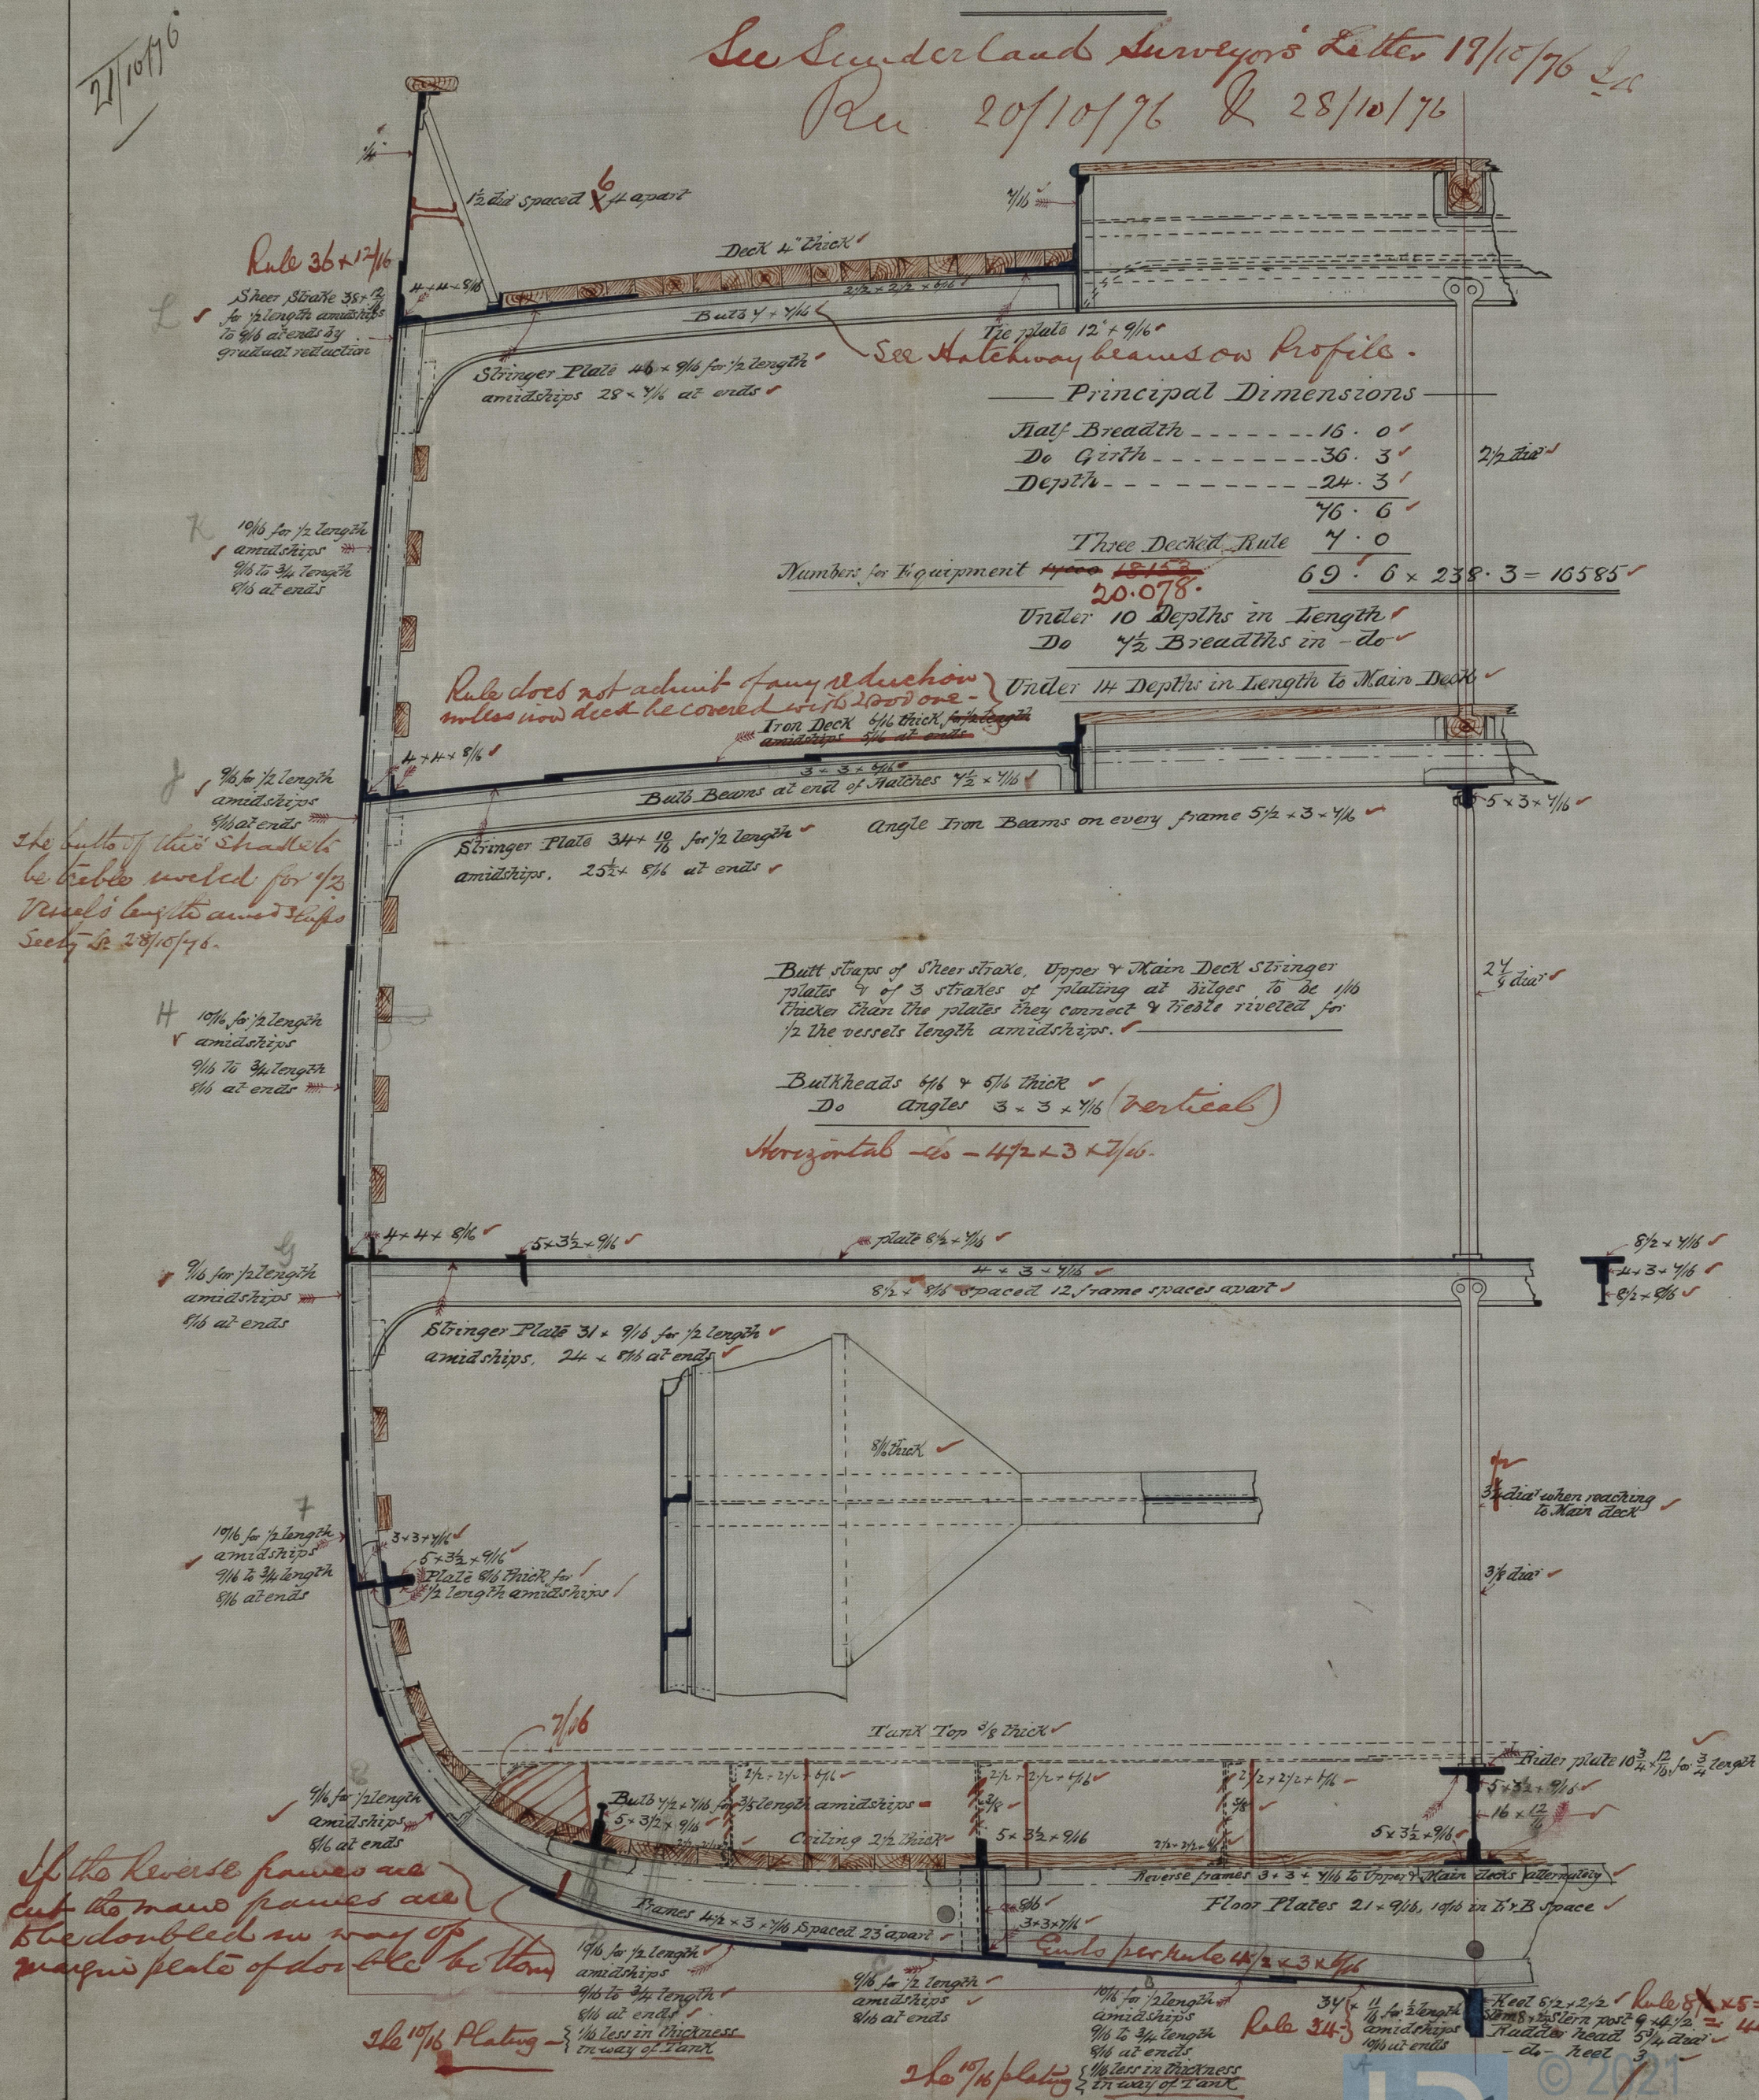

Compare two sections and