

S.S. "Britannia"
Dundee Rept No 4056

June 16th 1876

Rec'd 21.6.76
Det

S.S. No 79.

MID-SECTION

SCALE $\frac{3}{4}$ IN = 1 FT

Traced by A.B.B.
Composed by J.P. & A.B.B.

Per 23/4/76 & 18/7/76

Dimensions
Length of Keel & Tonnage... 255' 0"
Breadth Moulded... 29' 6"
Depth... 17' 8"
in Hold (to Top of Floor) 16' 10"


To Class 100A.

Half Breadth... 14.75
Girth... 28.35
Whole Depth... 18.30

13.86 Depth to length
8.6 Breadth

Length... 253.66×61.4
 61.4
 101464
 25366
 152196
 $15574.724 = 2^{nd} N^o$
 1557.472
 $17132.196 = Equipment N^o$

Single Angle Irons under the Cabin 5" x 5" x $\frac{1}{16}$ " to be in accordance with the Rules.

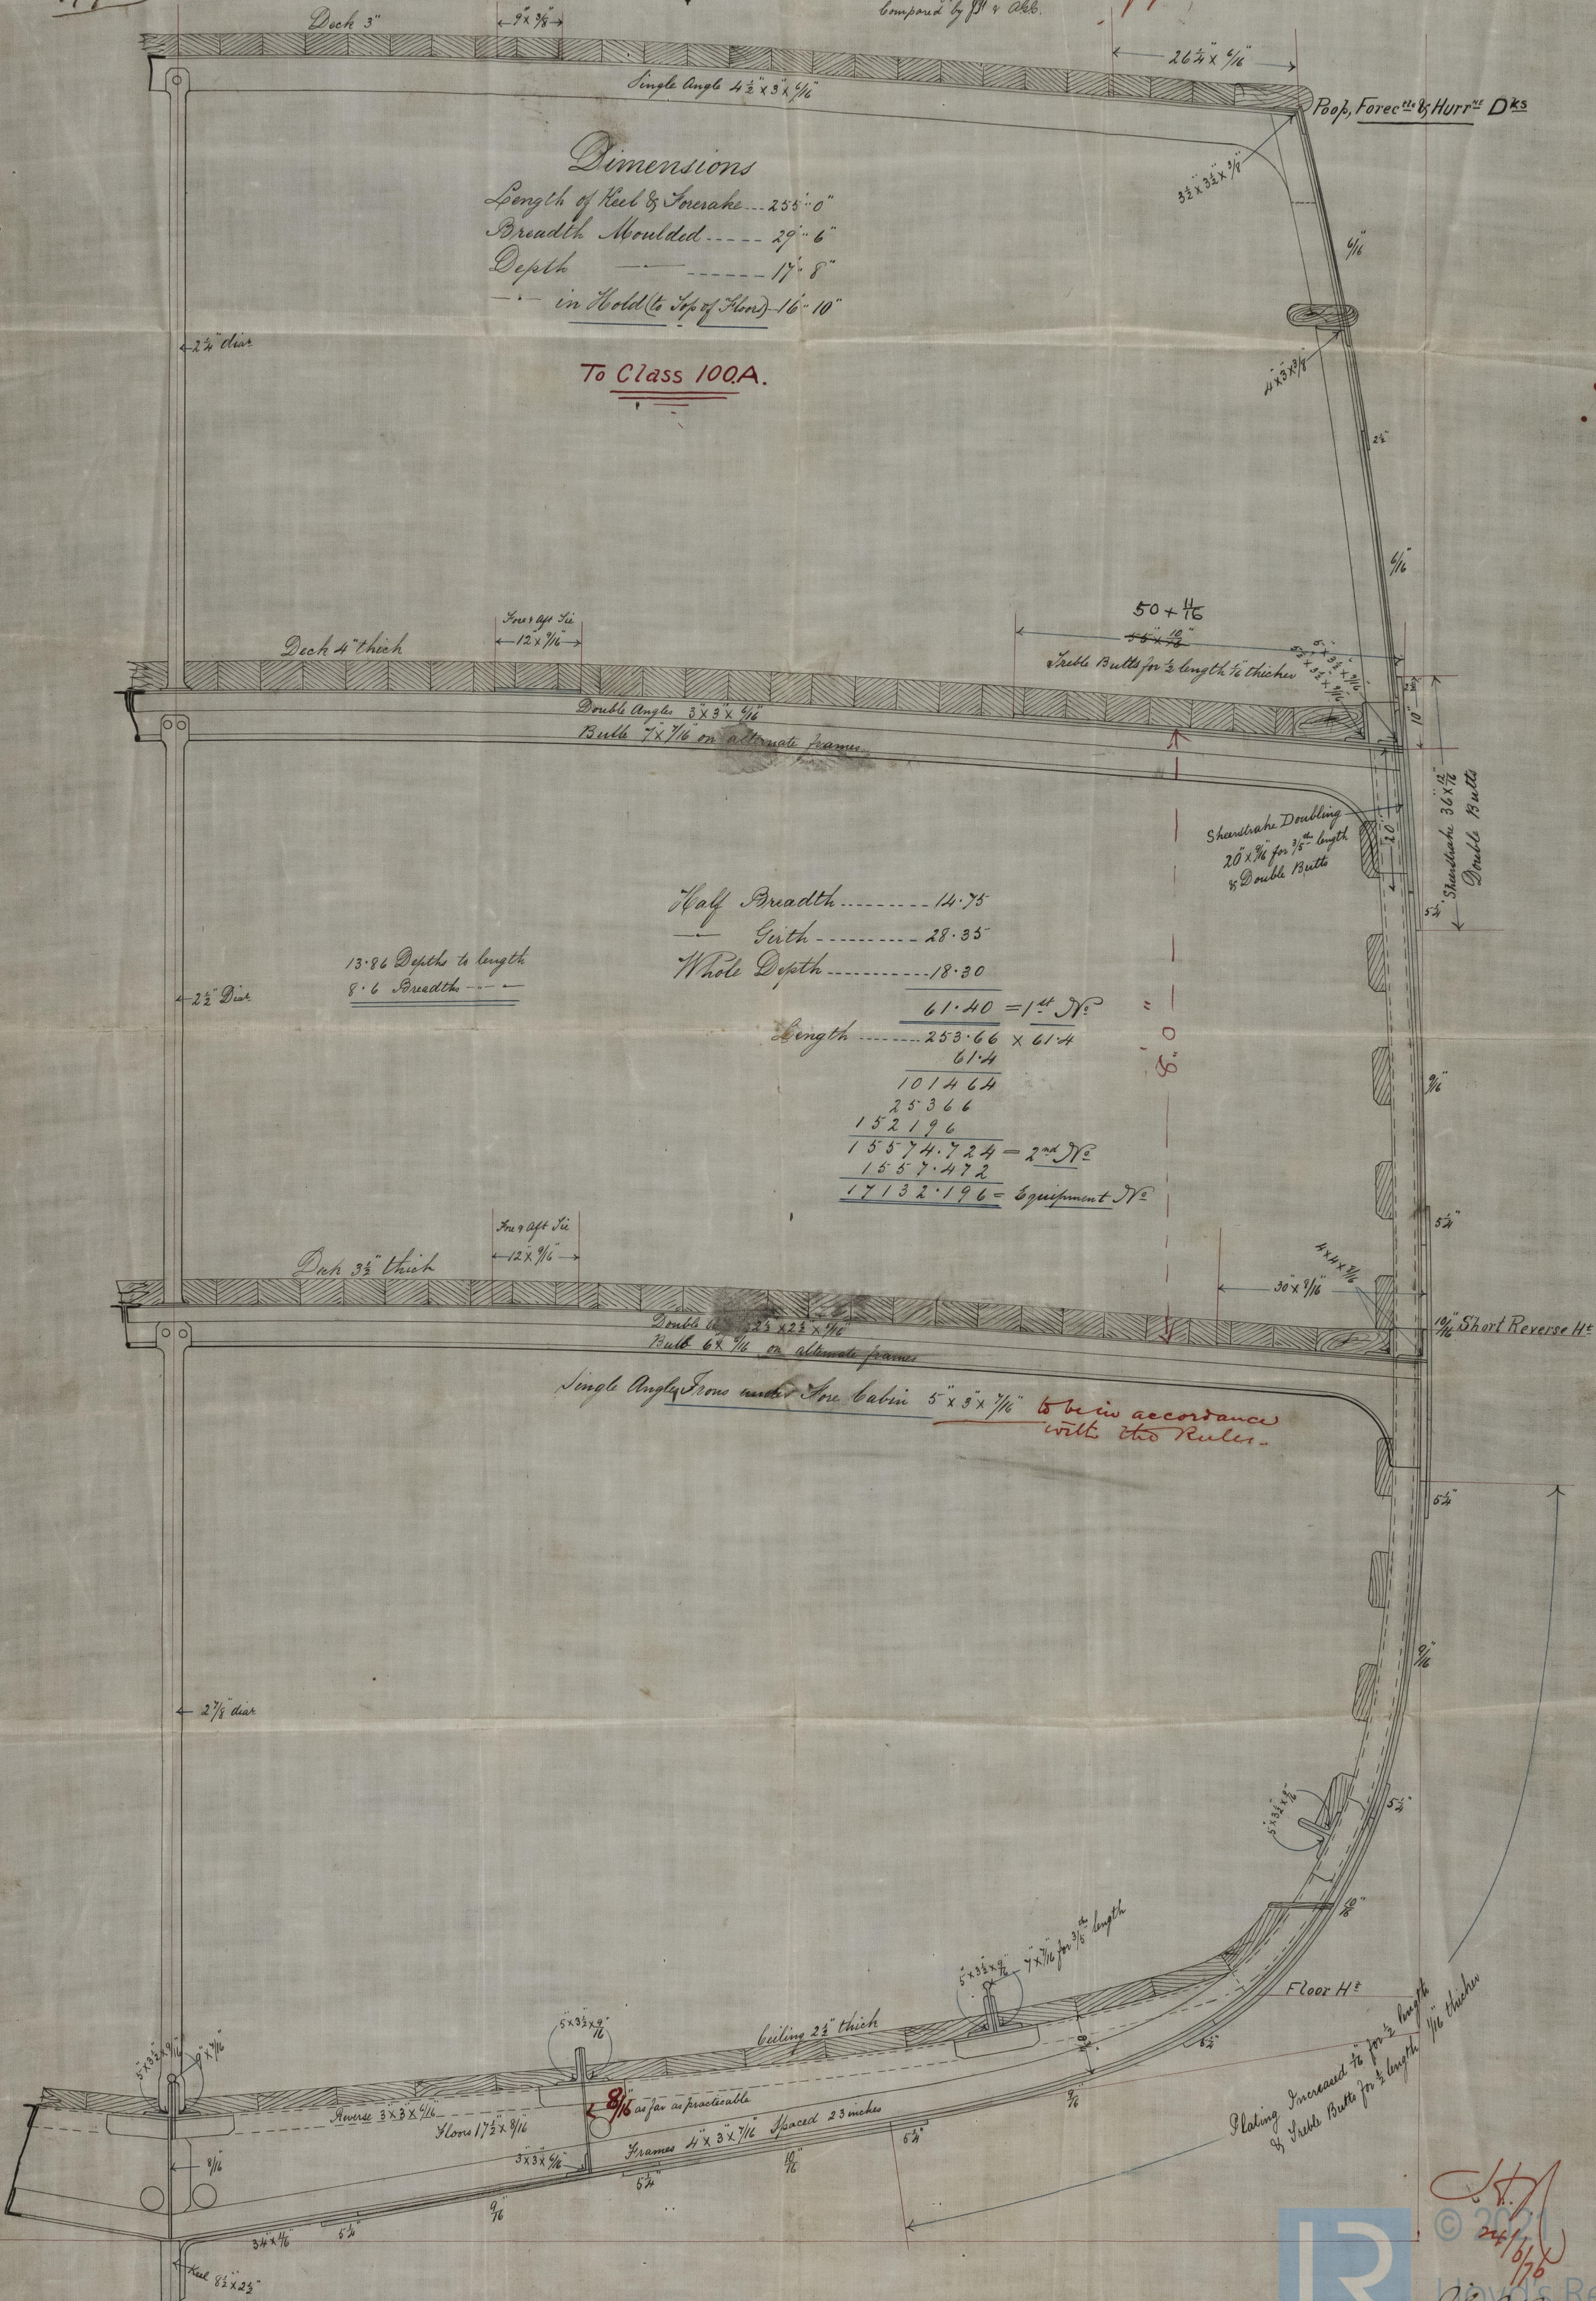

IRONS20-0179