24/6/76
24/7/76

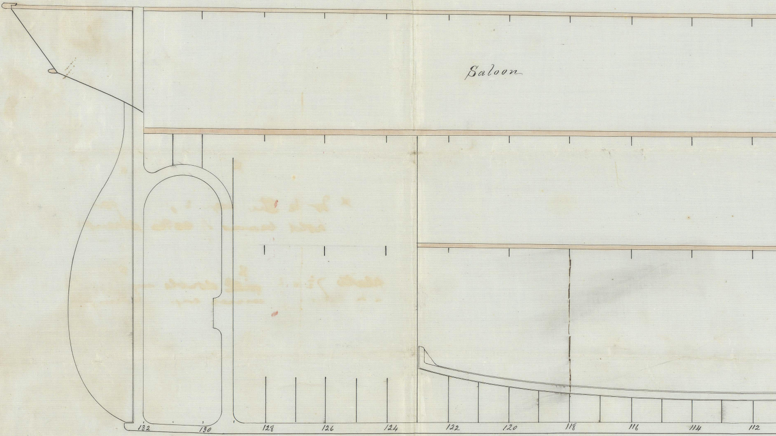
Saloon
132
130
128
126
124
122
120
118
116
114
112

S. S. "Britannia"

Dundee Rept. No. 4056.

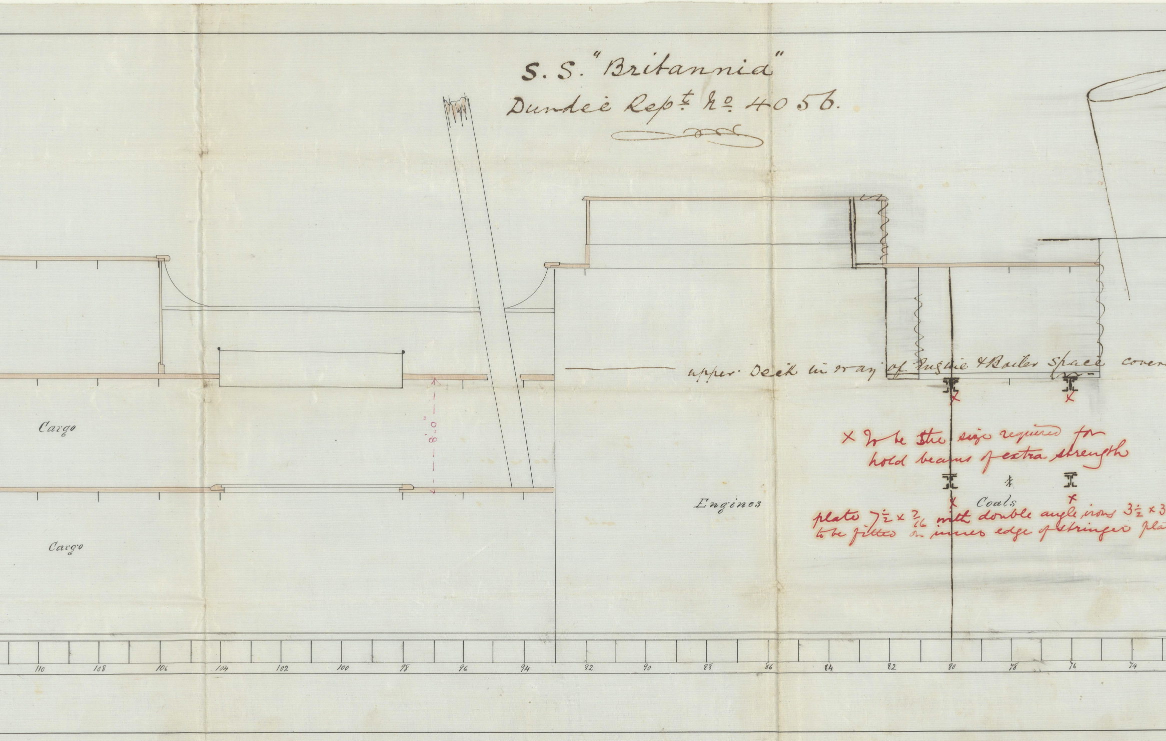

upper Deck in way of Engine & Boiler space cover

× To be the size required for hold beams of extra strength

plate 7½ × 7/16 with double angle irons 3½ × 3
to be fitted on inner edge of stringer pla

Cargo
8'0"
Cargo
Engines
Coals
110
108
106
104
102
100
98
96
94
92
90
88
86
84
82
80
78
76
74

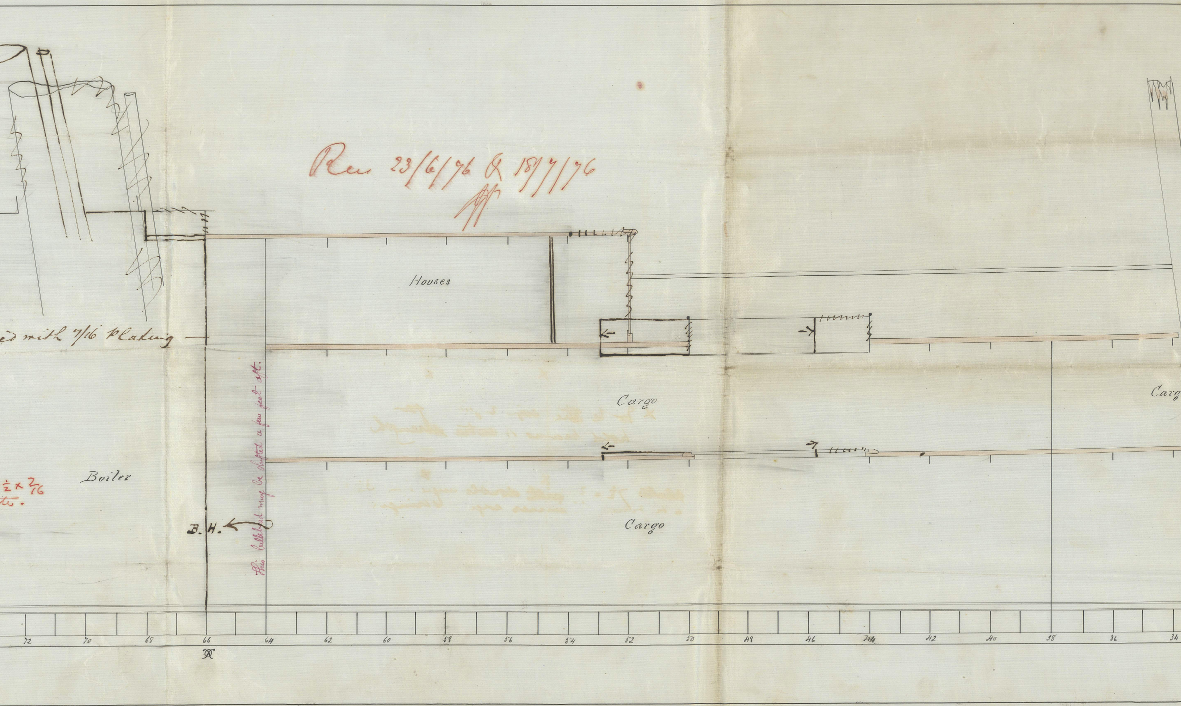
ed with 7/16 Plating
Houses
Cargo
Cargo
Carg
Boiler
½ × 2/16
te.
B. H.
72
70
68
66
64
62
60
58
56
54
52
50
48
46
44
42
40
38
36
34

Rev 23/6/76 & 18/7/76

This bulkhead may be shifted a few feet aft.

Recd 21/6/76
T.A.

— Longitudinal Section. —

— "S.S." No 79. —

SCALE ¼ IN = 1 FOOT.

June 16th 1876

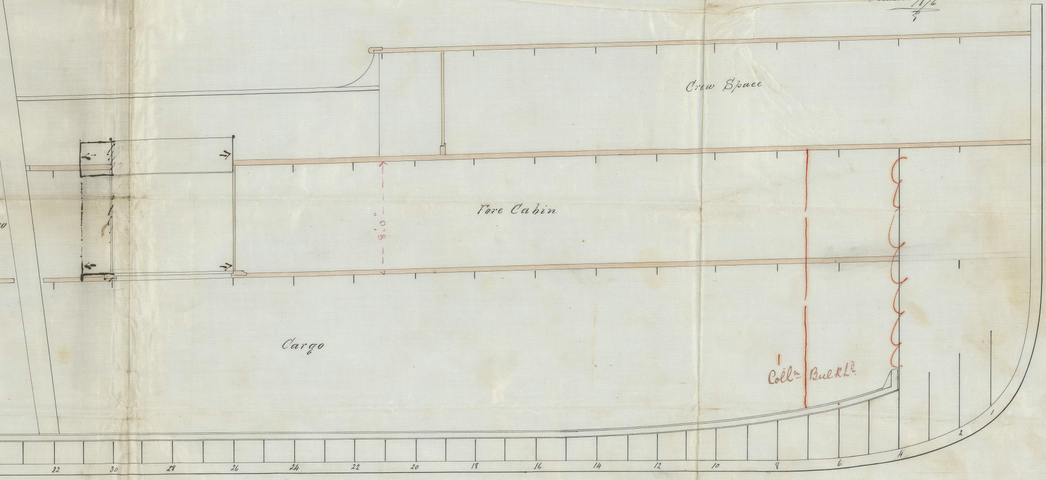
Crew Space
Fore Cabin
8'0"
Cargo
Colln Bulkd
10
32
30
28
26
24
22
20
18
16
14
12
10
8
6
4
2
1

J.H.S. 19. May/77.

24/6/76

IRONS20-0181

© 2021 Lloyd's Register Foundation