

12/12/76

Butts of
* Top side plating, Sheerstrake and
Strake below same to be triple
Riveted and Shaped 1/16 inches
in way of Break Red D


Rec 11/12/76
Q 20/12/76

"*Ser Ferndale*" Report No 11660

May 1877
A. Pauting Beams
will be fitted here
on completion of
present Voyage
See Surveyor's Letter

Revised
1876

S.S. No 225
Scale 1/8" = 1 foot

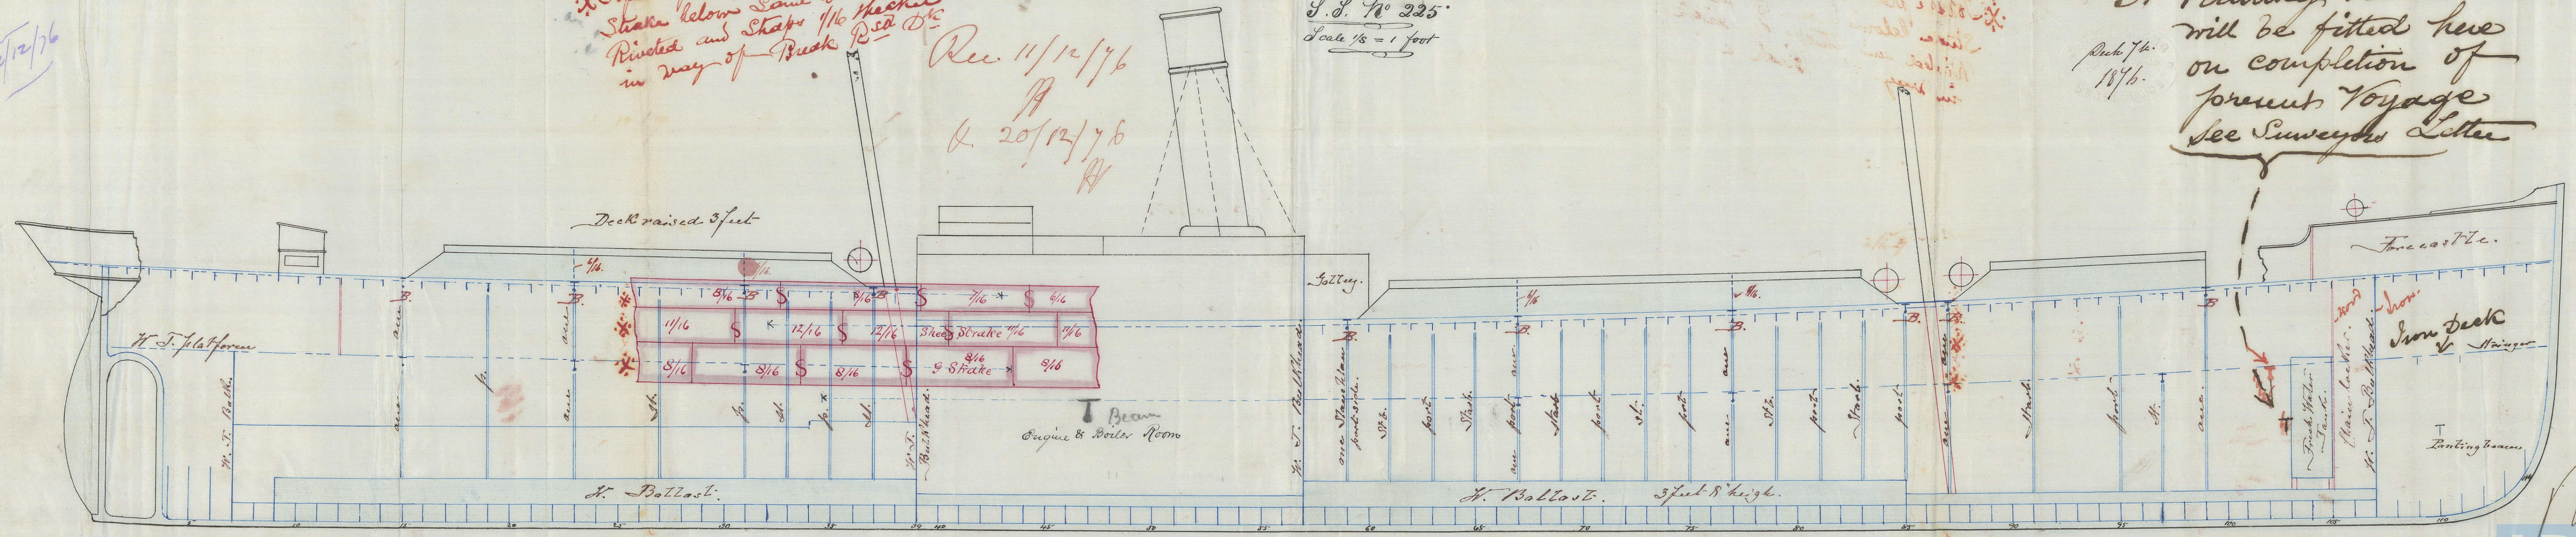

Mund R 22 18 22 ft depth Hold; Floor B = Spaced 8 frames apart
with angle 4 1/2 x 3 1/2 x 7/16 on inner edge of Stringer plate See Section 14 and 45.

All throughgoing Beams in Upper deck marked: B.
16 1/2 17 ft depth: Hold Beams Spaced 10 frames apart
with angle 4 1/2 x 3 1/2 x 7/16 on inner edge of Stringer plate
if extending along See Section 14.

IRON 521 - 0003