
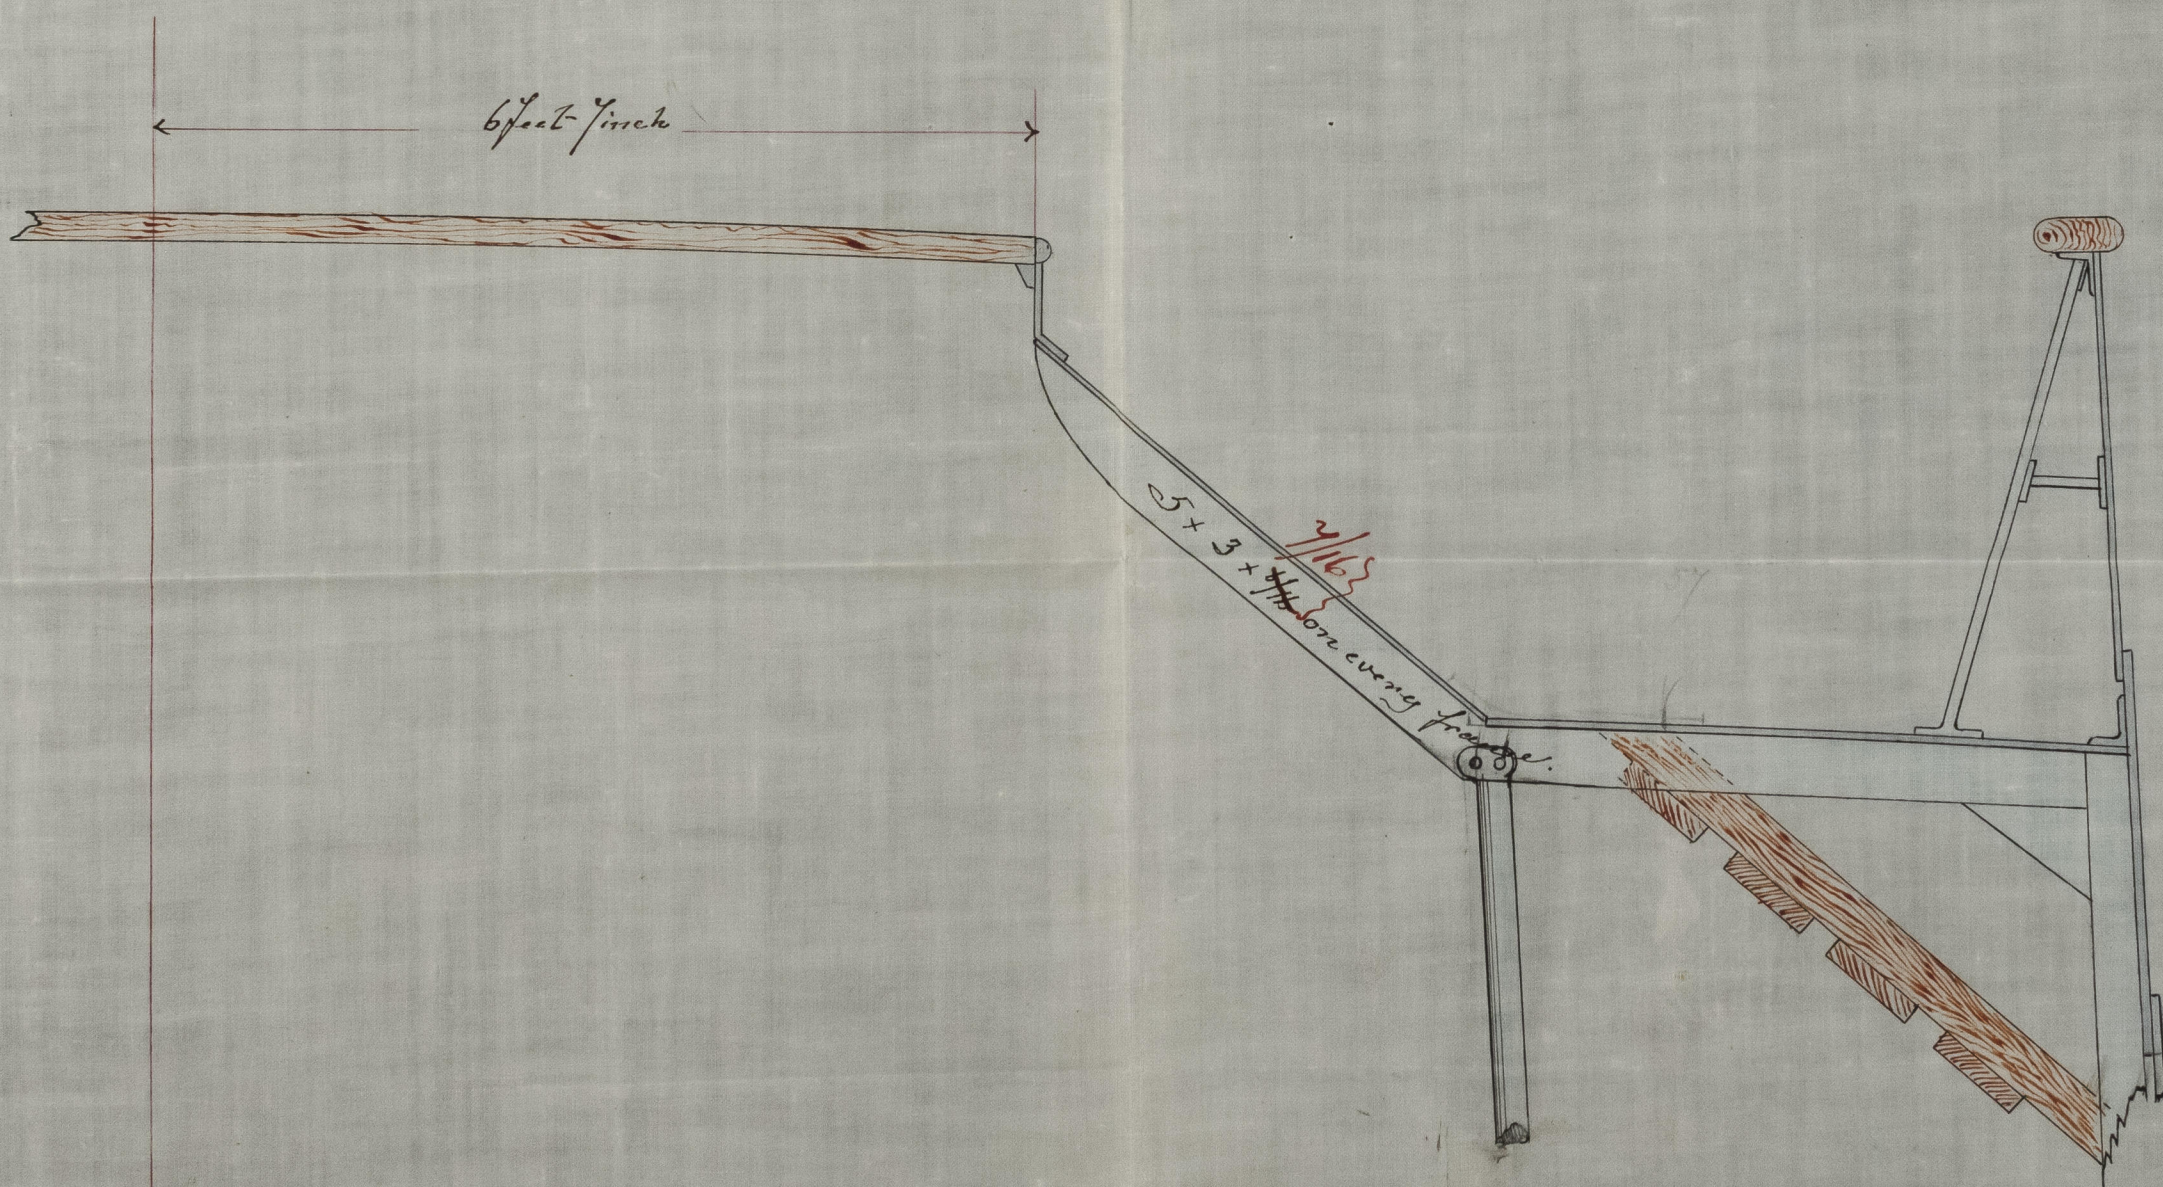


S.S. No 225 ✓
Scale $\frac{3}{4}$ " = 1 foot. ✓

Decr 7th
1876

Rec 11/12/76 & 20/12/76
HA

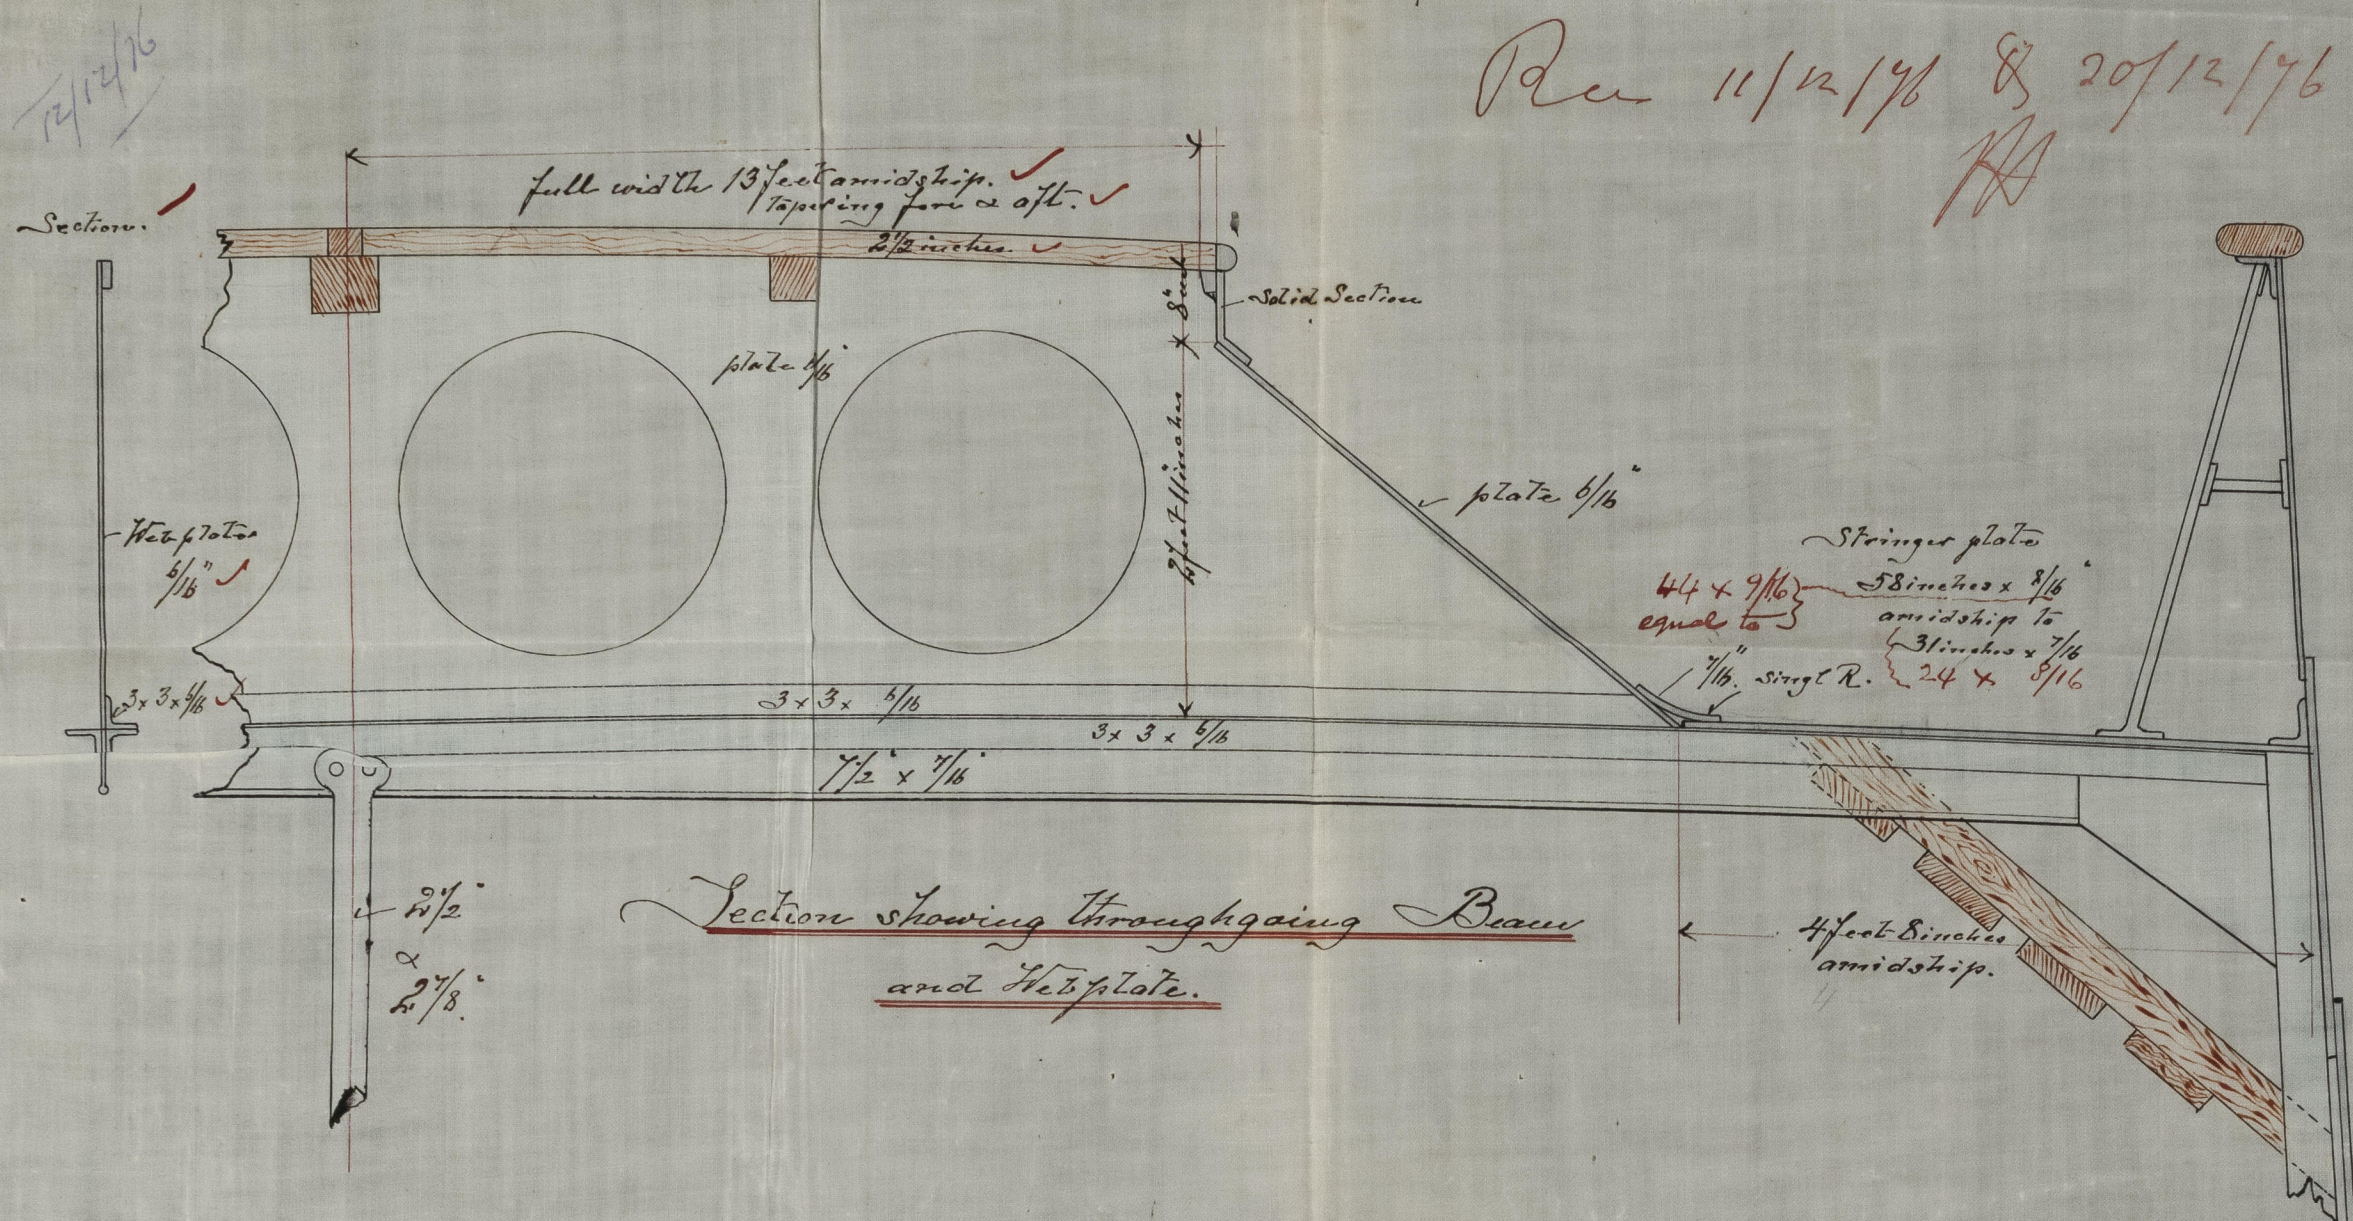

1876
12/11/76

Dept for d Gord

Sunder Land

Decr 7th 1876

© 2021

Lloyd's Register
Foundation