

OF  $N^{\frac{0}{u}}$

26


Rev 2/11/76

Length perpendiculars	205.6
Breadth moulded	32.6
depth top of iron floors	19.9

To Class 100 at Leeds & 20 years Liverpool

Half Girdle	32.91	✓
Depth Inlet	21.79	✓
Half Broadish Inlet	16.25	✓
	70.95	✓
	<u>200.74</u>	✓
	35478	✓
	49665	✓
	1419000	✓
	142482125	✓

6 Decid. and  
9 Sept. in length  
Class 100 A

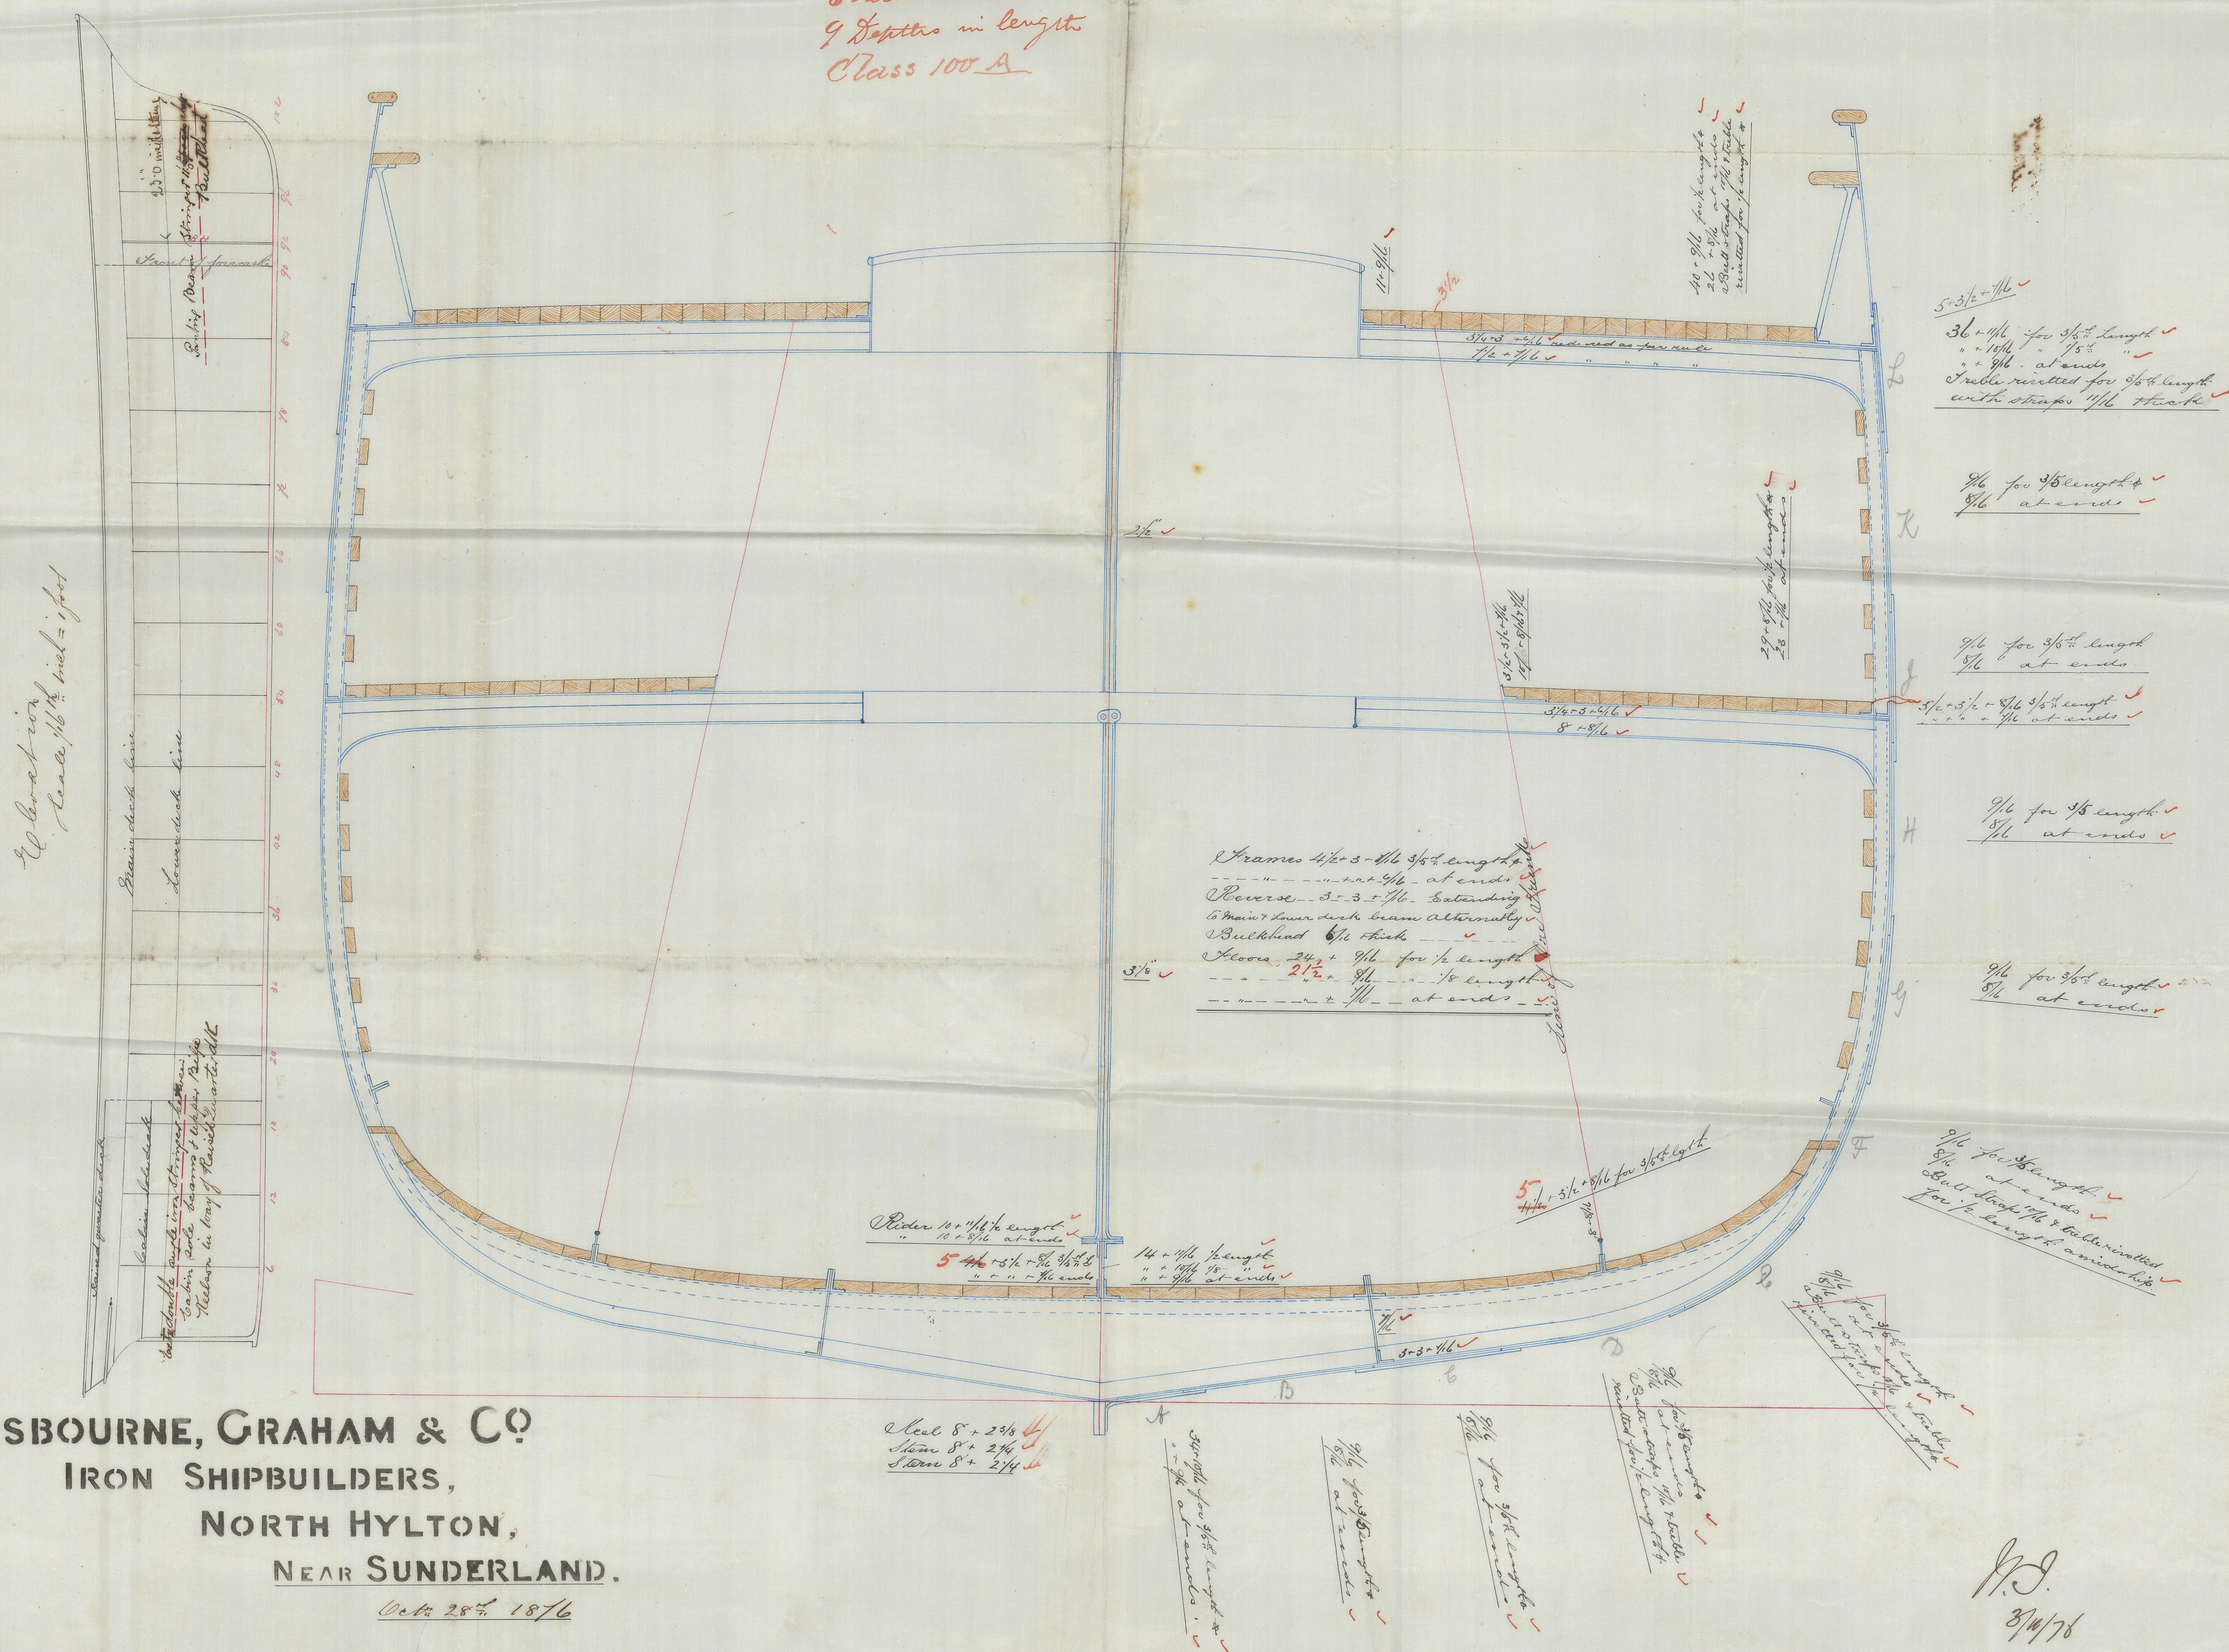

**OSBOURNE, GRAHAM & CO**  
**IRON SHIPBUILDERS,**  
**NORTH HYLTON,**  
**NEAR SUNDERLAND.**

Oct 28<sup>th</sup> 1876

H.S.  
3/4/78