

3/10/76

Ship Tilkeurst

Plasm Report No 4447

Ship No 201
Class 100A at Lloyd's.
Dimensions
Length B.O. 230'-9"
Breadth moulded 38'-9 1/2"
Depth do 25'-5 1/2"
Depth of Hold 23'-0"


ARCHD Mc MILLAN & SON.

SHIPBUILDERS.

DUMBARTON.

SCALE 1/2 INCH TO A FOOT.

27th Oct 1876

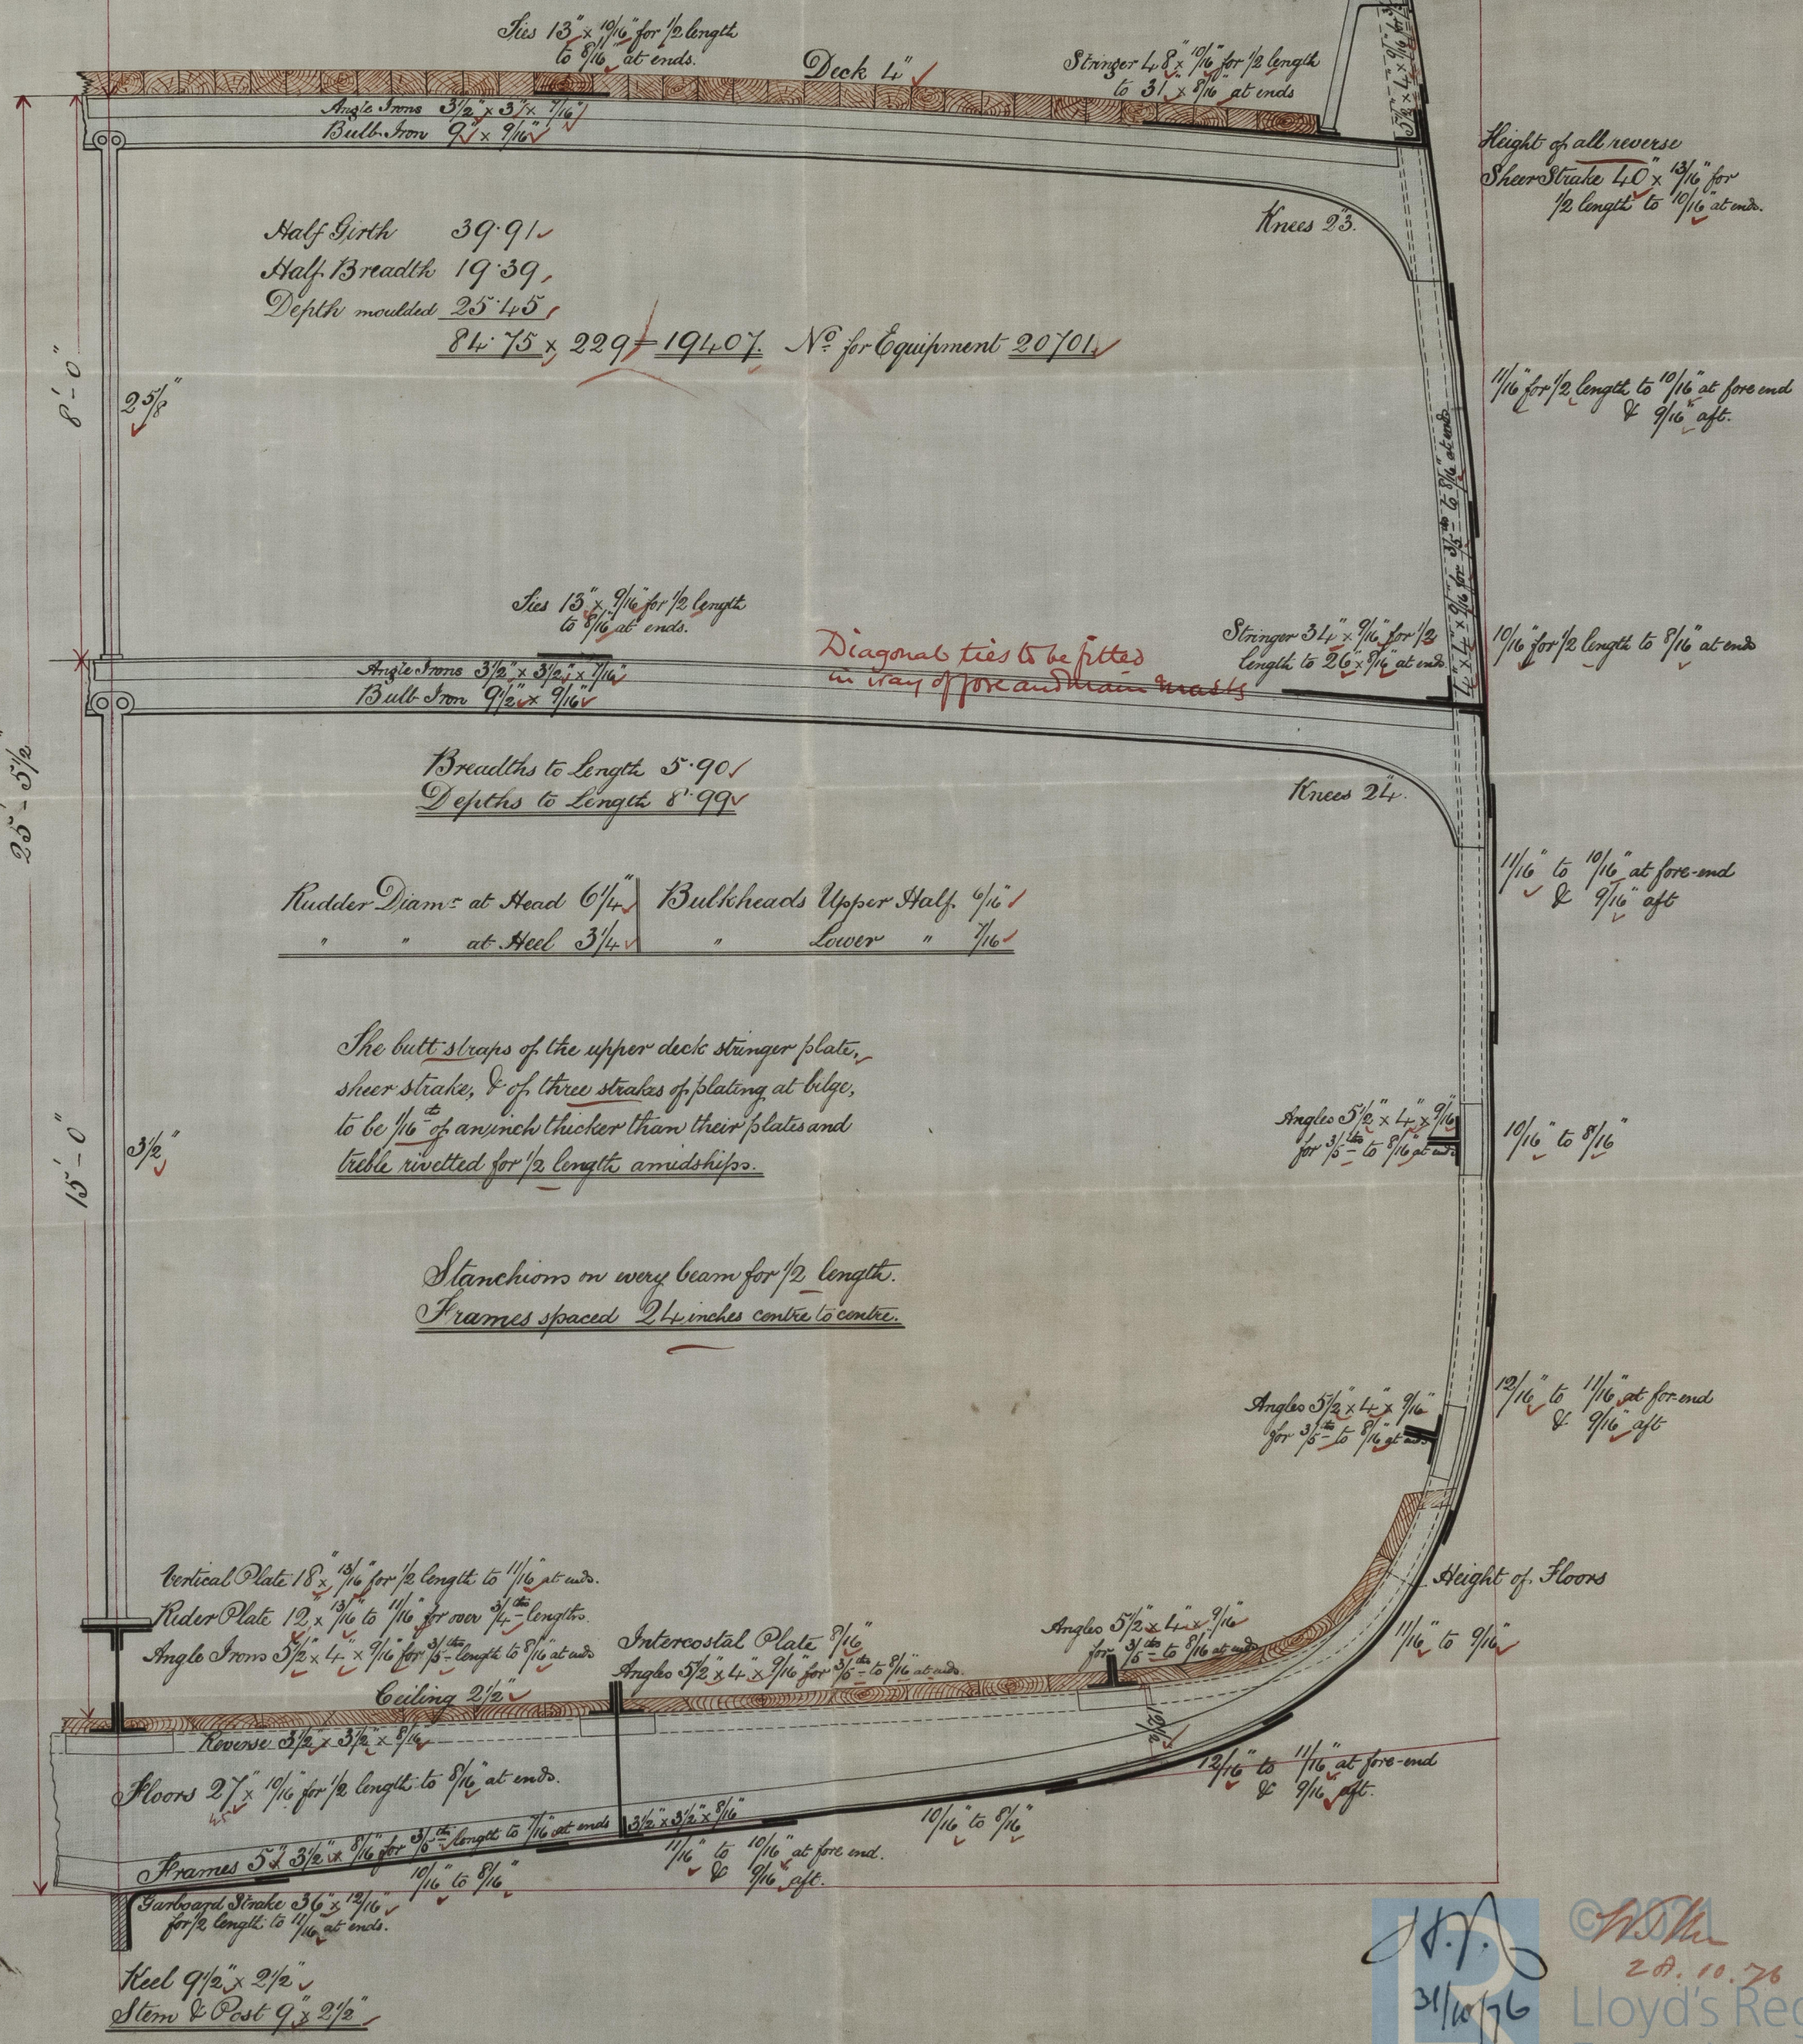

Half Girth 39'9 1/2"
Half Breadth 19'39"
Depth moulded 25'4 5/8"

84'7 1/2" x 229' = 19407. No for Equipment 20701

Rudder Diam: at Head 6 1/4" Bulkheads Upper Half 7/16"
" " at Heel 3 1/4" " Lower " 7/16"

The butt straps of the upper deck stringer plate, sheer strake, & of three strakes of plating at bilge, to be 1/16" of an inch thicker than their plates and treble rivetted for 1/2 length amidships.

Stanchions on every beam for 1/2 length. Frames spaced 24 inches centre to centre.

Vertical Plate 18 x 1 3/16 for 1/2 length to 1 1/16 at end.
Rider Plate 12 x 1 1/16 to 1 1/16 for over 1/4 length.
Angle Iron 3 1/2 x 4 x 9/16 for 1/2 length to 8/16 at end.
Cauling 2 1/2"
Reverse 3 1/2 x 3 1/2 x 9/16
Floors 2 1/2 x 1 1/16 for 1/2 length to 8/16 at end.
Frames 5 x 3 1/2 x 8/16 for 1/2 length to 1 1/16 at end.
Bulkhead Strake 3 1/2 x 1 1/16 for 1/2 length to 1 1/16 at end.
Keel 9 1/2 x 2 1/2"
Stern Post 9 x 2 1/2"

J.H.A.
3/10/76

Lloyd's Register Foundation

IRON 521-0039