

Iron Ship 'Caesarea' Report No 11640

S. No 84

Rec 15/1/77


origin Lower Topsail yd ✓  
3.10 dia x 13 dia ✓

Plating 4/16 . 3/16 . 2/16 ✓

Seams single rivetted ✓


Laps treble ✓

double 2 centre for 3.0 x 4/16 ✓

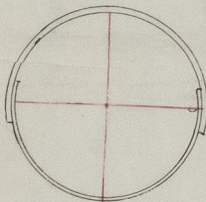

Ex-2 J.K.

30/12/76

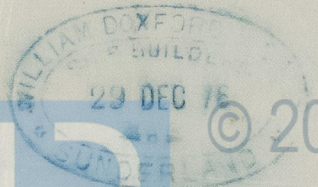

© 2021

Lloyd's Register  
Foundation

IRON 321-0048