

Iron Ship 'Caesarea' Report No 11.670


S. N° 87



Sections of masts & yards.

Scale 1" = 1 foot.


Rev 1571177

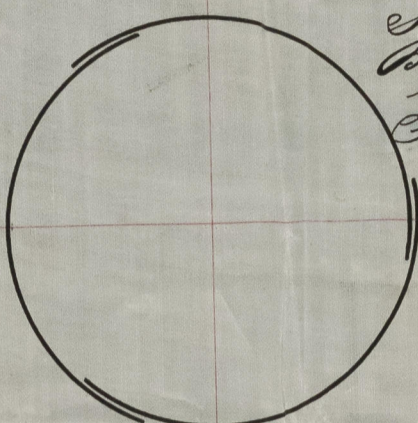

Fore Mast 80.0 feet - 28 Main.

- Seams double rivetted ✓
- Butts below partners double ✓
- remainder treble rivetted ✓
- Straps 1/16 thicker than plates. ✓
- Plating 7/16 & 9/16 ✓
- " Doubled in way of wedging ✓
- for 10.0 with 7/16 ✓


Chucks 9/16  
" - angle 4 1/2 x 3 x 9/16

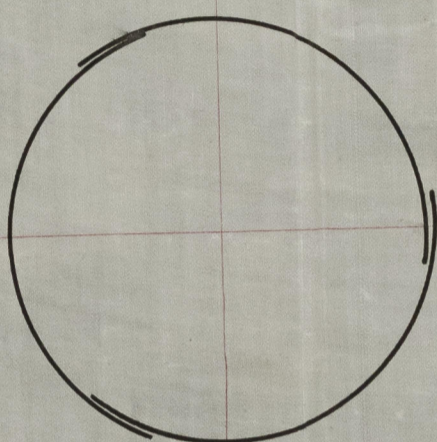

Main Mast 81.6 feet - 29 Main.

- Seams double rivetted ✓
- Butts below partners double ✓
- remainder treble rivetted ✓
- Straps 1/16 thicker than plates. ✓
- Plating 7/16 & 9/16 ✓
- " Doubled in way of wedging ✓
- for 10.0 with 7/16 ✓


Chucks 9/16  
" - angle 5 x 3 1/2 x 9/16

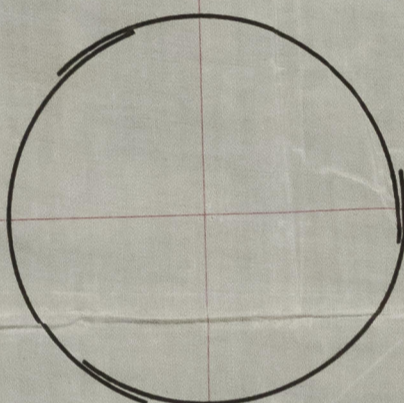

Mizen Mast 76.0 feet - 27 Main.


- Seams double rivetted ✓
- Butts below partners double ✓
- remainder treble rivetted ✓
- Straps 1/16 thicker than plates ✓
- Plating 7/16 & 9/16 ✓
- " Doubled for 10.0 in way of wedging ✓
- with 7/16 ✓

Chucks 9/16  
" - angle 4 1/2 x 3 x 9/16

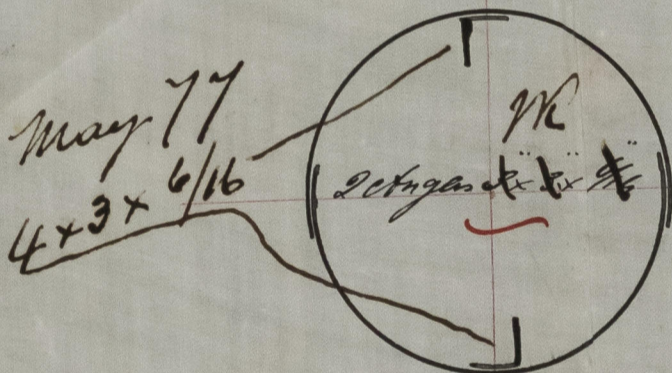


Bowprit 19.6 outside - 24 1/2 Main.  
87.6 feet.

- Seams double rivetted ✓
- Butts inside of wedging double ✓
- remainder treble rivetted ✓
- Straps 1/16 thicker than plates. ✓
- Plating 9/16 & 7/16 ✓
- " Doubled for 6.0 at wedging ✓
- with 9/16. ✓

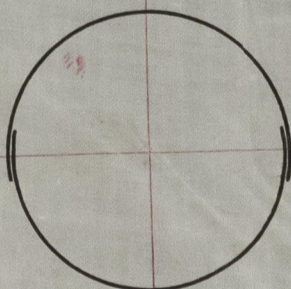


Fore & Main Lower Yards.  
18.0 feet - 19 Main.

- Plating 7/16 & 3/16, 1/2 & 3/16 ✓
- Seams single rivetted ✓
- Laps treble rivetted ✓
- Doubled for 6.0 at centre. ✓

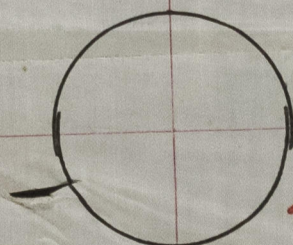

Fore & Main Lower Topsail Yards.  
66.0 feet 16 Main.

- Plating 7/16, 1/2 & 3/16 ✓
- Seams single rivetted ✓
- Laps treble, ~~double~~ at ends ✓
- Doubled for 5.0 at centre. ✓

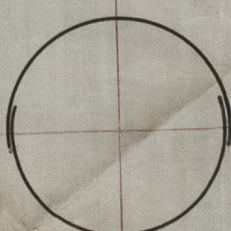

Fore & Main Upper Topsail Yards.  
& Mizen Lower Yards.  
62.0 feet 15 Main.

- Plating 1/2, 3/16 & 9/16 ✓
- Seams single rivetted ✓
- Butts Laps treble, & double at ends. ✓
- Doubled for 5.0 at centre. ✓

84<sup>a</sup> Keen.  
19<sup>th</sup> Oct 76.



© 2021 Lloyd's Register Foundation

IRON 521 0019