Iron Ship "Caesarea" Report No. 11670.

Correct Numerals

Equipment Numeral 17390 + 1/15 = 18549.

~~17072 + 1/15 = 18210~~

Equipment

2 Bowers	32 Cwt	
1 do	27 1/4 "	
1 Stream	13 "	
1 Kedge	6 1/2 "	
1 do	3 1/4 "	
270 Fathoms	1 13/16 Chain Cable	

Midship Section No. 87 Sailing Vessel

Scale 1/2 inch = 1 Foot

Class 100 A Lloyds

Rules 1876 & 77

Dimensions as per Rule

Length	~~214.5~~ 218.5
M. Breadth	36.0
Depth top of Keel	24.34

Correct Numerals

1/2 Girth	37.25
1/2 M.B.	18.0
Depth	24.34
	79.59 (1st No
	218.5
	39795
	63672
	7959
	15918
	17390.415 2nd No

~~1/2 Girth 37.25~~
~~1/2 M.B. 18.0~~
~~Depth 24.34~~
~~79.59~~ 1st No 76 & under 80
~~214.5~~
~~39795~~
~~31836~~
~~7959~~
~~15918~~
~~17072.0055~~ 2nd No 16600 & under 18700

Rec 11/9/76 & 15/1/77

Proportions

Under ~~6~~ 7 Breadths

" 9 Depths from top of Keel

Raised Quarter dk less than 1/4 of Vessel & 3'6" high

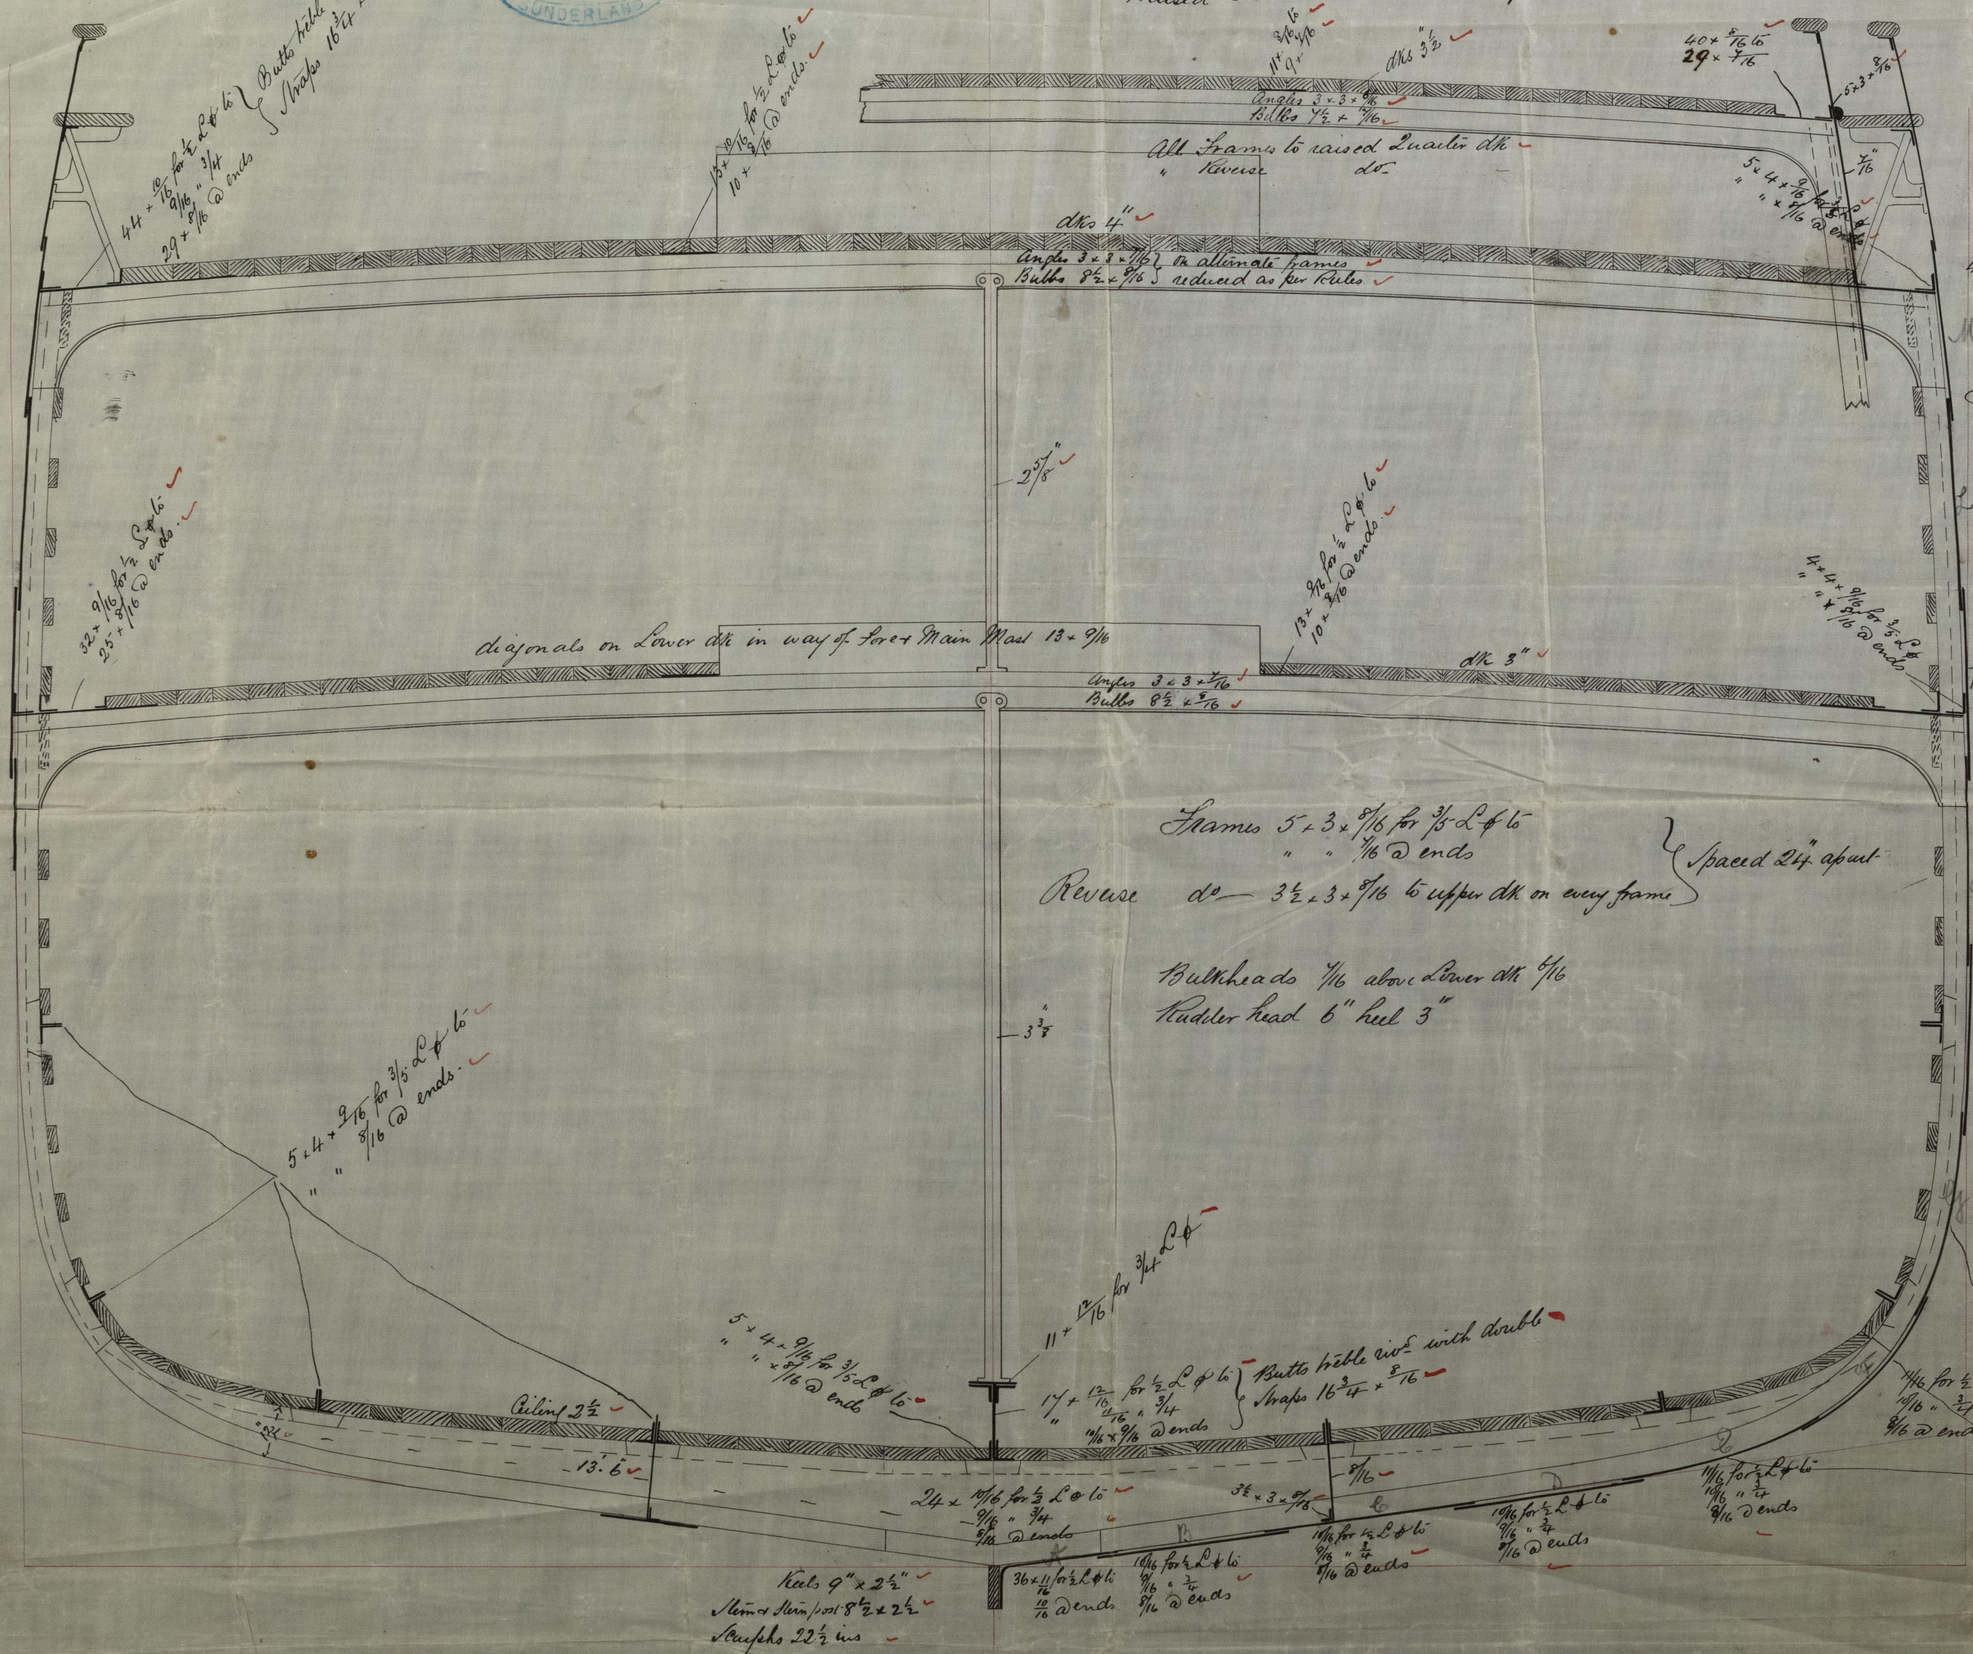

28/8/76

11/9/76

WILLIAM DOXFORD & SONS SHIP BUILDERS 23 AUG 76 SUNDERLAND

IRDIV 521-0050