


N^o 292

Rec 2/11/76
H

3/11/76

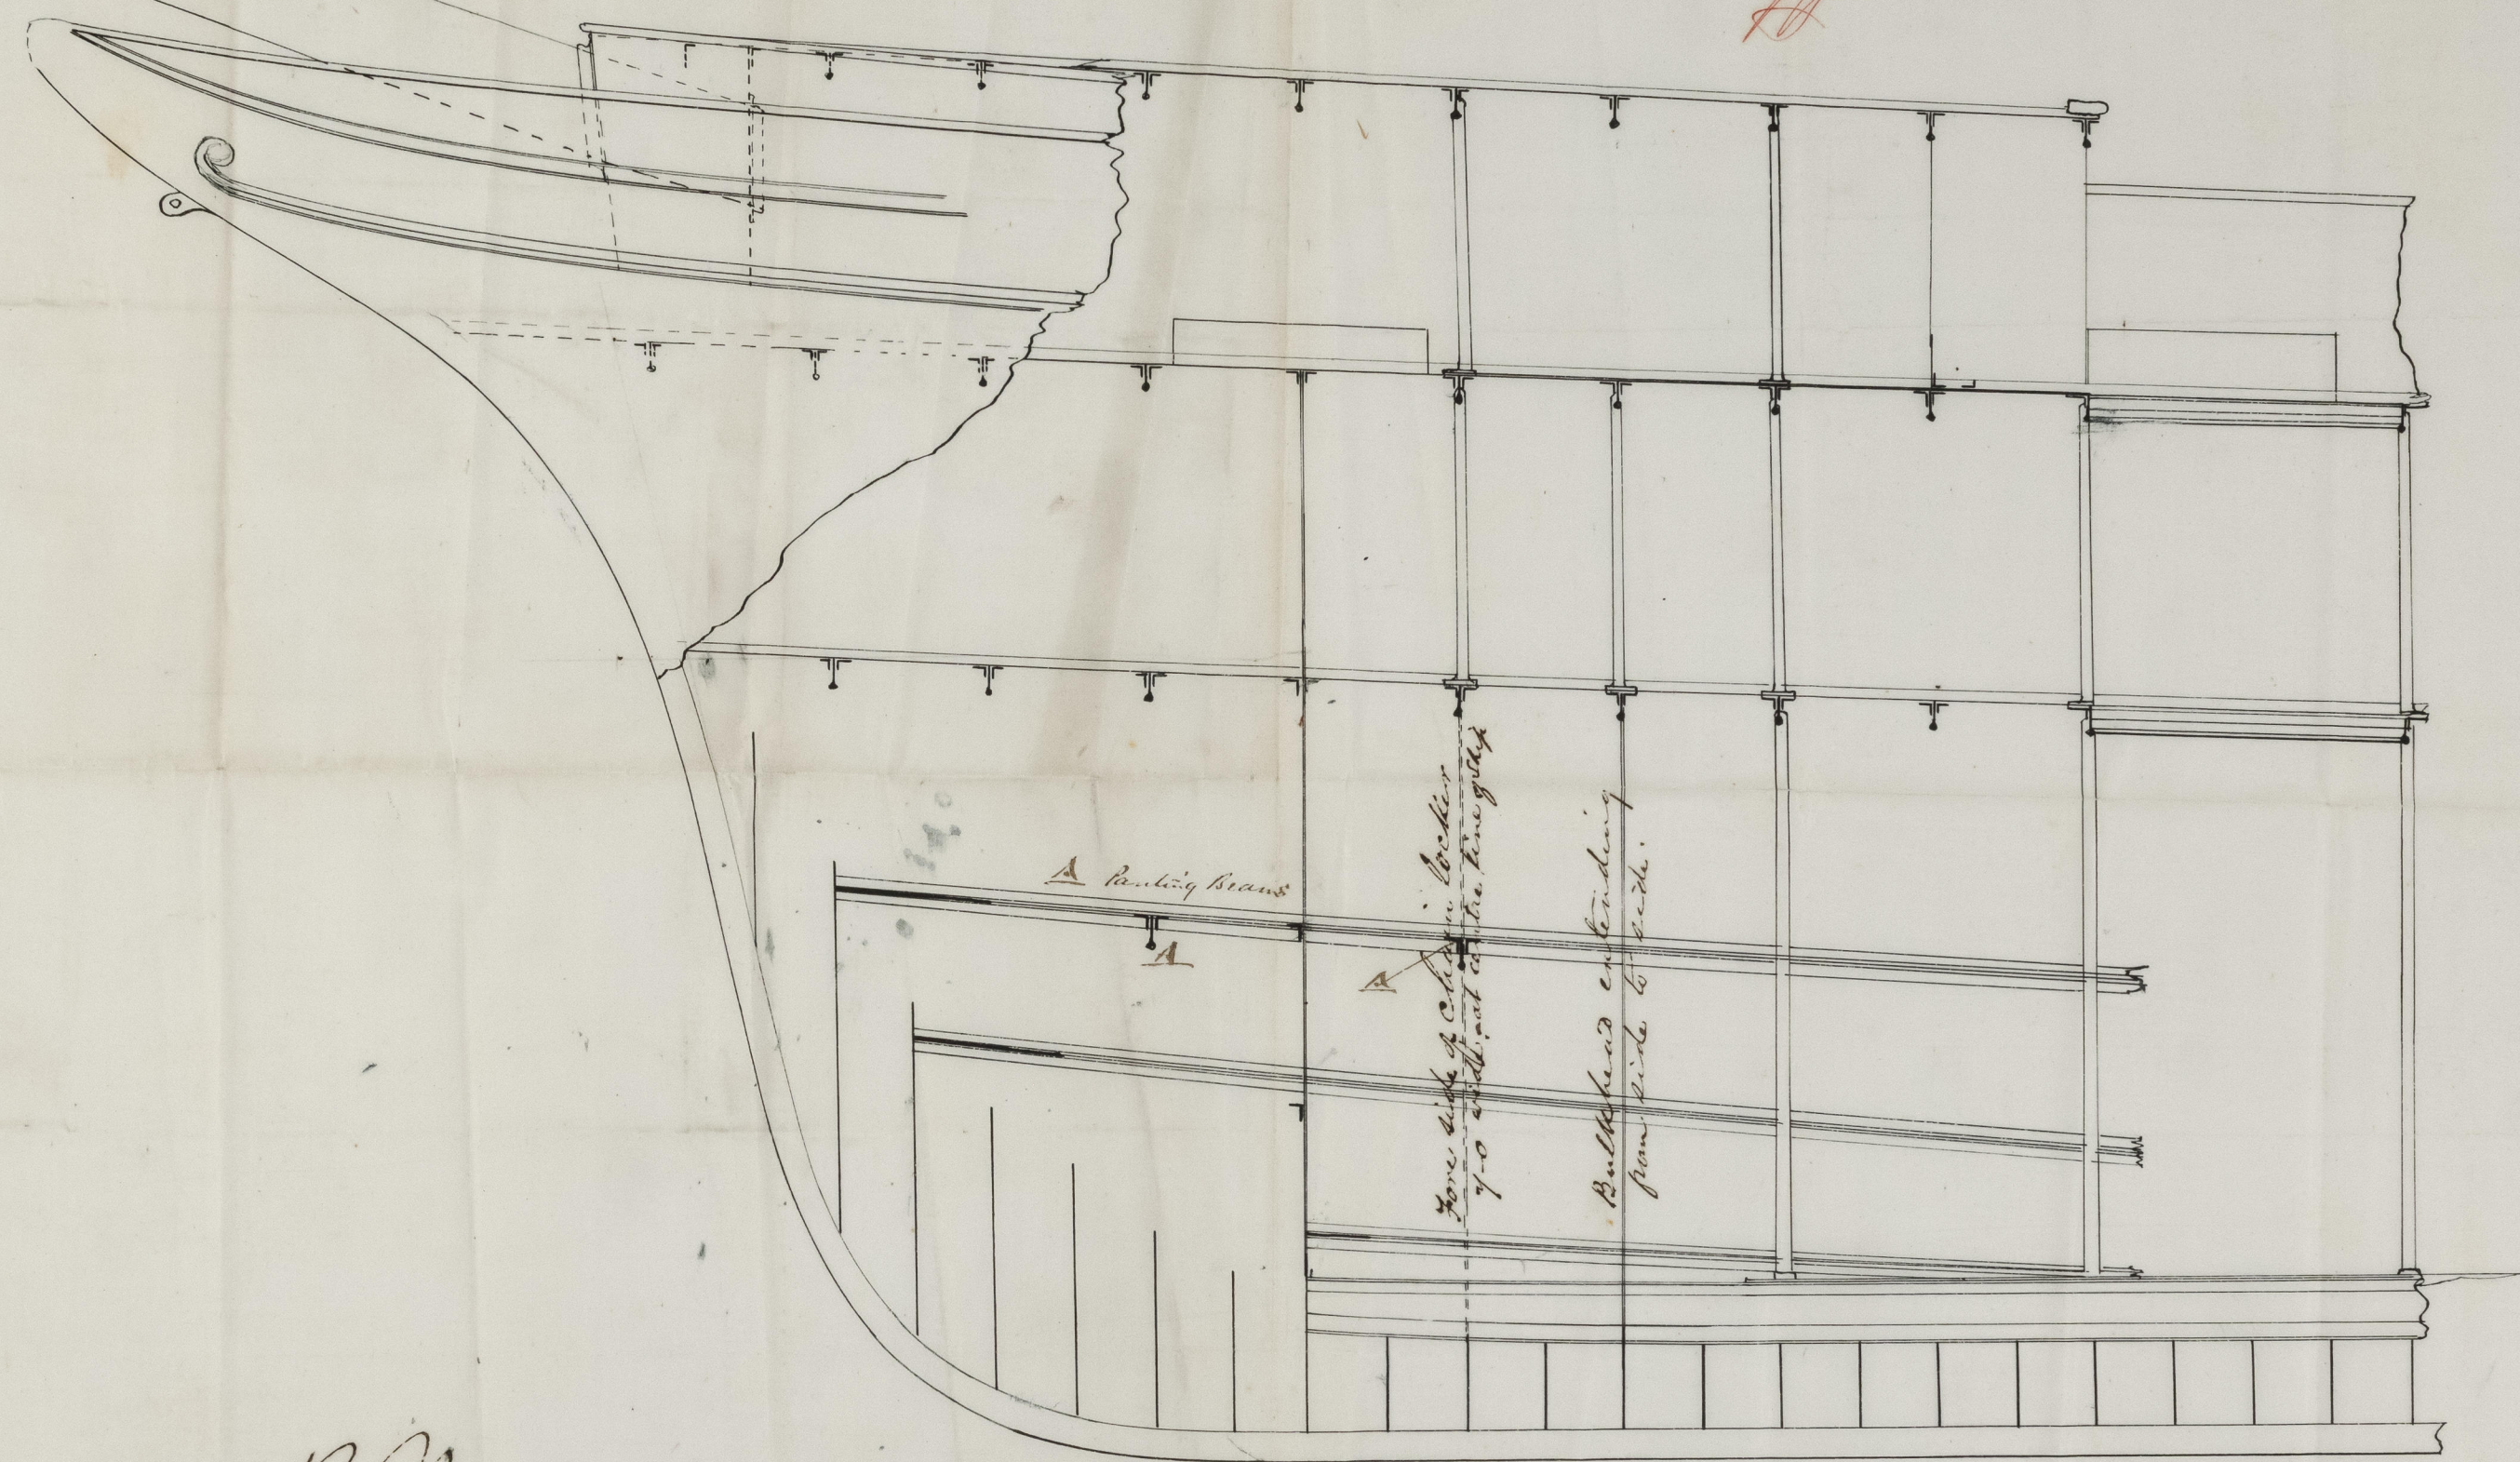

A Raking Beam

Fore side of Chain Locker
7-0 width at the fore end

Bulkhead extending
from side to side.

B.M.
3/11/76

SCALE 1/4 INCH TO A FOOT

Alexander Hall & Co
Shipbuilders

ABERDEEN

Lloyd's Register
Foundation

1200521-0057