


20/11/76

Rec 20/11/96

Breadth 6.02  
Depth 9.13

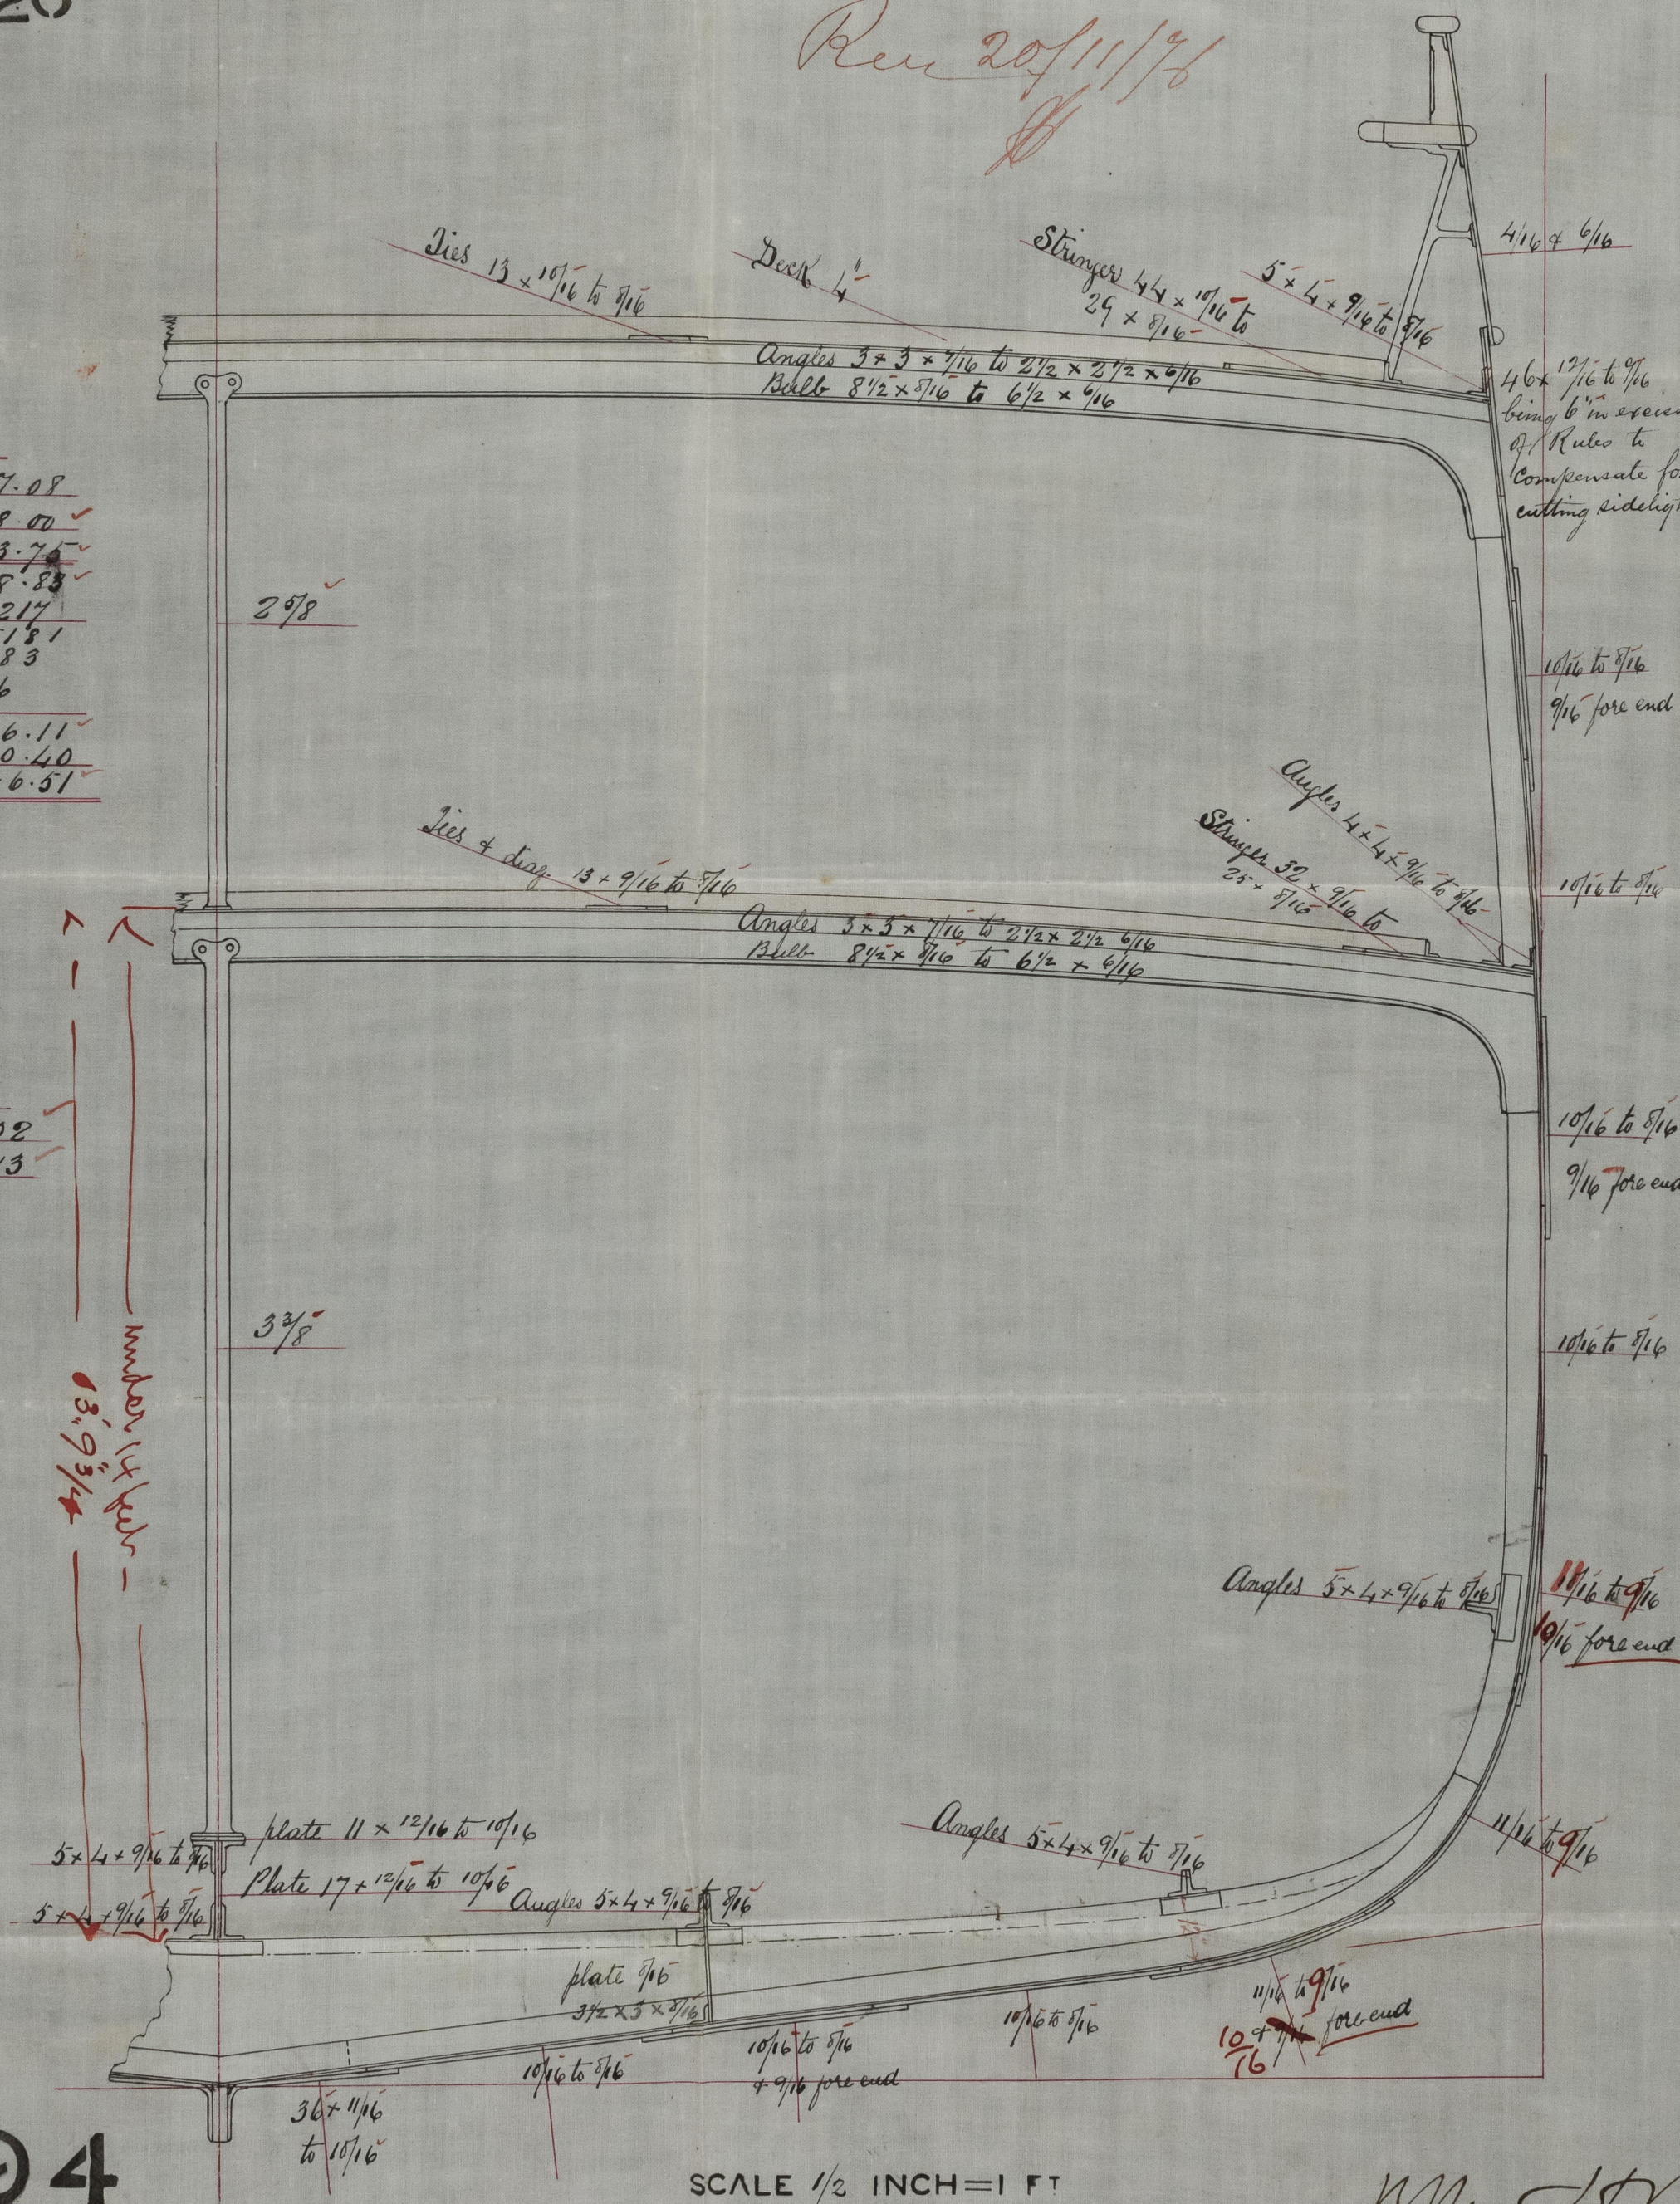

1" x 1" 9 x 2 1/2  
Stem 8 1/2 x 2 1/2  
Stem post 8 1/2 x 2 1/2  
Rudder 6" to lead to 3" to keel  
Frames 5 x 3 x 7/8 to 7/8 24 inc apart  
Rear frames 5 1/2 x 3 x 7/8 to 7/8 all  
Floors 24 x 7/8 to 7/8  
Bulkhead 7/8 x 6/8  
Bars 5 1/2 x 3 x 7/8  
Ceiling 2 1/2  
Cable Ream Bulk 6 1/2 x 6/8  
Angles 2 1/2 x 2 1/2 x 6/8  
Stringer 24 x 6/8  
Keel 10 x 6/8  
Porth Beams 5 x 4 x 7/8

The Built Straps of the Upper  
Deck Beams Stronger Water  
their Strake & ~~three~~ Strakes  
of Plating for half the Vessels  
length and ship to be one  
seventh of an inch thicker  
than the plates they connect  
& treble rivetted

3 shakes at helms to  
be  $\frac{1}{16}$  thicker than given in table.

DOBIE & CO  
GOVAN.  
GLASGOW  
NOV<sup>R</sup> 16. 1876.

**Nº 94**

SCALE  $1/2$  INCH = 1 FT

IRON 521- 0059

© 2021  
18.11.76  
Lloyd's Register  
Foundation