

MIDSUMMER SECTION

of
N^o 292


DIMENSIONS

LENGTH BETWEEN PERPENDICULARS 210
BREADTH EXTREME 35
DEPTH IN HOLD 21
TONNAGE REGISTER 1120 tons

Rec 2/11/76 & 18/11/76

Numerals for Scanlings ¹⁰ Class 100.A.
 Half moulded breadth _____ 17.4
 Depth from top of Keel to top of upper deck beams 23.2
 Girth of half Midship section _____ 35.5
 $\underline{76.1} \times 208 = \underline{\underline{15828}}$

Number for Equipment 16884

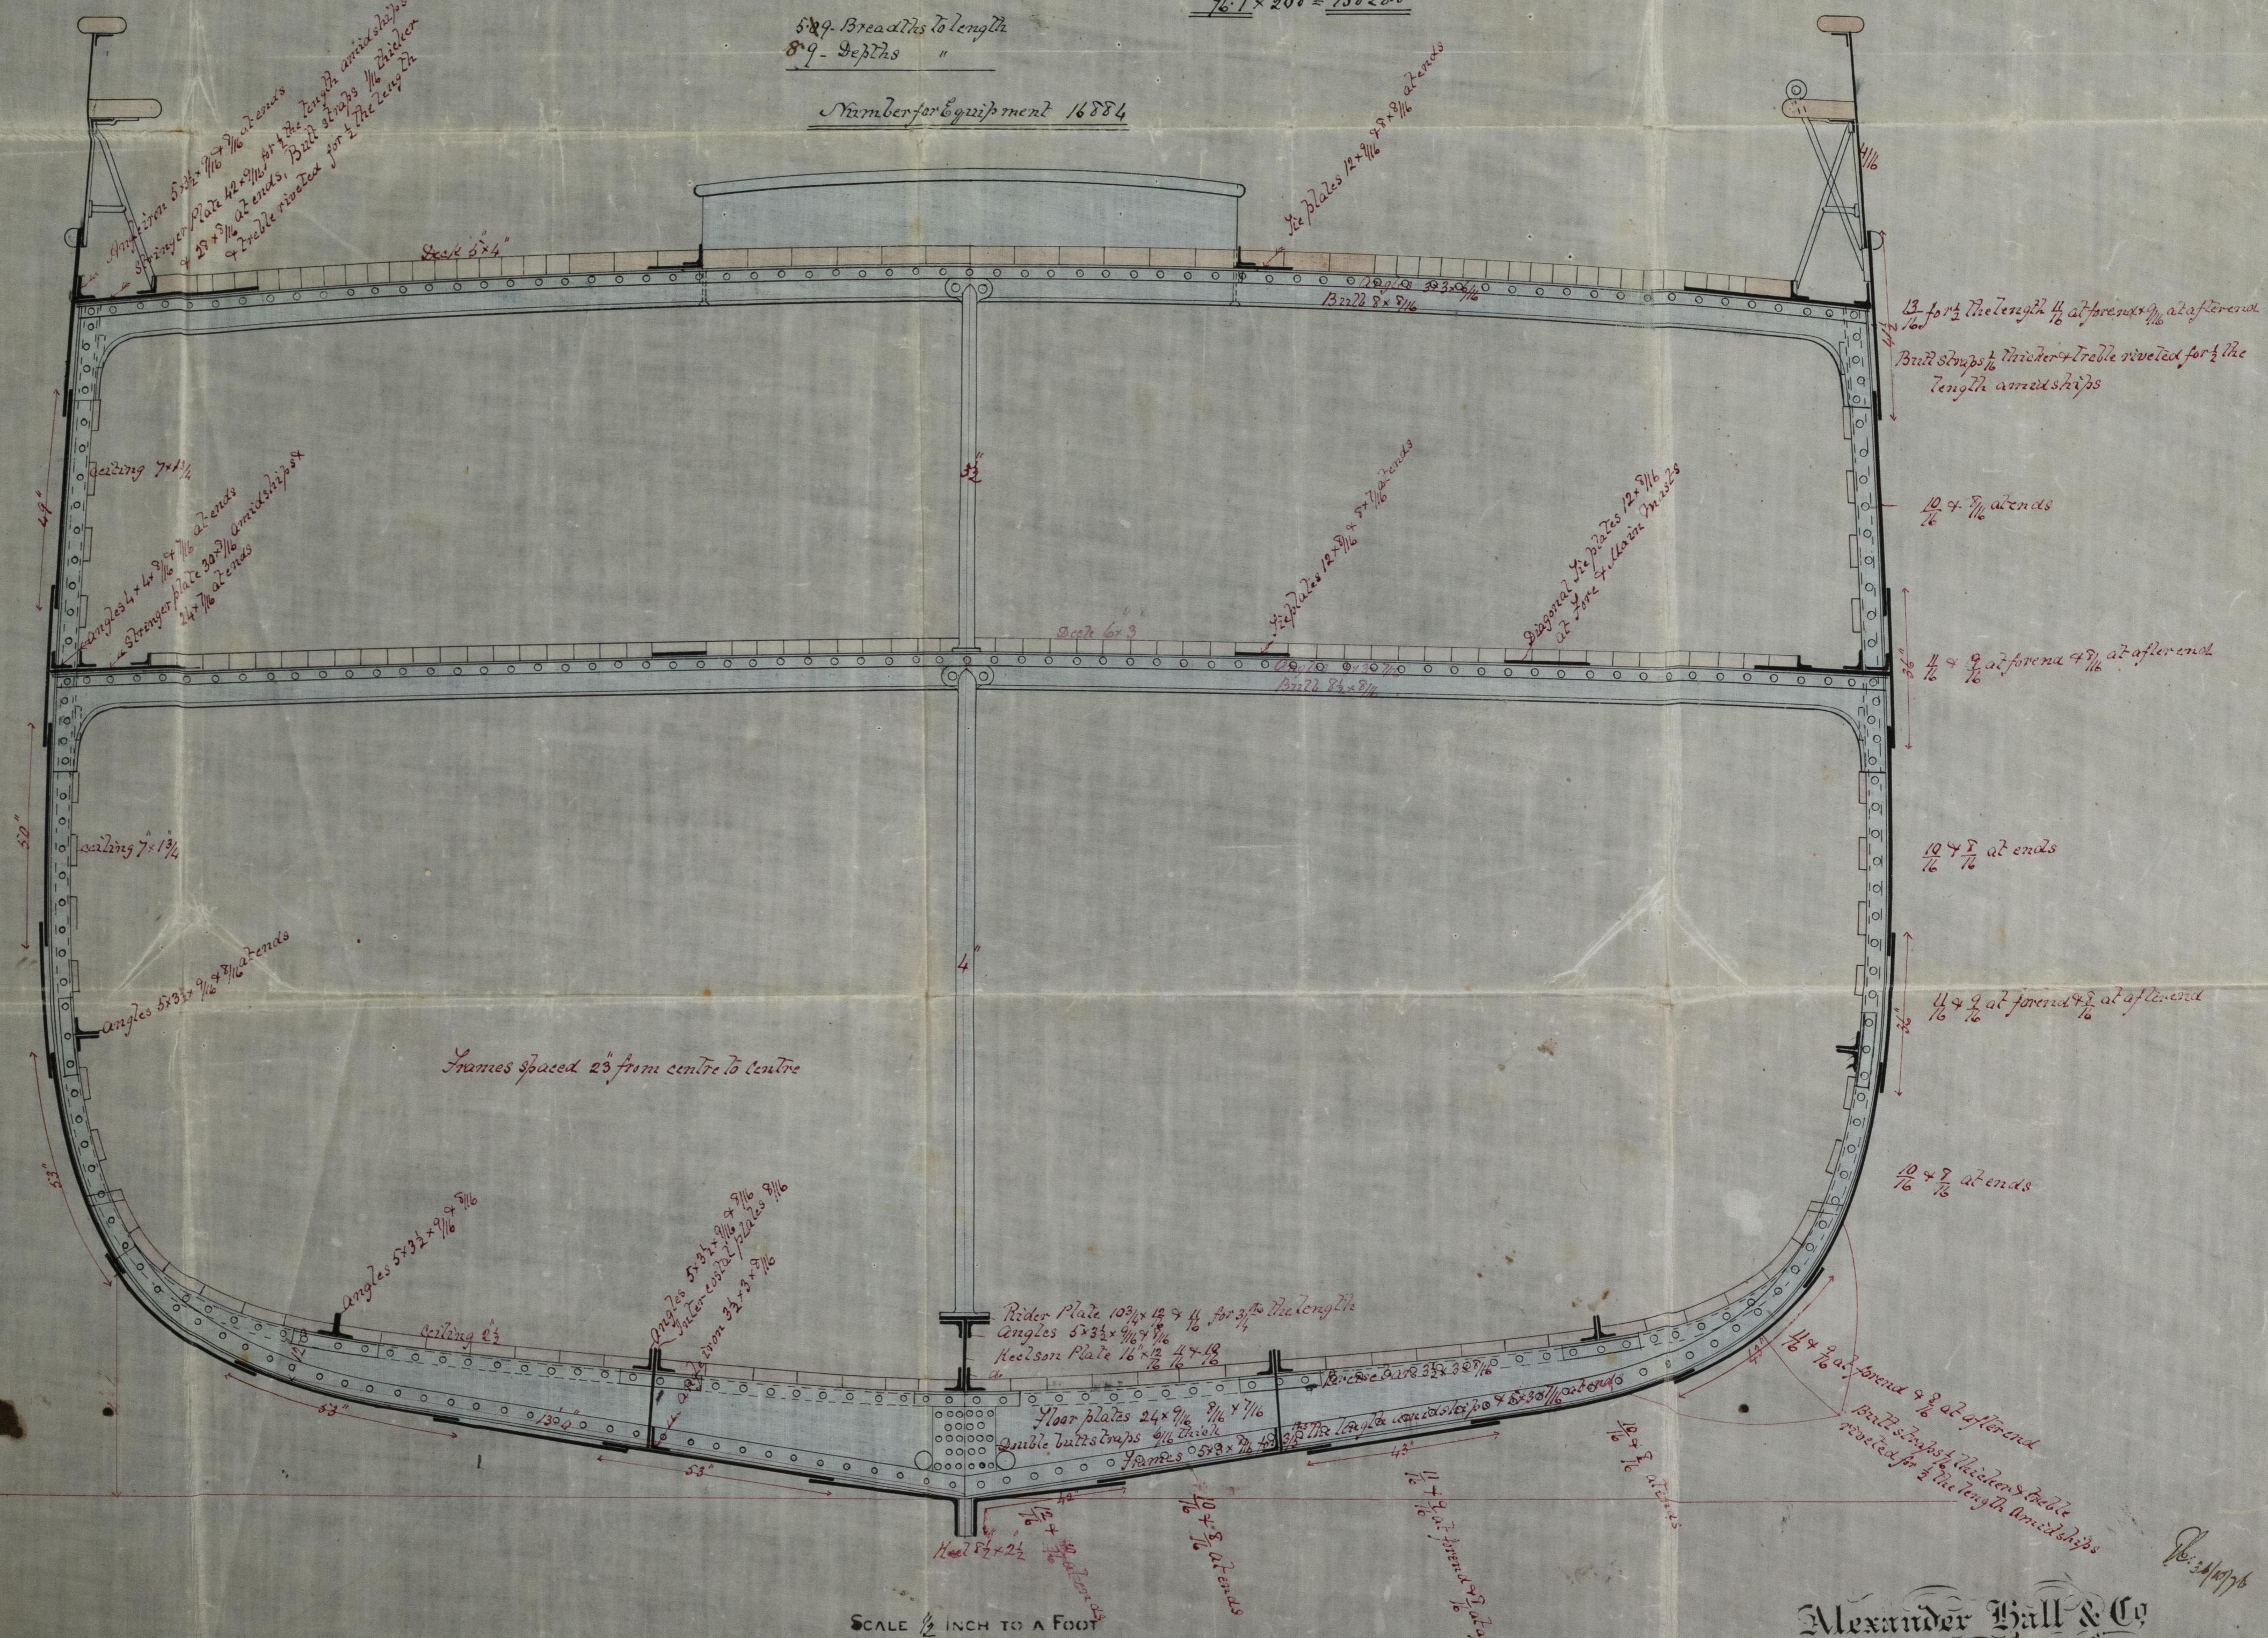

Alexander Hall & Co
Shipbuilders
ABERDEEN.

W. 34/1920

