



Iron Sailing Barque No 90.
 Masts & Sails.
 Scale 1" = 1 Foot

Foremast 28" dia. x 49'3"
 Plating $\frac{1}{16}$ & $\frac{1}{16}$
 Seams double rivetted
 Butts below mast Partners double
 Remainder treble.
 Masts doubled in way of wedging
 for 10'0" with $\frac{1}{16}$ plate.


Rec 11/1/77

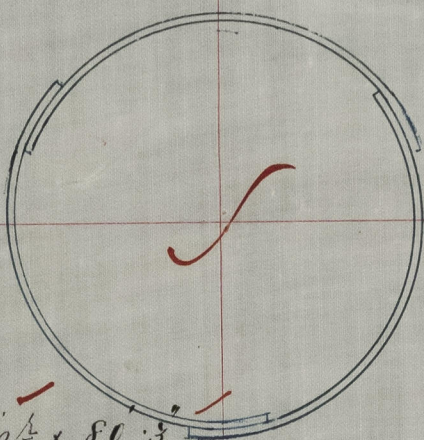

Mainmast 28" dia. x 80'3"
 Plating $\frac{1}{16}$ & $\frac{1}{16}$
 Seams double rivetted
 Butts below mast Partners double
 Remainder treble.
 Masts doubled in way of wedging
 for 10'0" with $\frac{1}{16}$ plate.

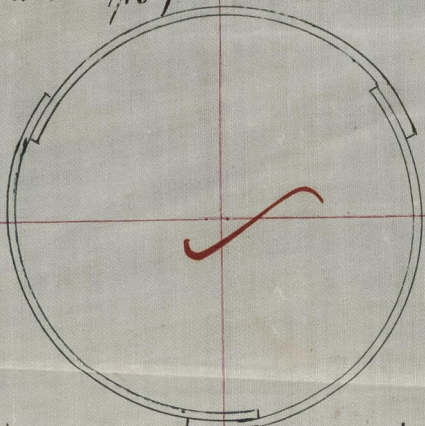


Mizen mast 20" dia. x 49'8"
 Plating $\frac{1}{16}$ & $\frac{1}{16}$
 Seams double rivetted
 Four plates above wedging treble, Remainder double.
 Masts doubled in way
 of wedging for 10'0" with
 $\frac{1}{16}$ plate.

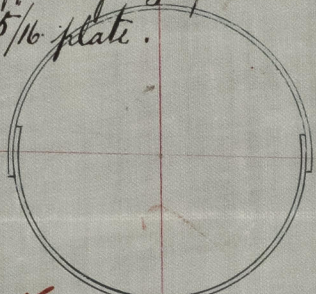


Mizen Mast as
 B^{re} "Barbara"
 yard No. 26
 see Letter 11th Sep 76.



Bowsprit 26" dia. x 20'0" outside of bed, Extreme 34'0"
 Plating $\frac{1}{16}$ & $\frac{1}{16}$
 Seams double rivetted
 Butts inside of wedging double riv.
 remainder treble.
 Double in way of wedging 6'0" with $\frac{1}{16}$ plate.

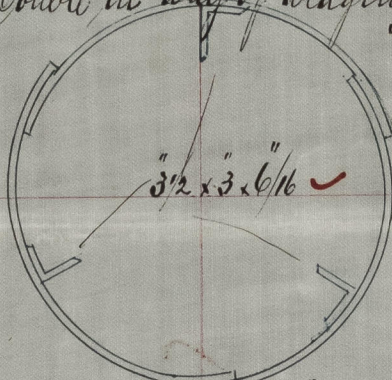

Lower yards 18" dia. x 45'6"
 Plating $\frac{1}{16}$, $\frac{1}{16}$, & $\frac{1}{16}$
 Seams single rivetted
 Butts treble
 Doubles in way of centre 6'0" x $\frac{1}{16}$ plating.

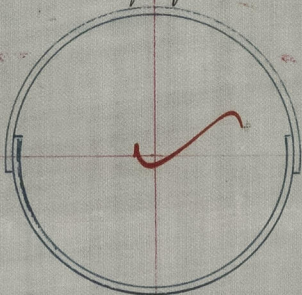

Lower Topsail yards 16" dia. x 64'6"
 Plating $\frac{1}{16}$, $\frac{1}{16}$, & $\frac{1}{16}$
 Seams single rivetted
 Butts treble
 Doubles in way of
 centre for 5'0" with $\frac{1}{16}$.

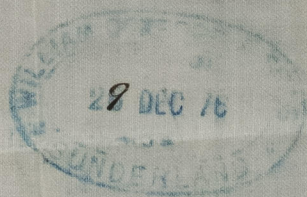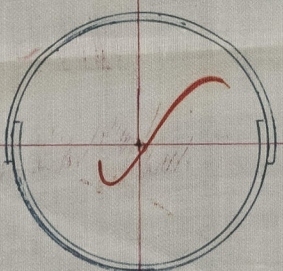

V.M.
 H.M.
 2/1/77



© 2021
 Lloyd's Register
 Foundation

1R01521-0061

B^{re} "Barbara" Report No. 11.6.76.