


Equipment Memorial 16929 ✓

Amended Midship Section of 90 Ship  
Scale 1/2 inch = 1 foot

1310 "County of Flint" Reports No 11.6/6

Equipment  
2 *Spars* 30 Part ✓  
1 *Beam* 12.0 ✓  
1 *Ridge* 6.0 ✓  
1 *"* 3.0 ✓

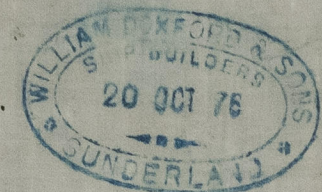

Class 100 A Lloyd's  
Rules 1875 & 76


Dimensions as per rule  
Length 210.6  
Ch. Breadth 34.9  
Depth 23.2  
1/2 Girth 34.10

1/2 Ch Breadth 17.45 ✓  
Depth top keel 23.16 ✓  
1/2 Girth 34.83 ✓  
15080 16500  
15871.708 2nd ✓

270 fathoms of 1 1/16 Chain cable ✓

Raised Quarter Deck, about 35 feet from stern post under

Proportions  
10 Depth from top of keel  
4 Breadth

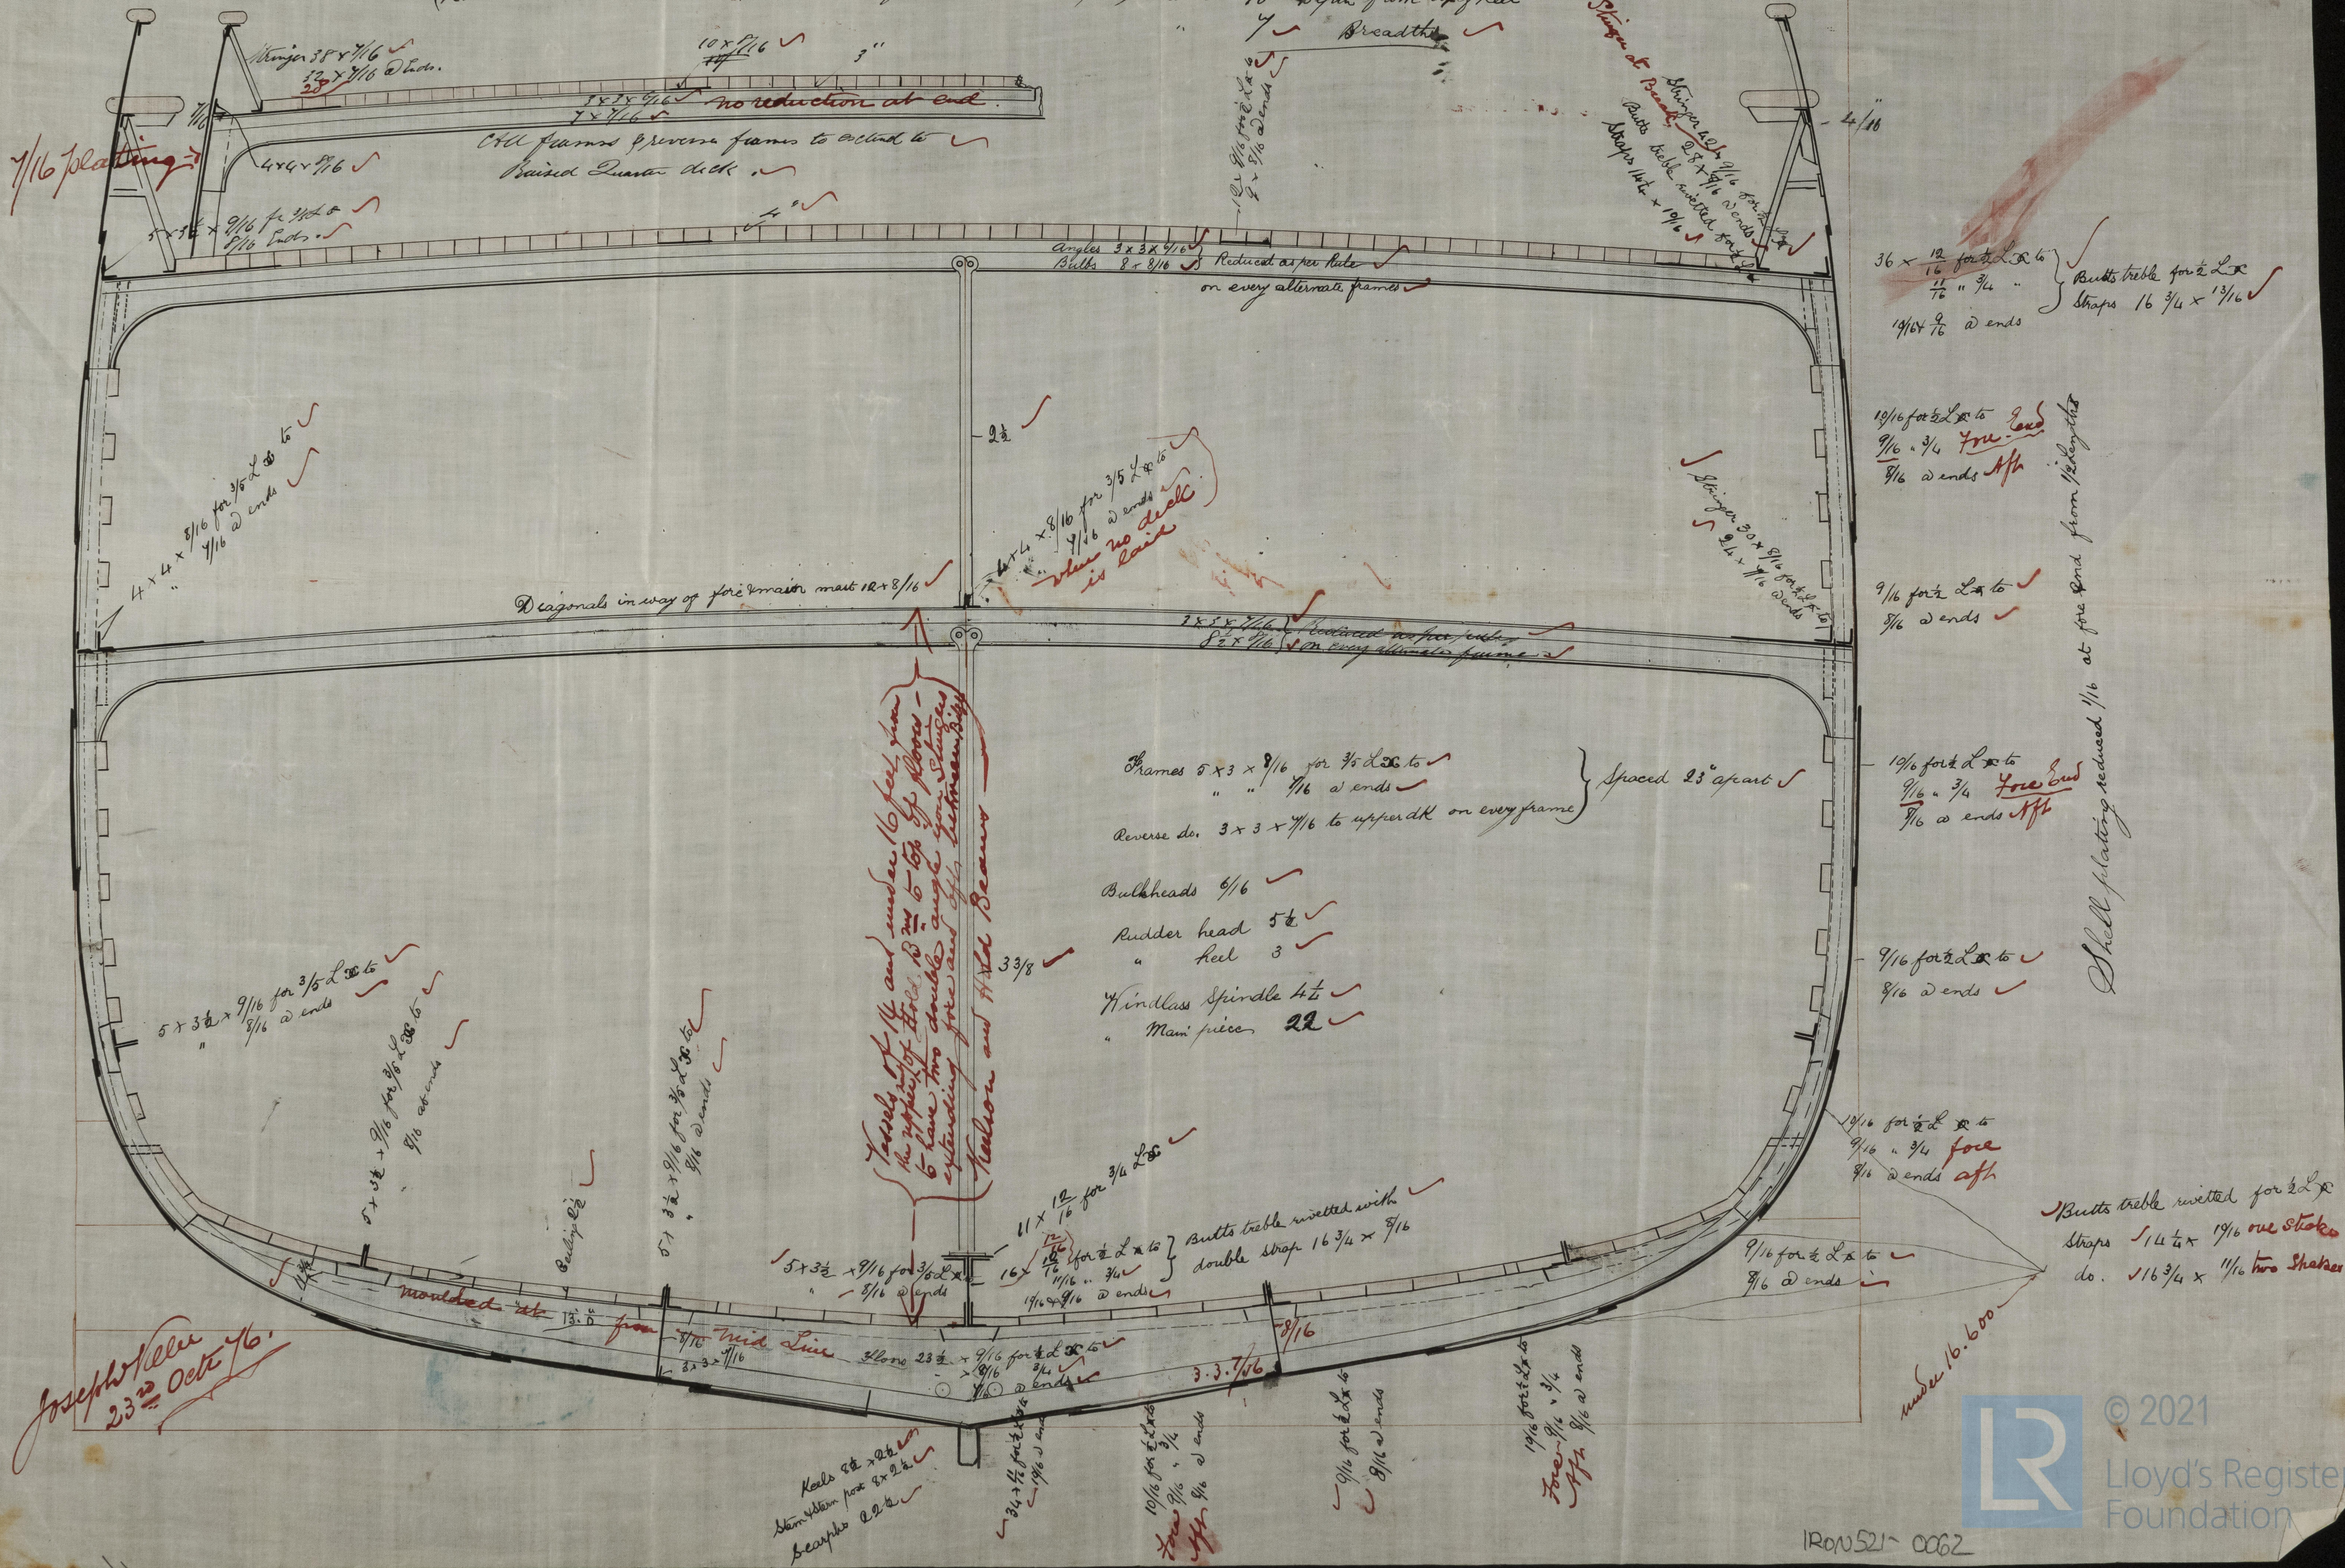

IRON 521-0062