

"Lloyds" Reg. No. 27


Circulating Pipes for "Hagston Hall's"  
and "Lloyds" Boilers  
4 for each Boiler

PALMERS SHIPBUILDING & IRON COY., LD.  
ENGINE WORKS DEPARTMENT



16/5/97

IRON 521-0065

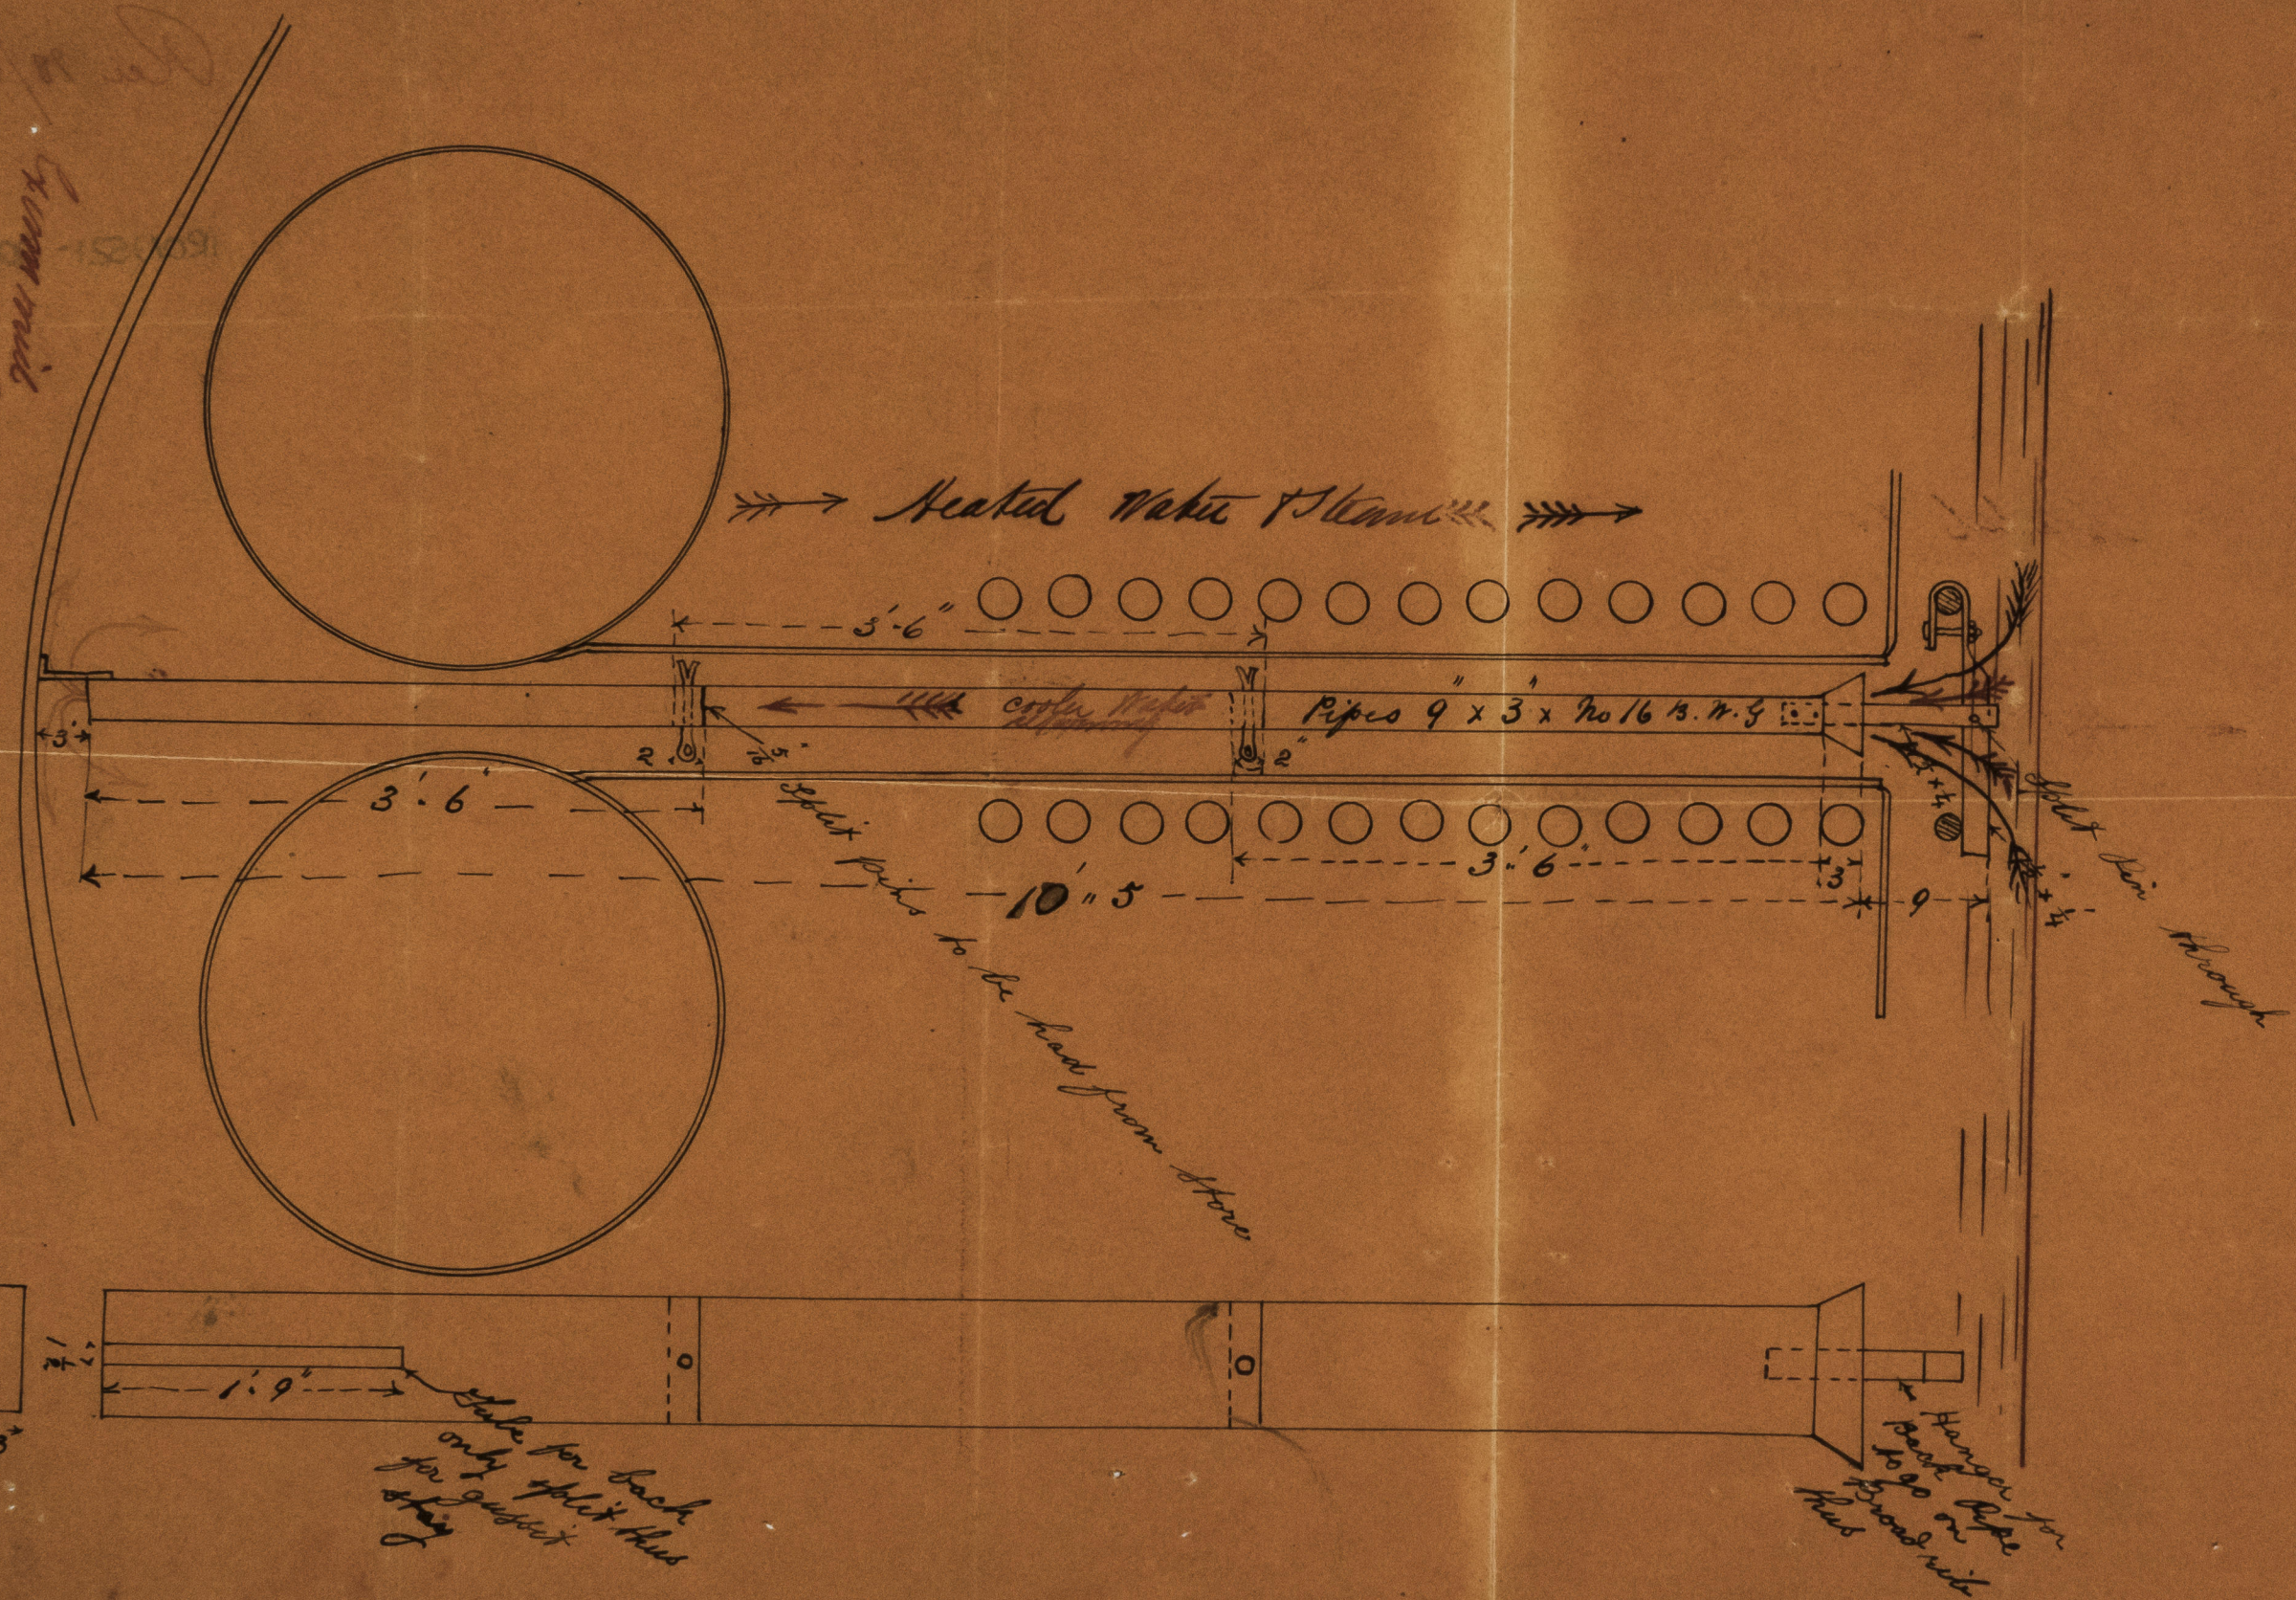

From mid  
J. M. M. M. M.  
11.5.97



