
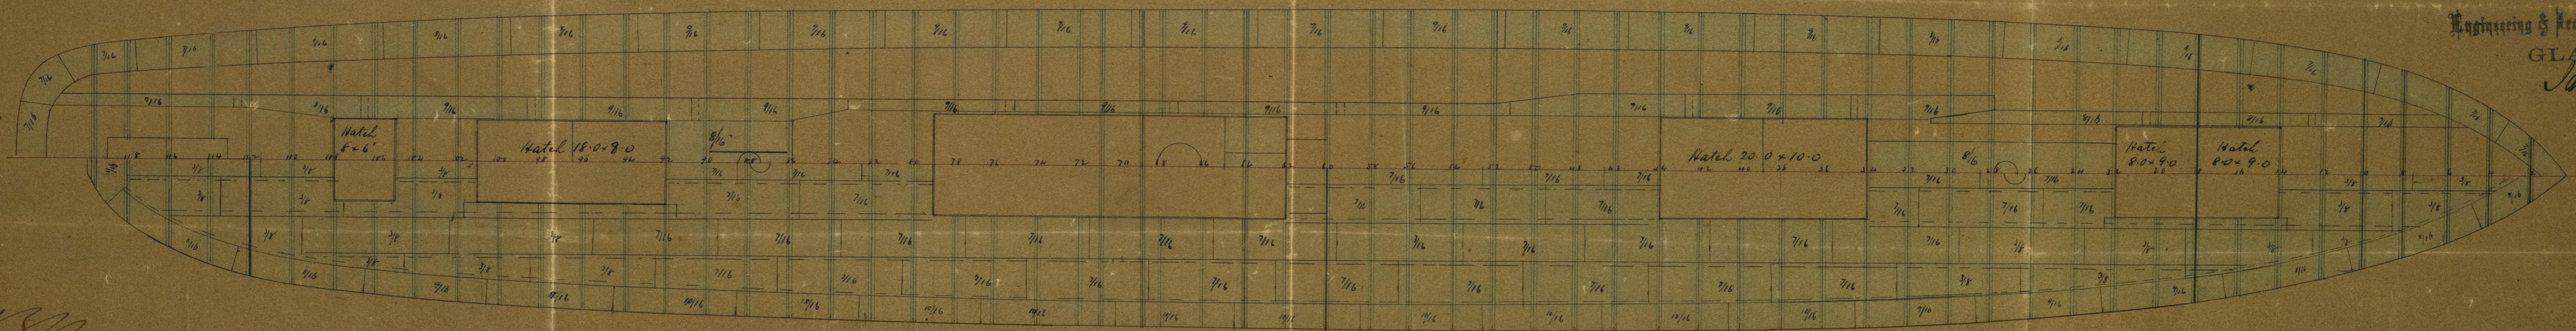


PERIM²⁰
 S.S. N^o 200
 SCALE $\frac{1}{8}$ INCH TO THE FOOT
 Dec 30/1877

In Scantlings see Midship Section
 and Lords letter of approval of Nov^r 7th 1877 Glasgow Report No^o 4453

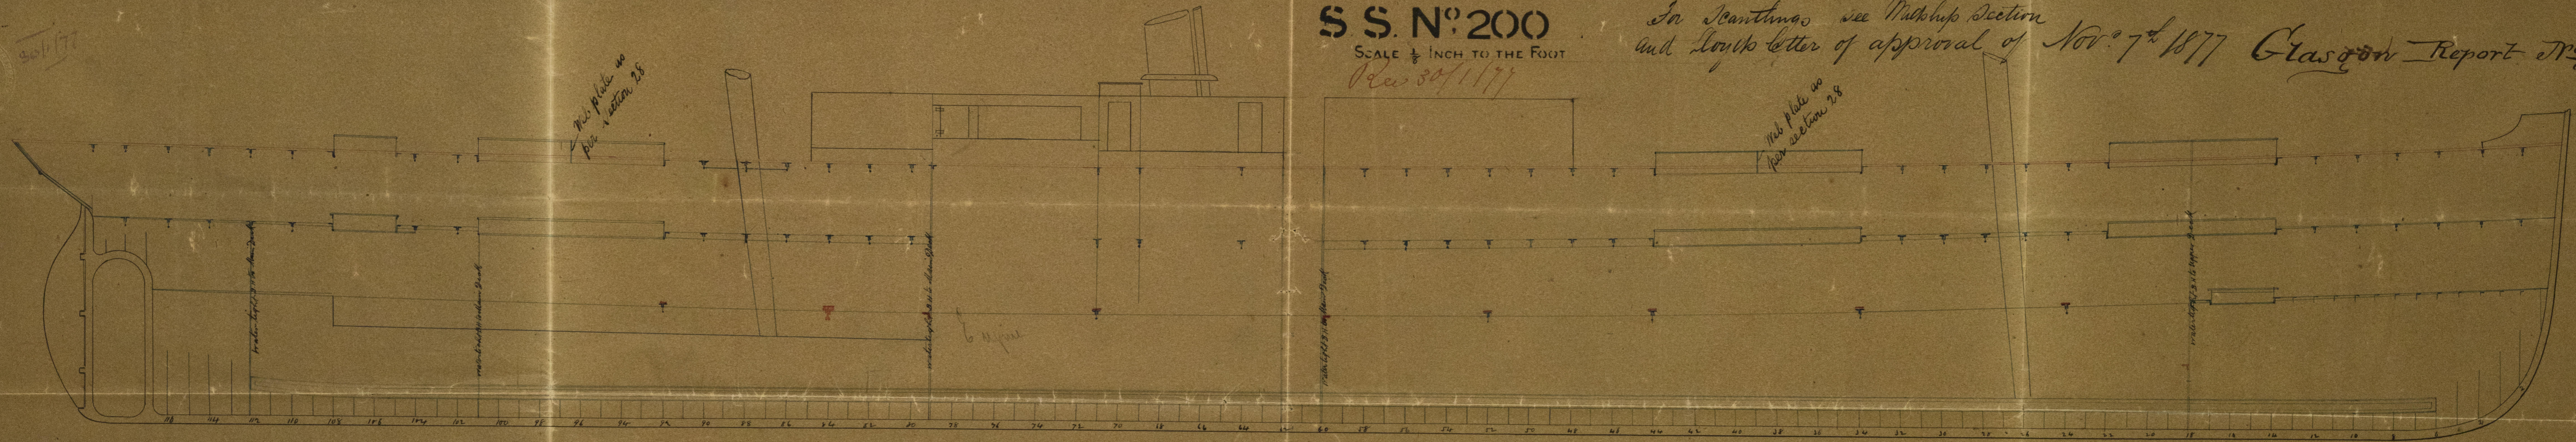

LONDON AND GLASGOW
 Engineering & Iron Shipbuilding Co., Ltd.

GLASGOW
 Jan^y 25th 1877



© 2021
 Lloyd's Register
 Foundation

IRON 521-0069