

27/10/76

# Bt "Dumfriesshire" of Liverpool Greenock Report 7233


Barge No 10  
1/2 Midship Section.  
Scale 1/2 inch = 1 foot  
Classed Coast

Length between pers 220.0  
Breadth moulded 36.0  
Depth of Hold 21.6

1/2 B 7<sup>th</sup> inc.  
1/2 & 18.0  
1/2 & 37.4  
1/2 & 24.1  
1/2 & 79.5 1<sup>st</sup> op  
1/2 & 22.0  
1/2 & 174.90 2<sup>nd</sup> op  
1/2 & 11.66 1<sup>st</sup> added for equipment  
1/2 & 186.56

Rec 26/10/76


Equipment:  
1 Bower ex. stock 34 Rodgers old  
1 " " " 30 " "  
1 " " " 27 1/4 " "  
1 Stream inc. 13 Common  
1 Ridge " 6 1/2 " "  
1 " " 3 1/4 " "  
270 fathoms 1 1/2 Chain  
98 " 1" Stream Chain

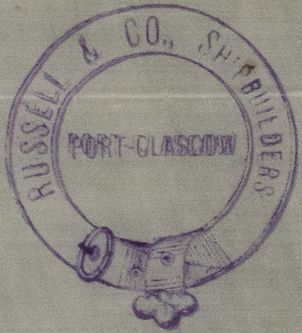




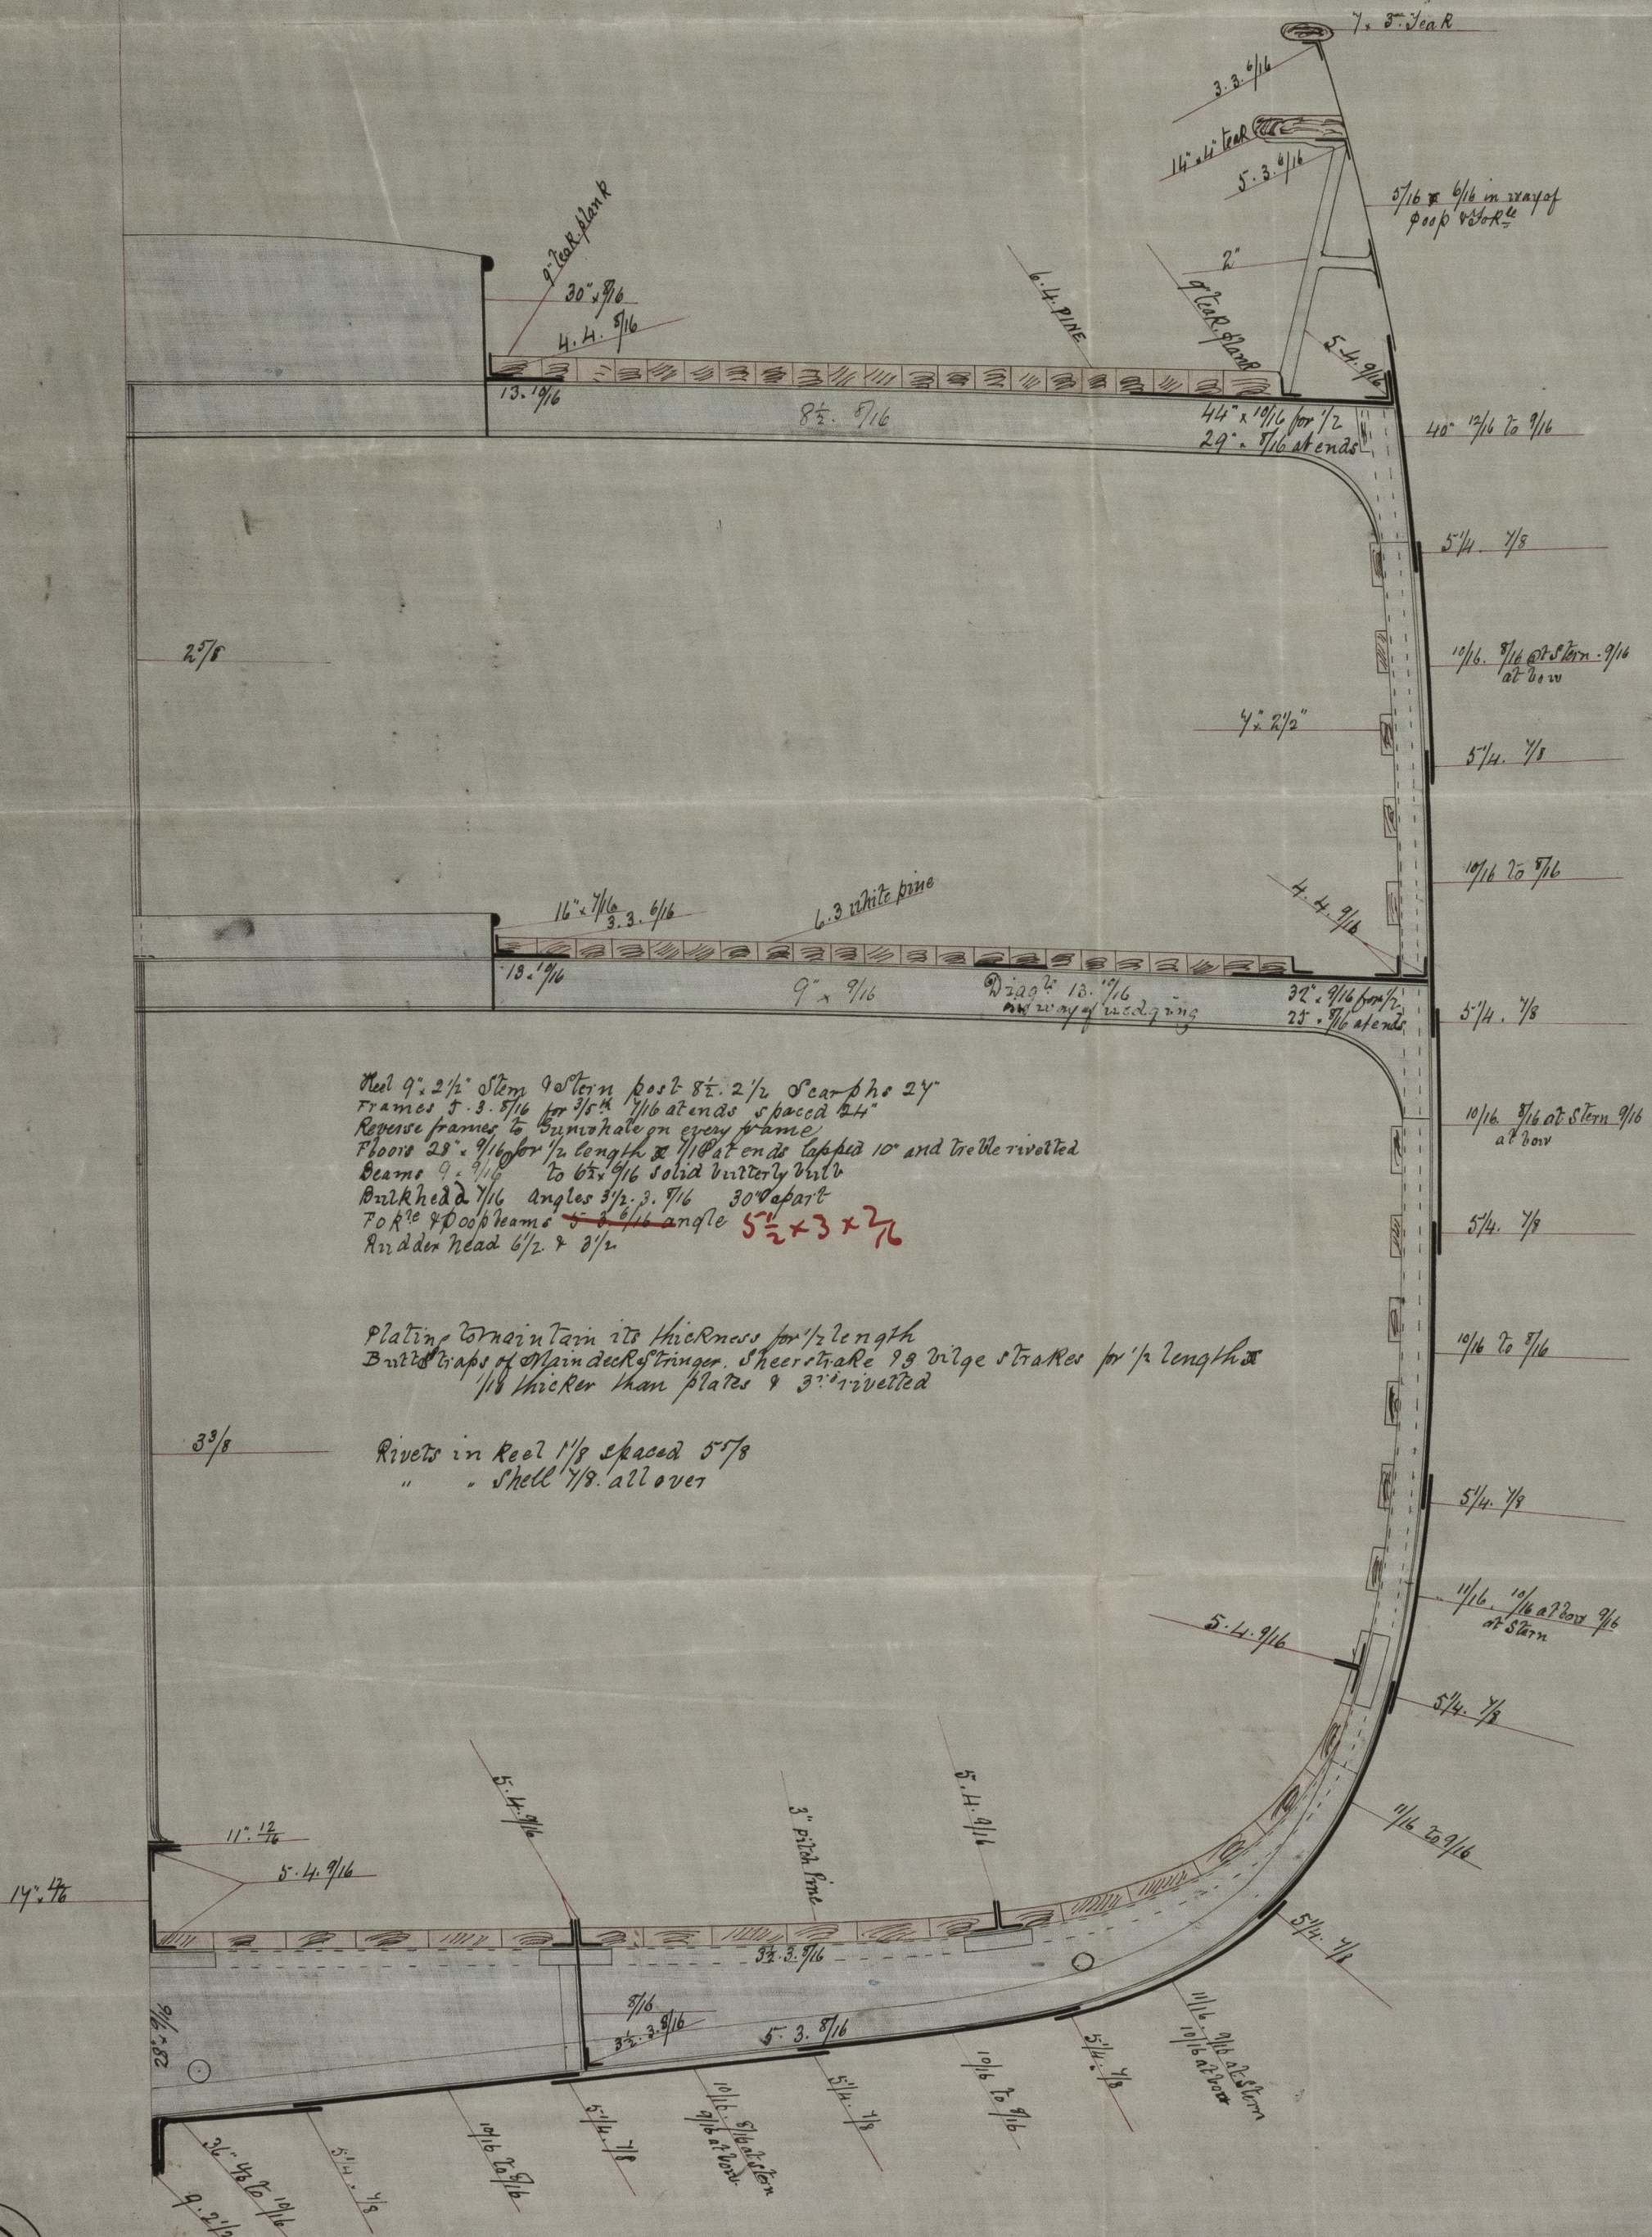

27/10/76

© 2021

Lloyd's Register Foundation

IRON 521-0084