


23/11/76

Iron S.S. "Sunder" Report No. 11.688.

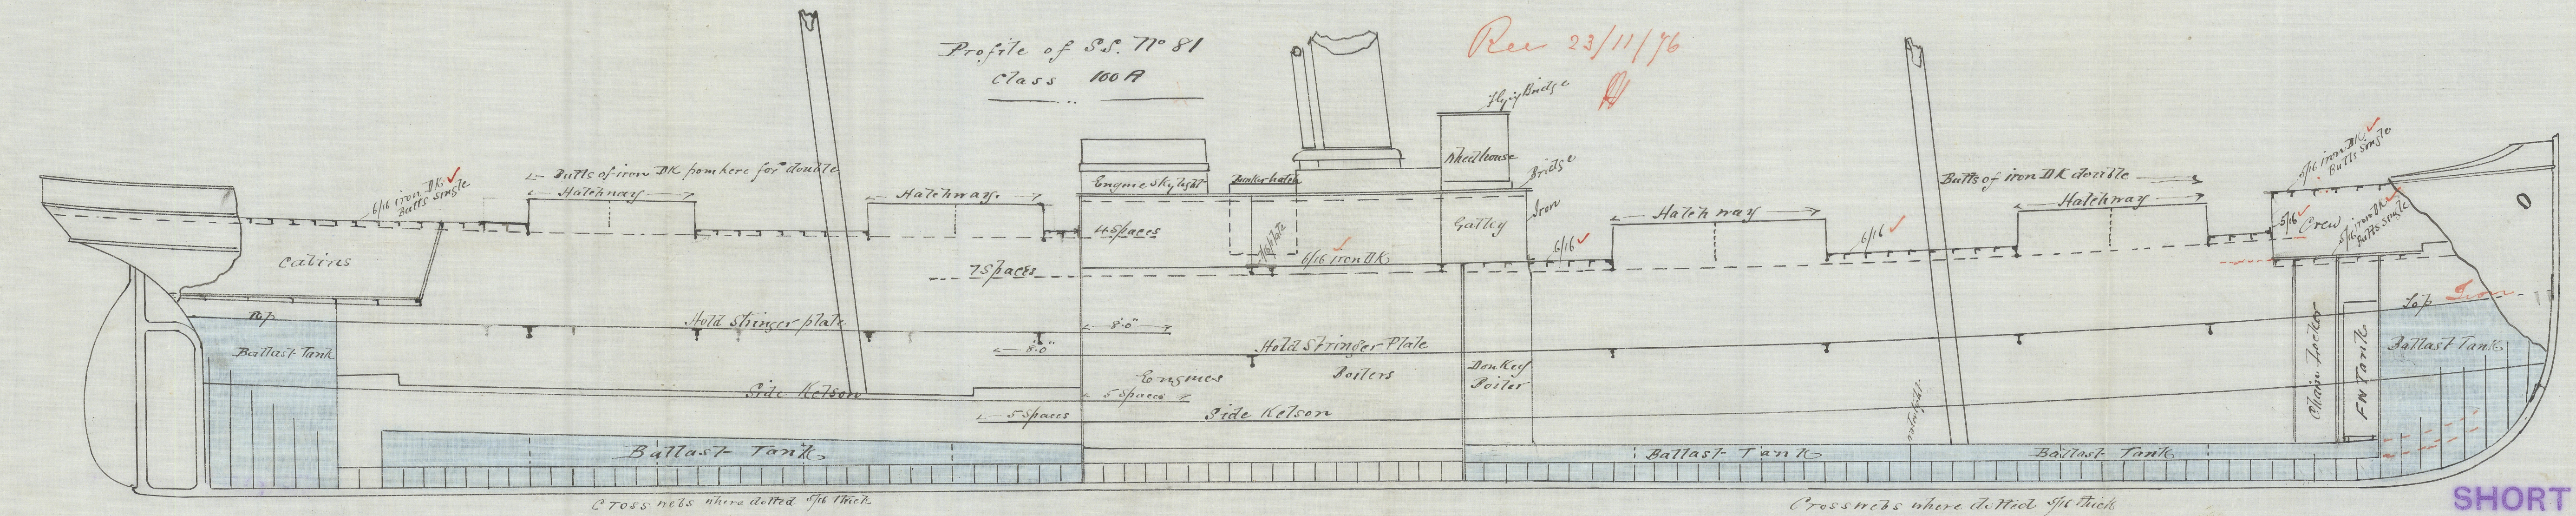


SHORT BROTHERS,
Iron Shipbuilders,
SUNDERLAND.

Wm
23/11/76

LD 17/76

IRON 521-0093

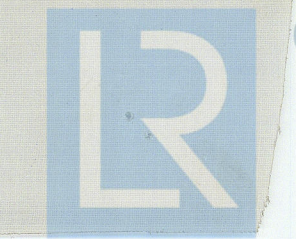

© 2021
Lloyd's Register
Foundation