


B. S. L. Taylor
 Report No. 3170

141

Rep by
 W. D. D. 11/6/77

For Spar deck

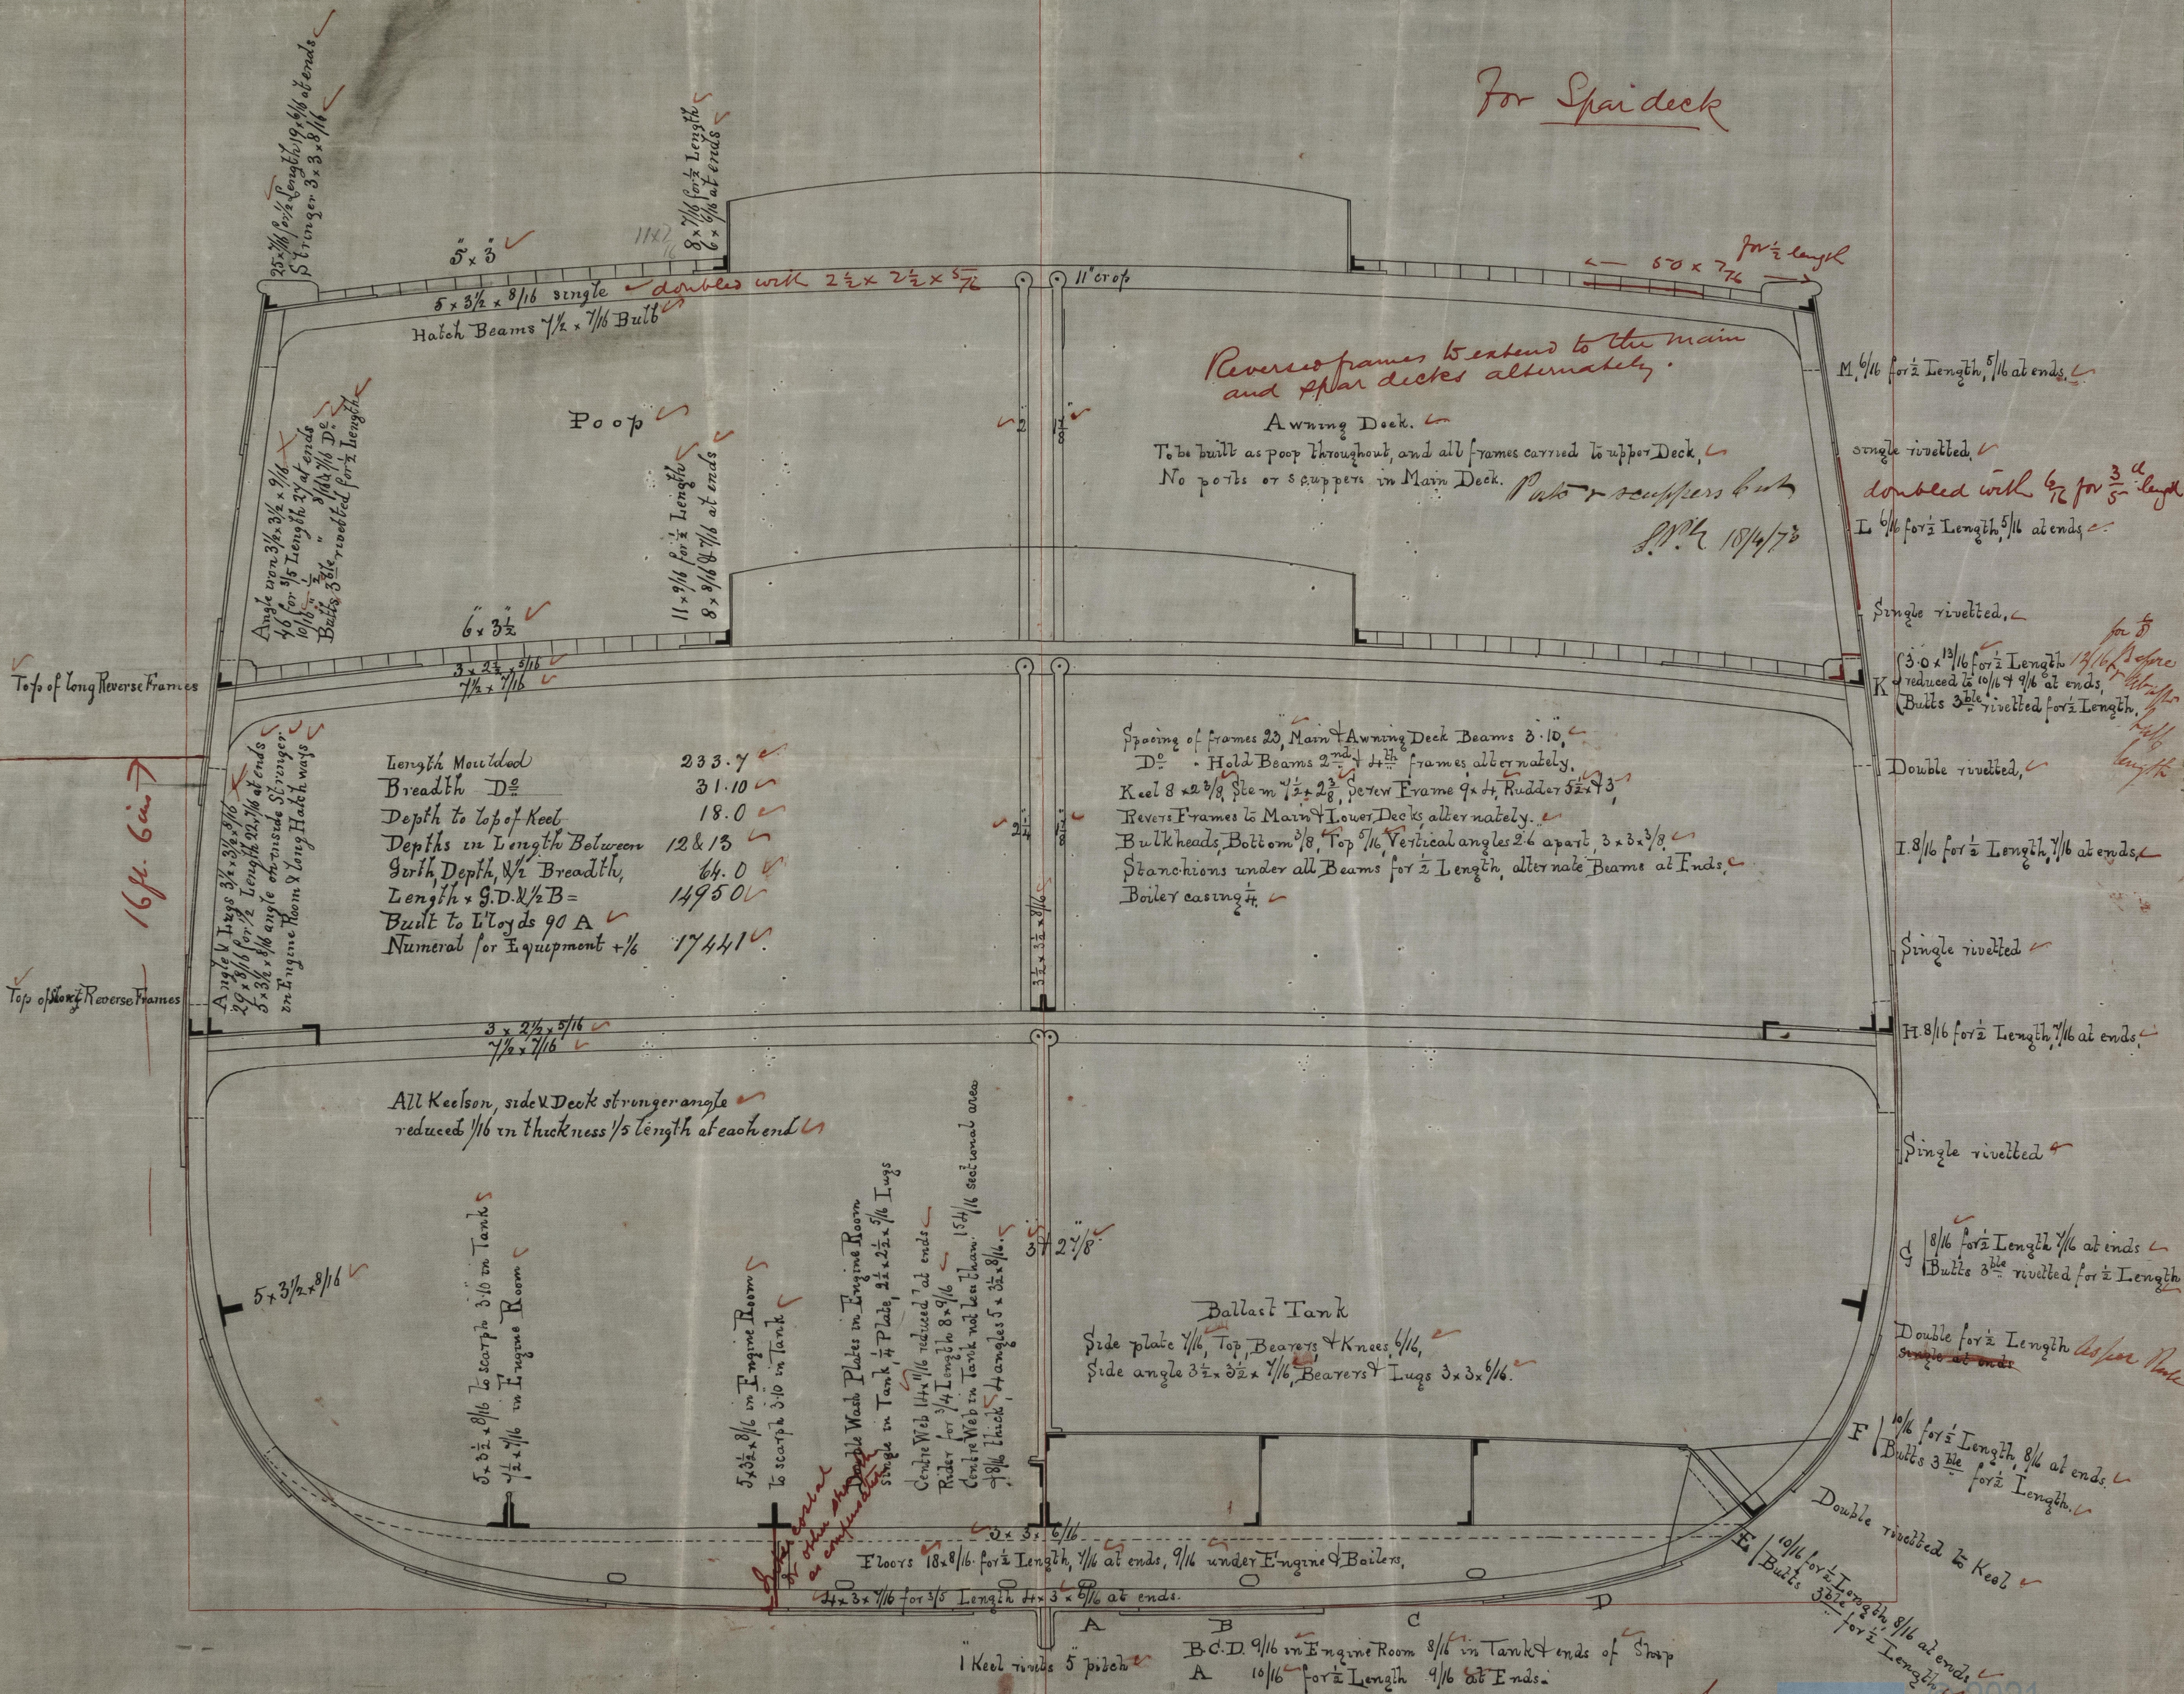

— DENTON, GRAY & CO —
 — DOCK YARD —
 WEST HARTLEPOOL

Unmarked Drawing Book 21/10/77
 See increased breadth 11/11/77

180521-0095