MOUNSEY & FOSTER,
IRON SHIPBUILDERS,
SOUTH DOCK,
SUNDERLAND.

Iron Ship "Dartford" Report No. 11690

Dec. 15th 1876.

MIDSHIP SECTION of IRON SAILING SHIP No 80.

SCALE ½ INCH = ONE FOOT.

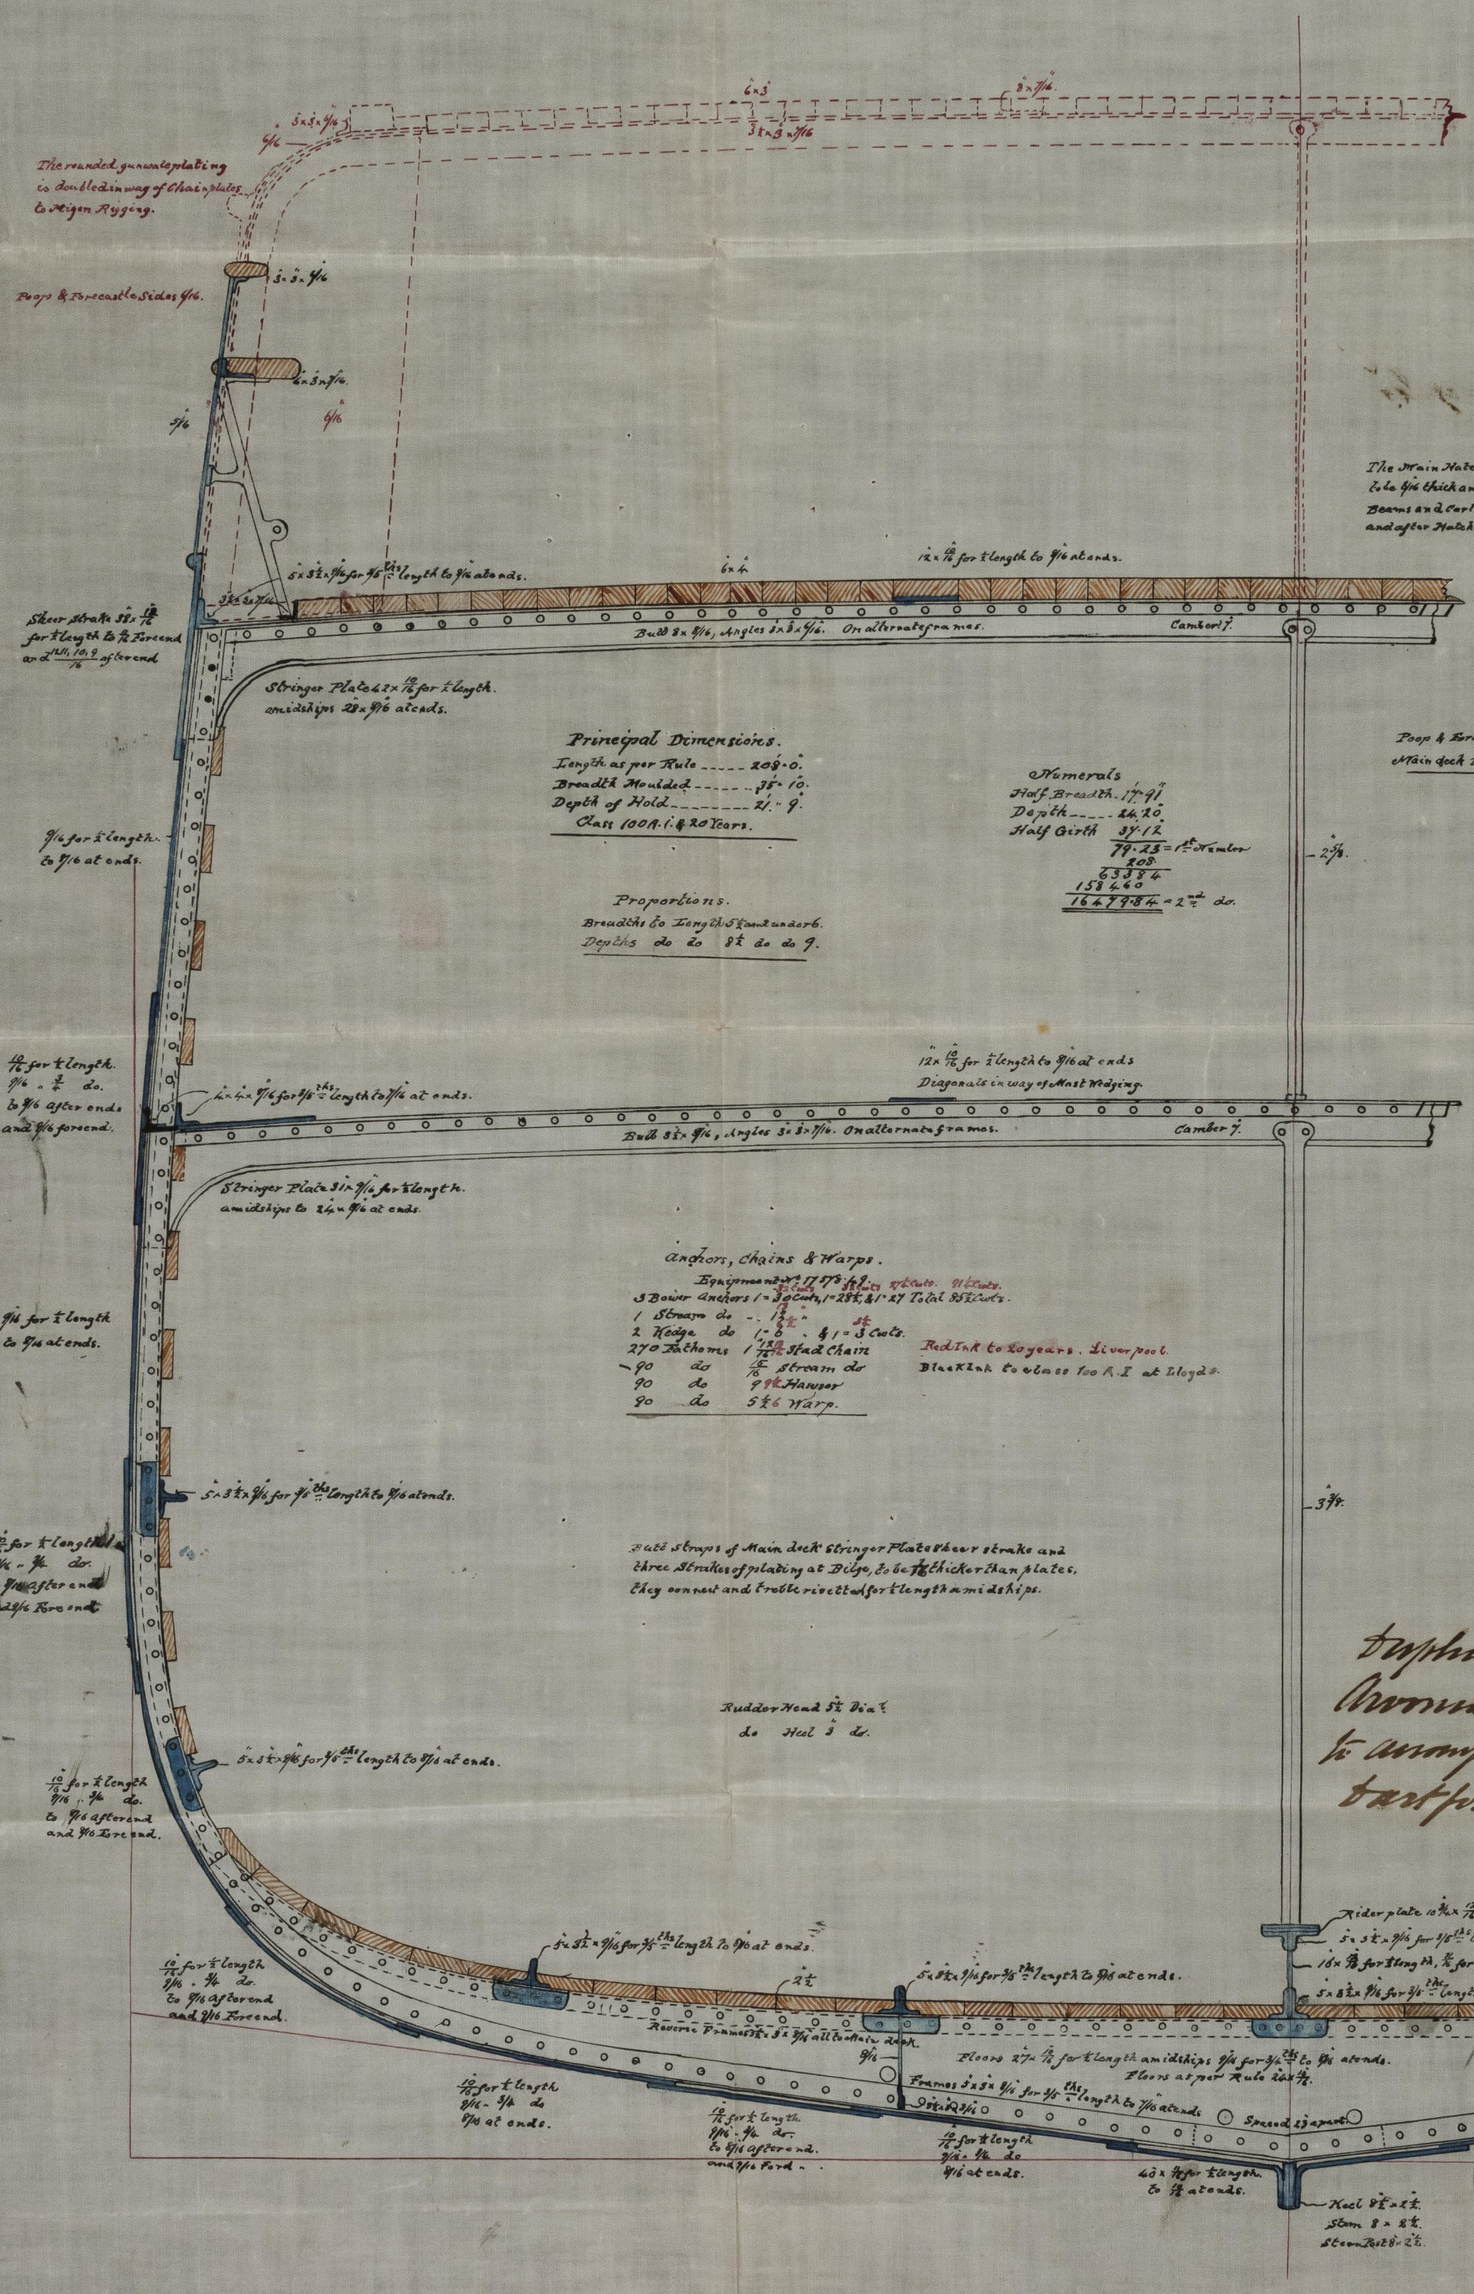

The Main Hatch Coamings and Headledge to be 9/16 thick and to extend to the Bulb of Beams and Carlings. Those forming Foremast and after Hatches may be 7/16 thick.

Poop & Forecastle Beams 5½ x 3½ x 7/16
Main deck Beam angles at Hatch sides 5 x 3 x 9/16.

Principal Dimensions.

Length as per Rule ____ 208'-0"
Breadth Moulded ____ 35'-10"
Depth of Hold ____ 21'-9"
Class 100 A.1. & 20 Years.

Proportions.

Breadths to Length Standard 6.
Depths do do 8½ do do 9.

Numerals

Half Breadth 17'-9"
Depth ____ 14.20
Half Girth 31'-12
79.23 = 1st Numeral
208
63384
158460
16479.84 = 2nd do.

Anchors, Chains & Warps.

Equipment No 1778 Rule. 3 Cwts. 9 Cwts. 11 Cwts.

3 Bower Anchors	1 = 30 Cwts, 1 = 28½, & 1 = 27	Total 85½ Cwts.
1 Stream do	1 = 12½	12½
2 Kedge do	1 = 6 & 1 = 5 Cwts.	11
270 Fathoms	1 12/16 Stud Chain	
90 do	12/16 Stream do	
90 do	9/16 Hawser	
90 do	5/16 Warp.	

Red Ink to 20 years. Liverpool.
Black Ink to class 100 A.1 at Lloyds.

to accompany report on Dartford..

WS 13/1/77

© 2021 Lloyd's Register Foundation

IRON 521 - 0105