

No 103 -

"Lord Cairns"

To Class 100 A at Lloyds

Report No 245-2

Length - - - - - 224' 4"

Breadth - - - - - 36' 0"


Depth to top of ceiling - - - 22' 4"

Numerals - - - 79.8 and 17.900

Scale $\frac{1}{4}$ " = 1 Foot -

Rev 19/7/75

19/7/75

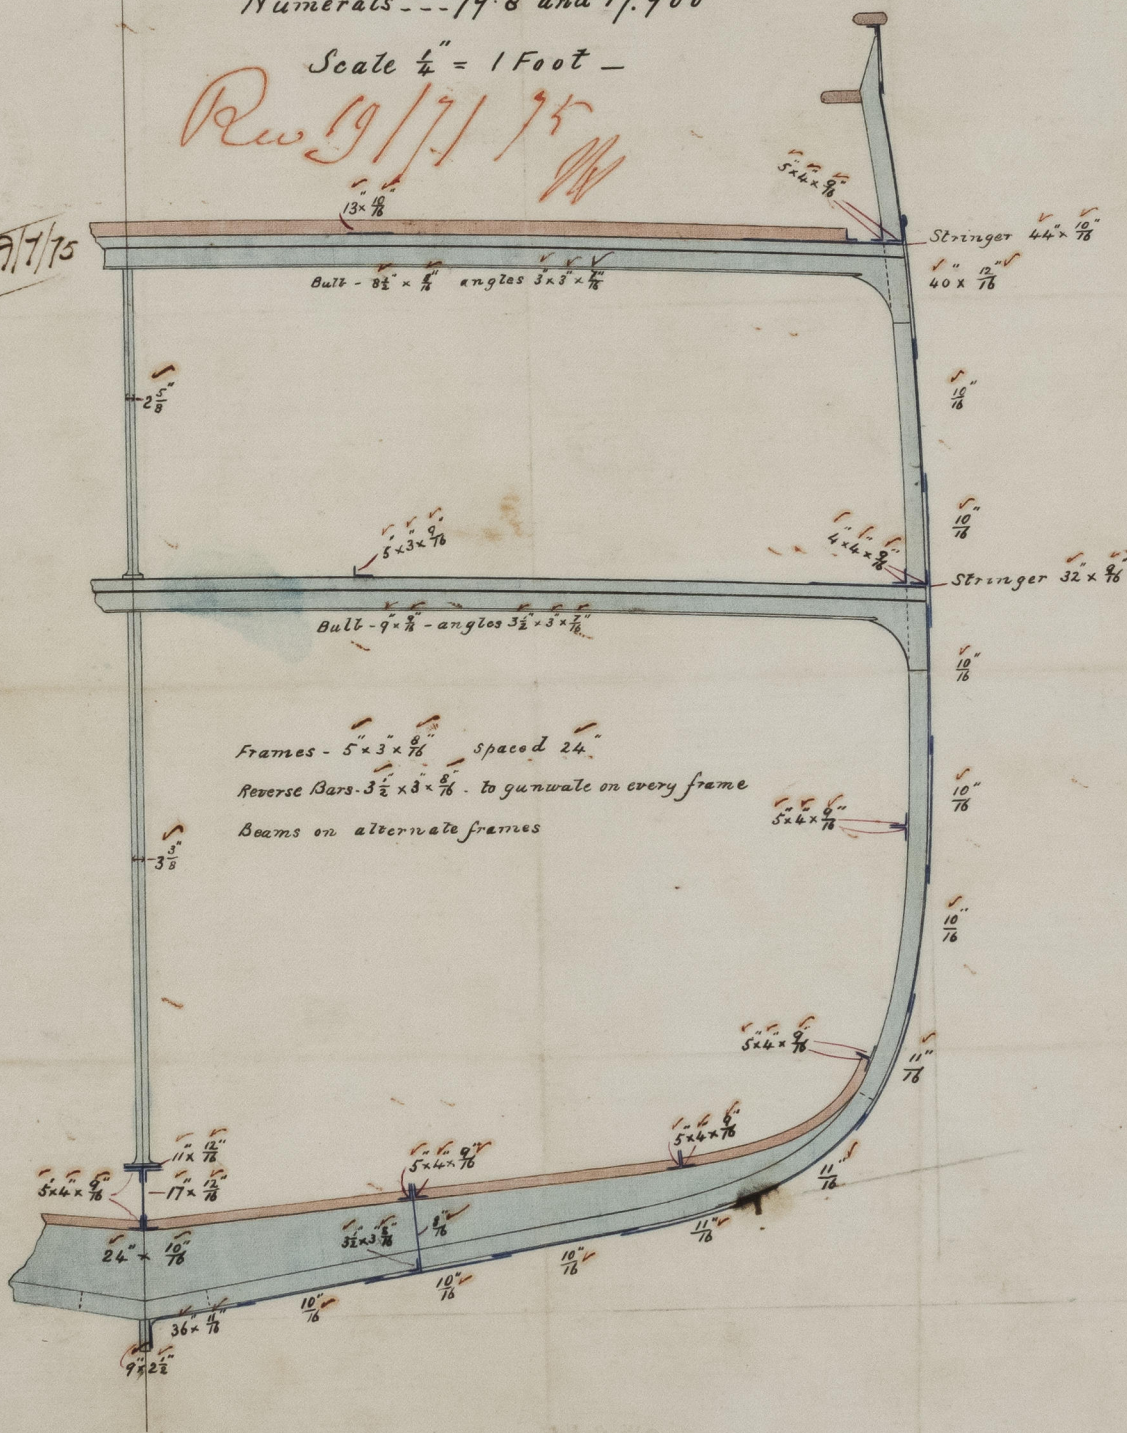

M. H. 19/7/75
19/7/75

15th July. 1875

T.H.C.



19/7/75

Lloyd's Register Foundation

IRON 521-0151