


7663
No 363

S.S. RANGER

For Lloyd's

Scale 1/4" = 1 foot

Per 28/7/76

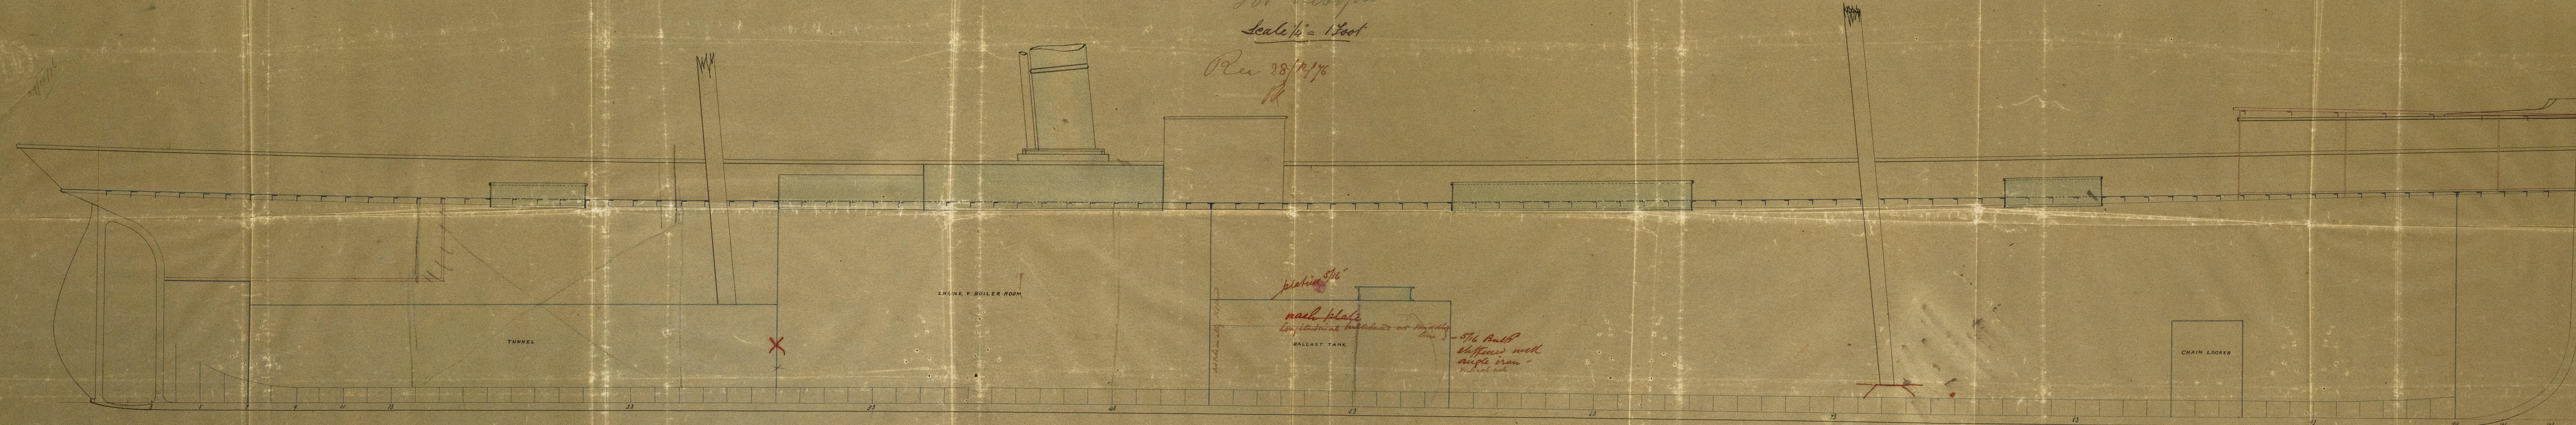

X Since approved Engine and Boiler space and Ballast Tank fitted 4 frame spaces further aft than shown D.2

18/11/76
28/12/76