



7687
N^o 363

"RANGER"

Gracing stemming means of strengthening
 in Engine & Boiler Room

Scale $\frac{1}{4}" = 1 \text{ foot}$


Per 30/1/77
 RS

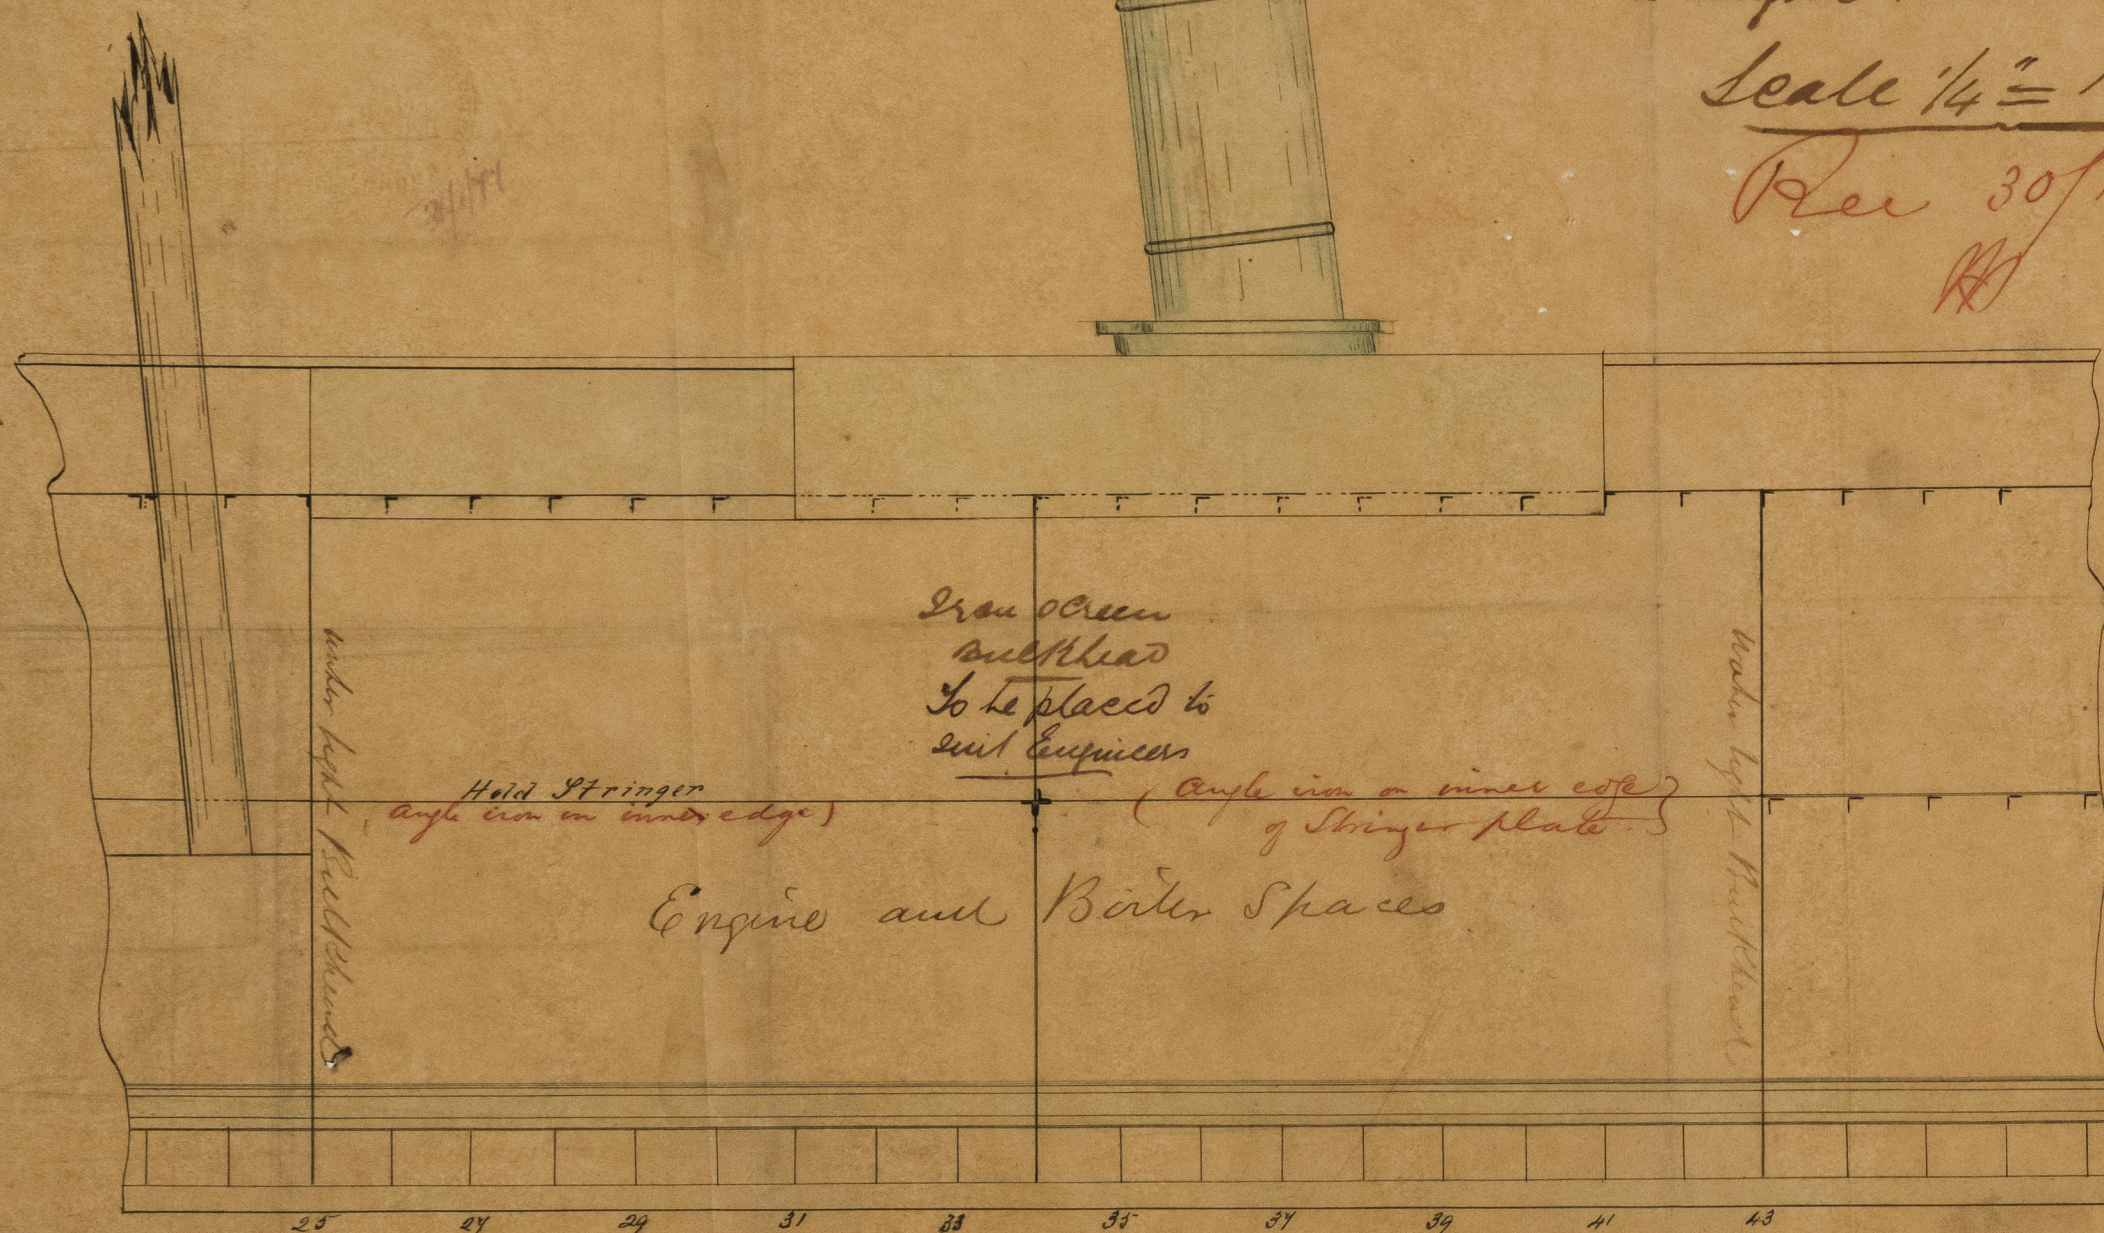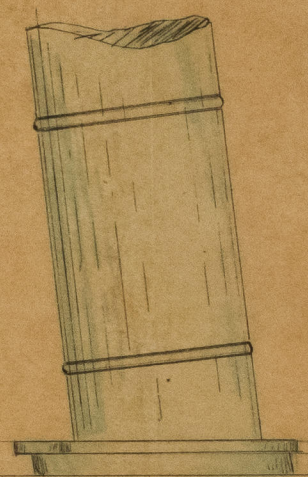

Scale $\frac{1}{4}" = \text{one foot}$

Section at Beam.


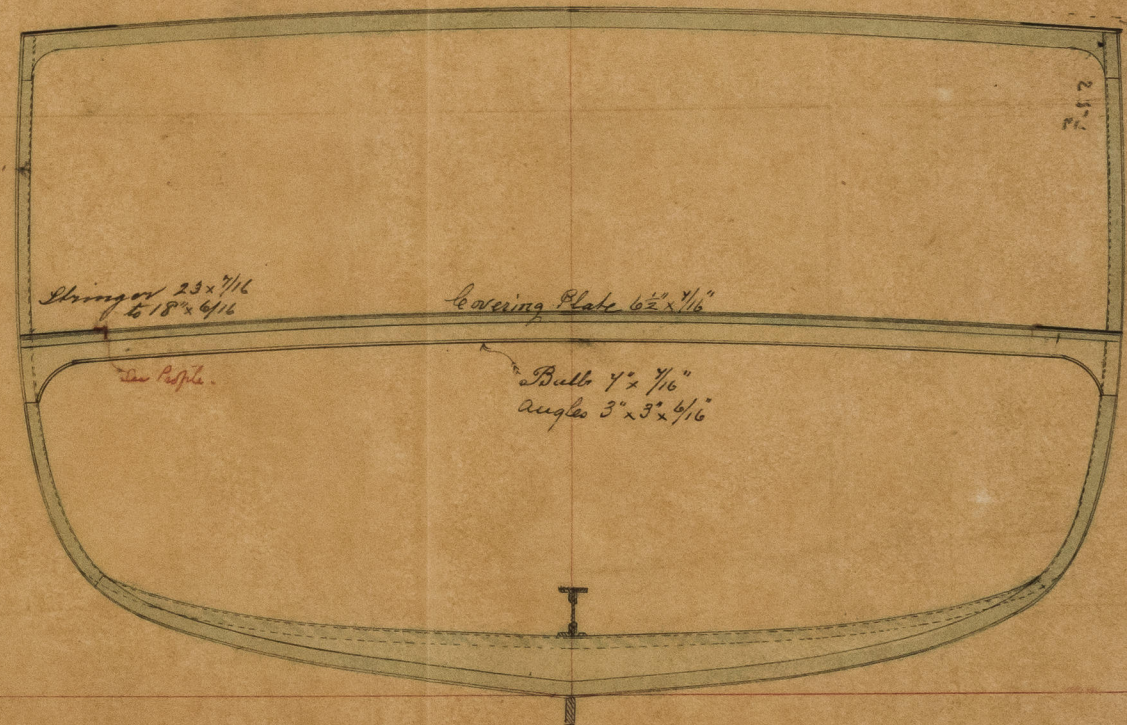

Section showing Lower Deck beam
 at Larca Bulkhead.

Lloyds
 require this
 my

RS
 31/1/77

© 2021

Lloyd's Register
 Foundation

IRON 521-0165