


TRACING N°12151

MASTS & YARDS

Barque "Luzitania" of Annapolis

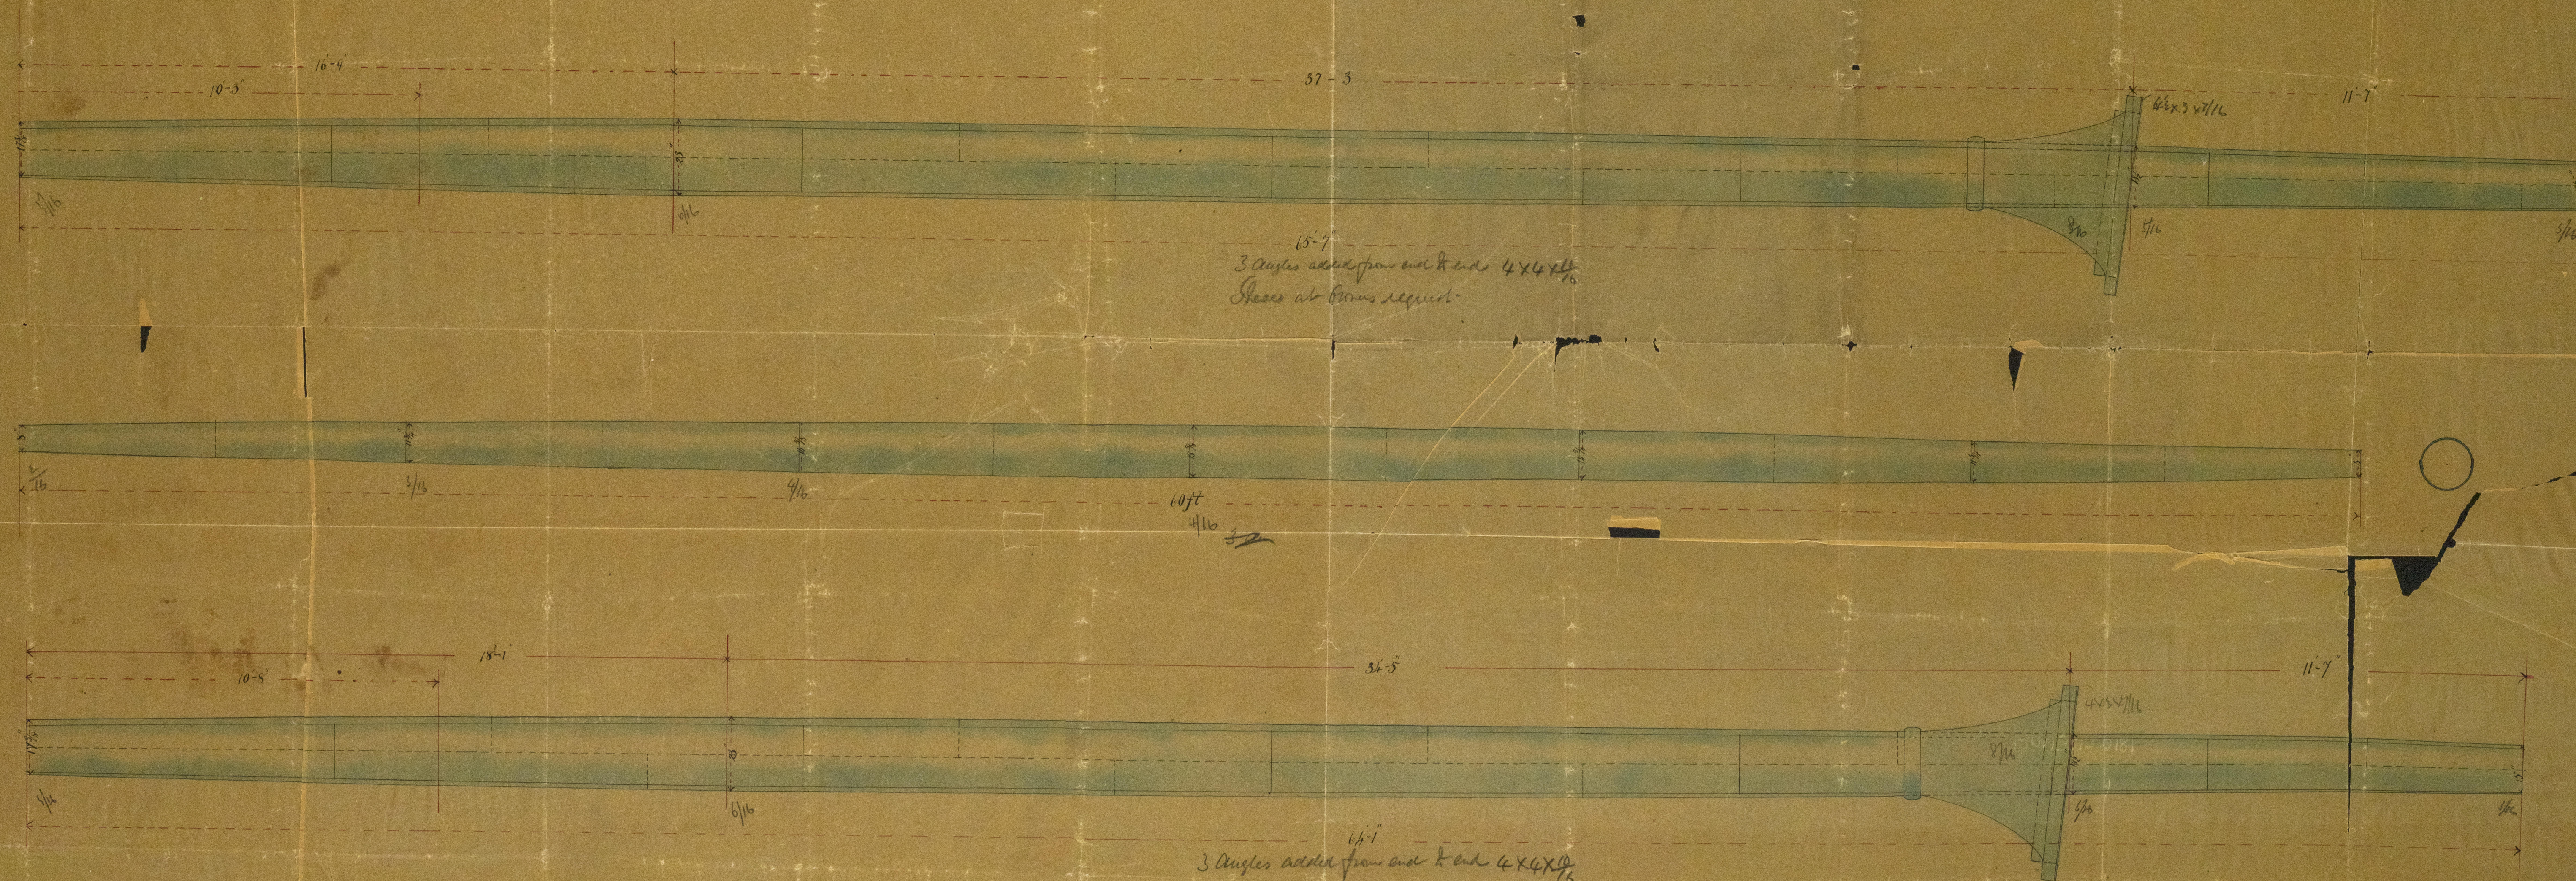

SCALE 1/2 INCH TO 1 FOOT

W. M.

P. & W. MACLELLAN
Catharine Works
GLASGOW

