

N^o 20

Sailing schooner "Emmie"

N^o of report 3851.

Midship Section
of an
Iron Schooner

Dimensions
Length B.P. 88' 0"
Breadth 22' 0"
Depth 8' 8"

23/2/77

Class 100 A1

Rev 28/2/77 & 19/9/77


Flush decked -
No Water Ballast

1/2 Girth 18.3
Depth 9.4
1/2 B/L 11.0
39.0
84
2730
3120
3393.0

Butt Head plates 4/16
" Bars 3 1/2 x 2 1/2
Rudder at head 2 1/8
" at keel 2"

Anchors & Chains

- 2 Bowers 5' 0" - exclusive of shot
- 1 Stream 1' 3" 0" - including "
- 1 Ridge 1' 0" 0" - "
- 155 Catheads 13/16 chain cable
- 90 " 8/16 Stream chain
- 90 " 3" Rope -

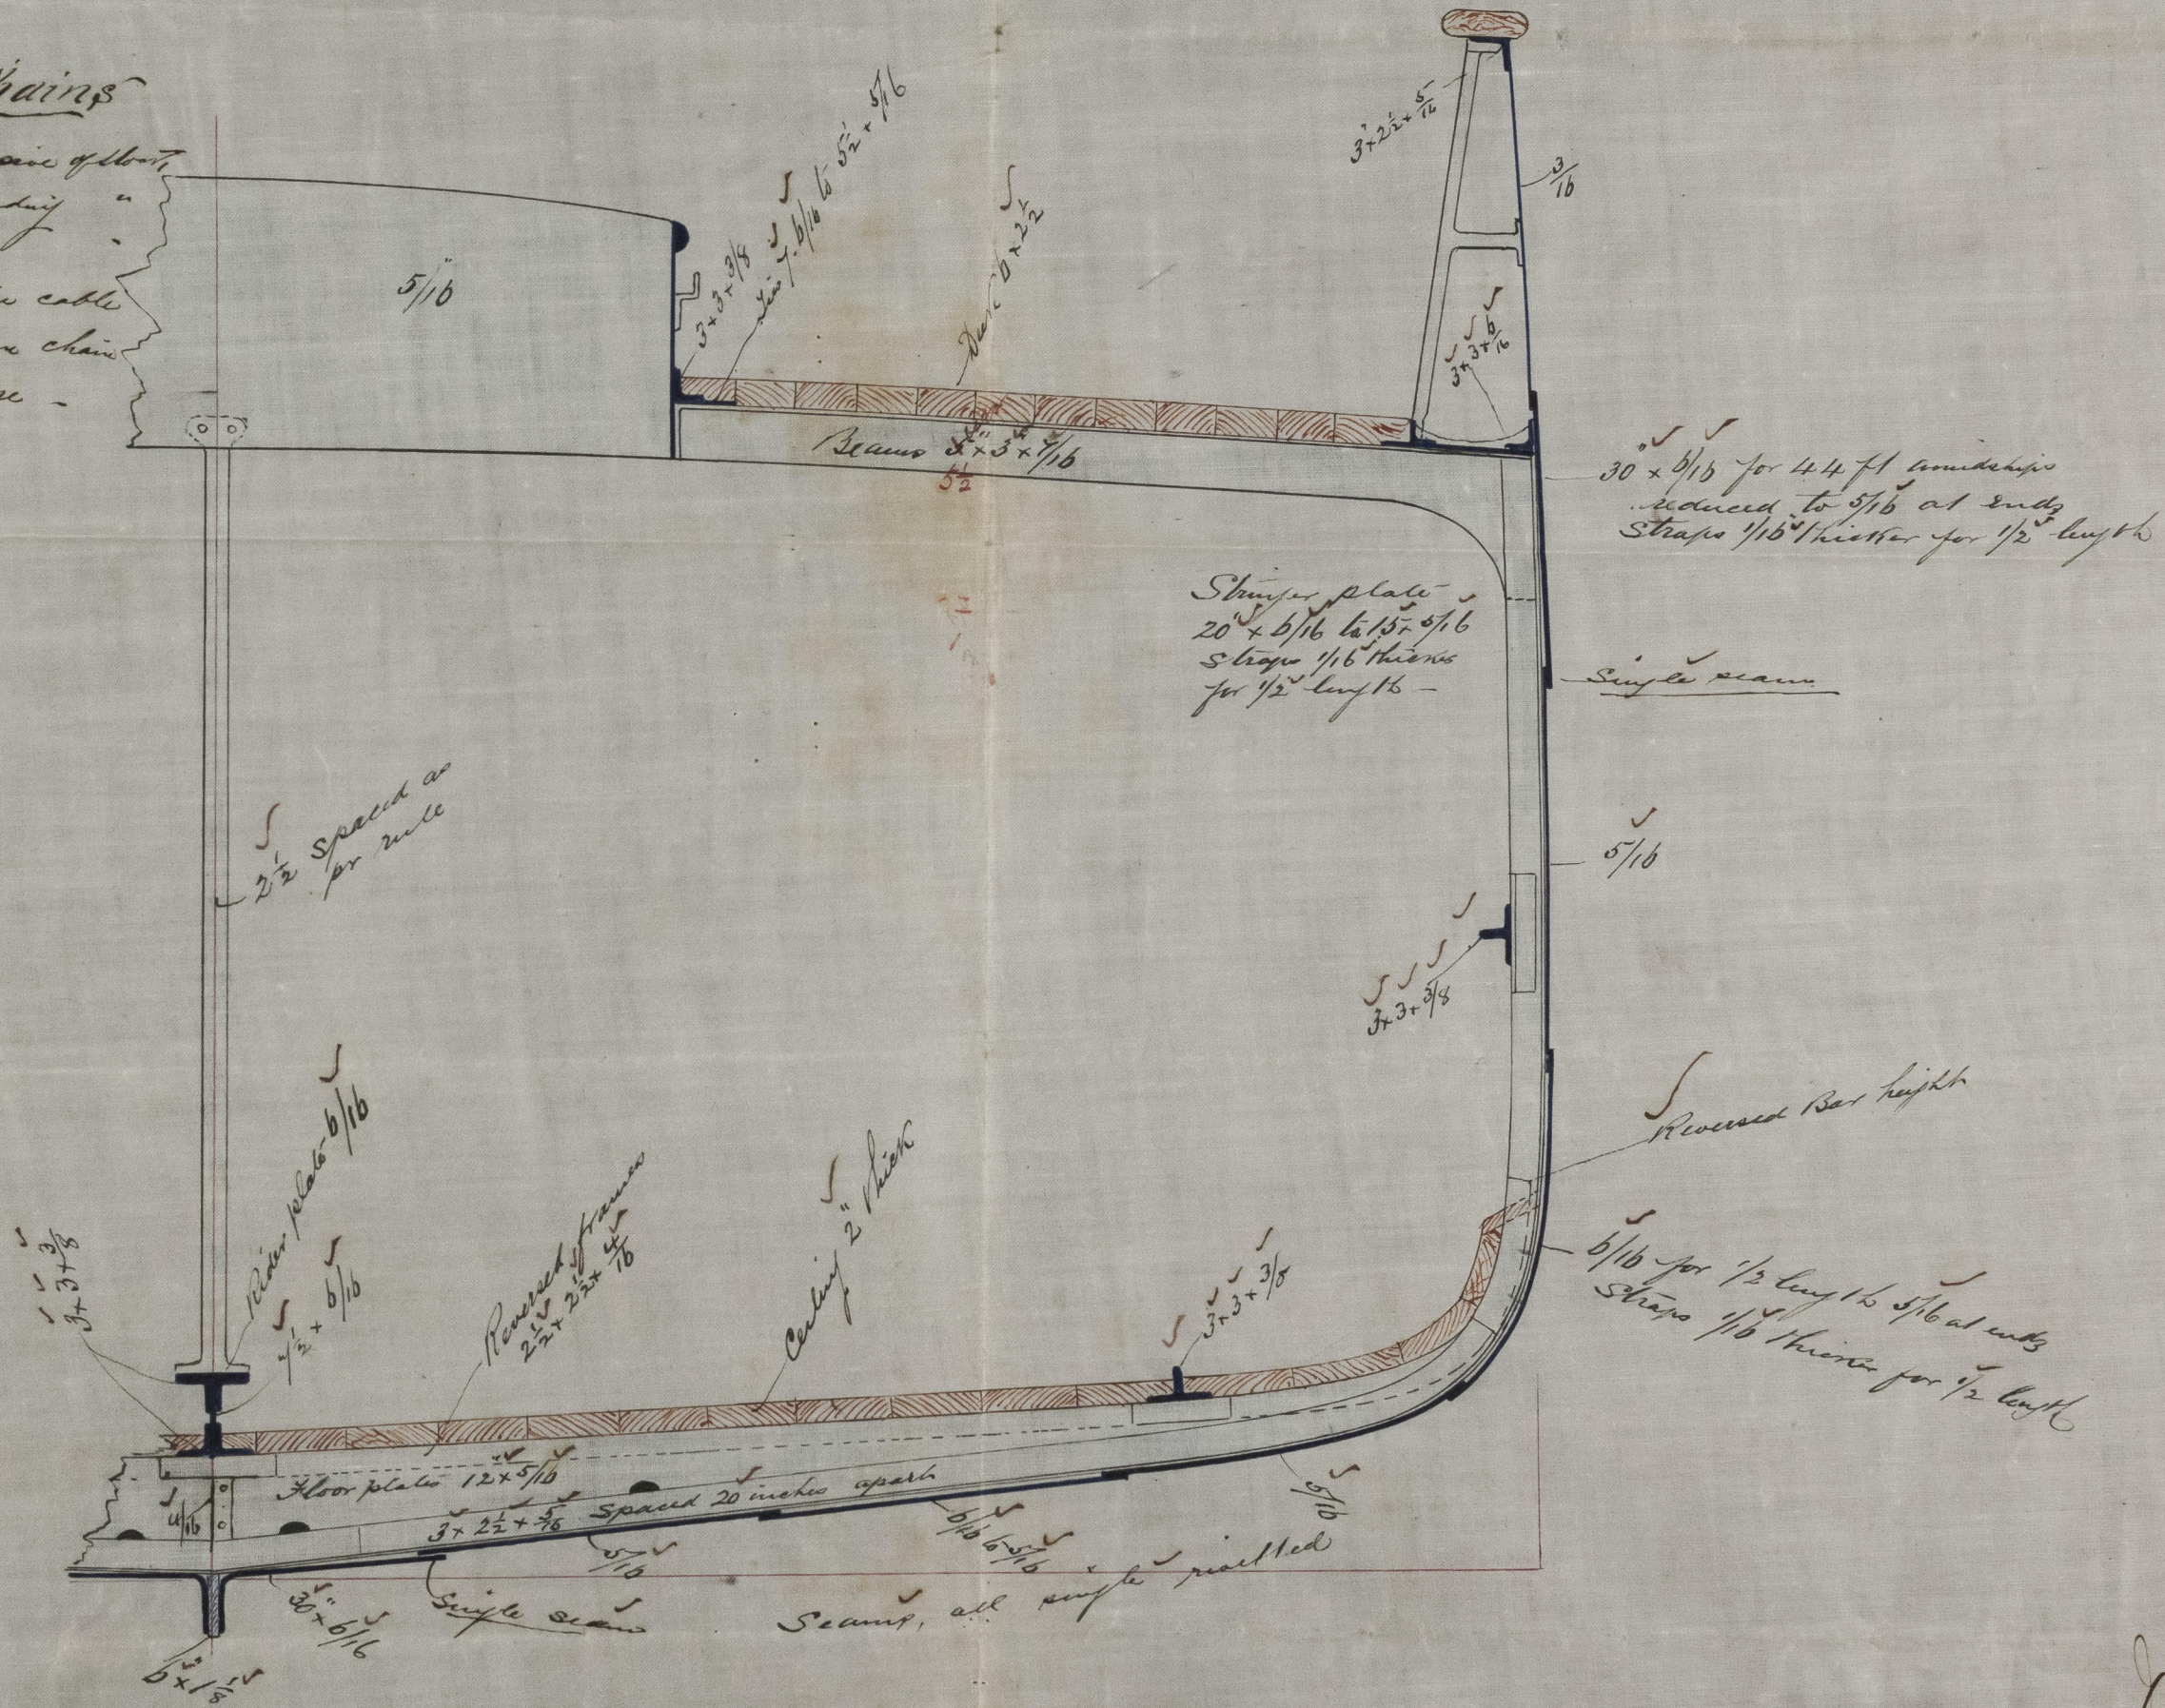

1800
23/2/77

Scale 3/4" = 1 foot

J. H. Truscott
22/2/77

R. Crapp & Sons
Iron Shipbuilding
Midland