



14/4/77

Nº 51 S.S.

Rec 13/4/77

Plan showing suction pipes & scale 1/4" = 1 foot.

Messrs. A. Timney & Co's Yard Nº 51 not yet named Report Nº 11.686. Line named "Biedley"
 Do Do Do 52 named "Hurob". Report Nº 11.746

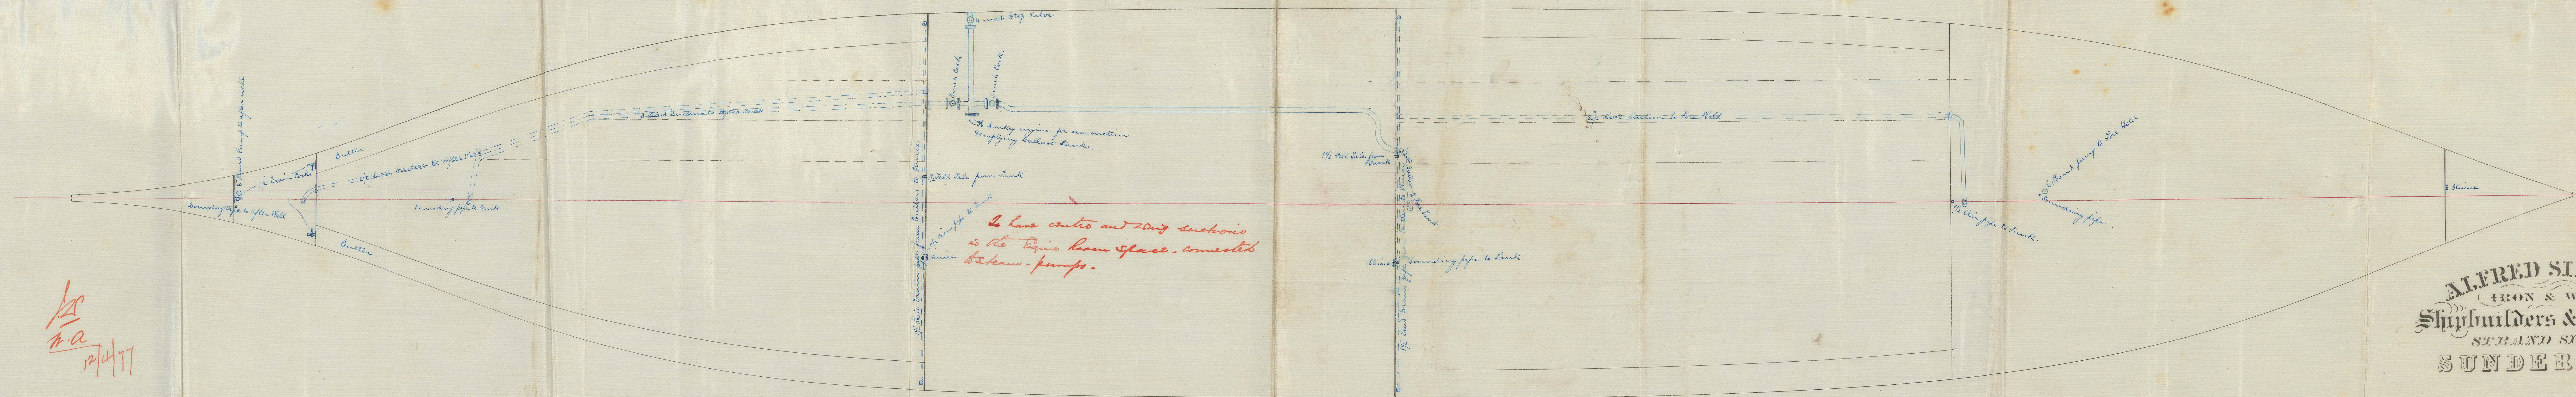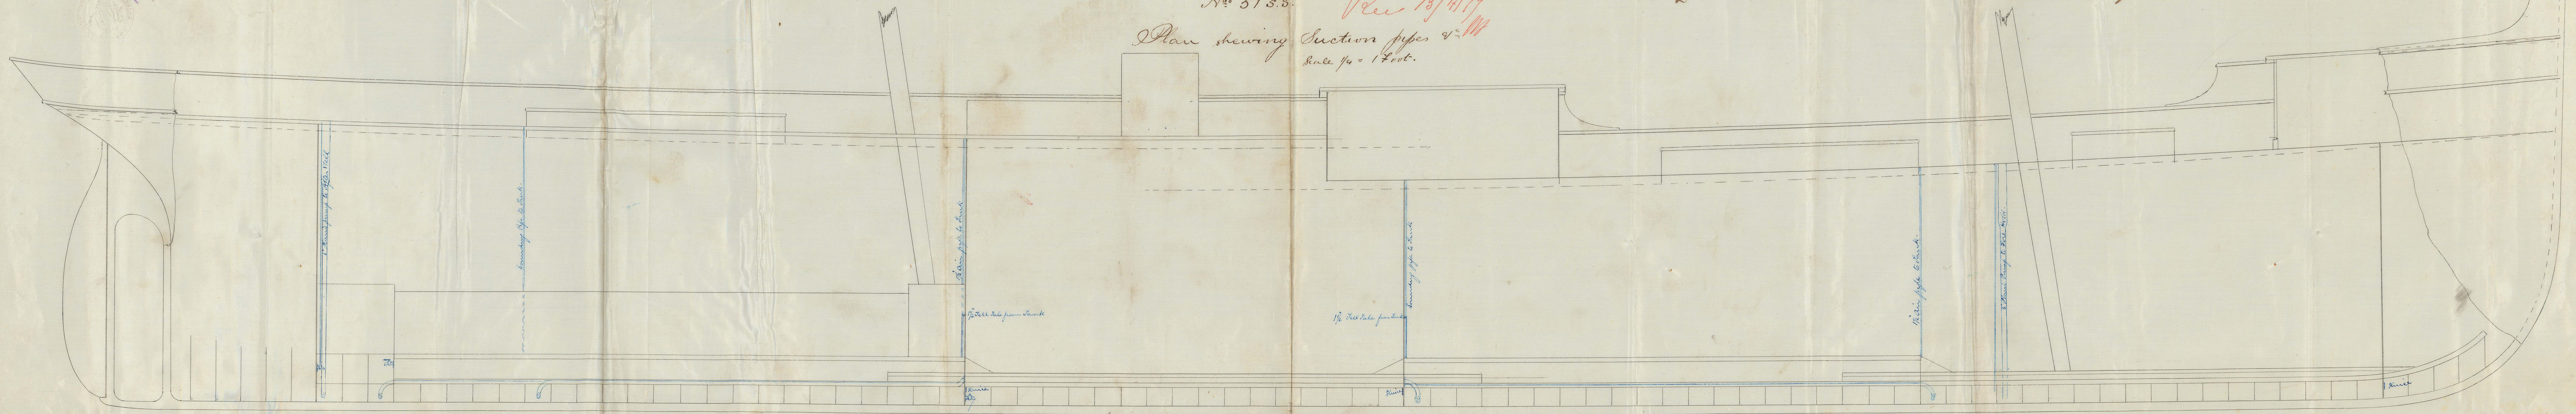

1/2
 A.A.
 12/4/77

 (IRON & WOOD)
 Shipbuilders & Repairers
 STRAND SHELWAY
 SUNDERLAND

1R00522-0019