

It is respectfully suggested that tracing cloth be used for all official drawings for their better preservation.

General Arrangement No 5192.


Scale 1/4" = 1 Foot.
See Sunderland Surveyor's letter 2/10/76 See

Rev 22/12/76 haw/1/76

Messrs. A. S. Surveyor's Grand No. 51 not yet received Report No. 11,686. named line "Bickley"
do do do 52. See Sunderland Surveyor's Report no. 11,716

ALFRED SIMP & Co
IRON & WOOD
Shipbuilders & Repairers
STRAID STURWAY
SUNDERLAND
21st Dec 1876

* Planks carried up to height of bulk 4 1/2" intercostal plate fitted.

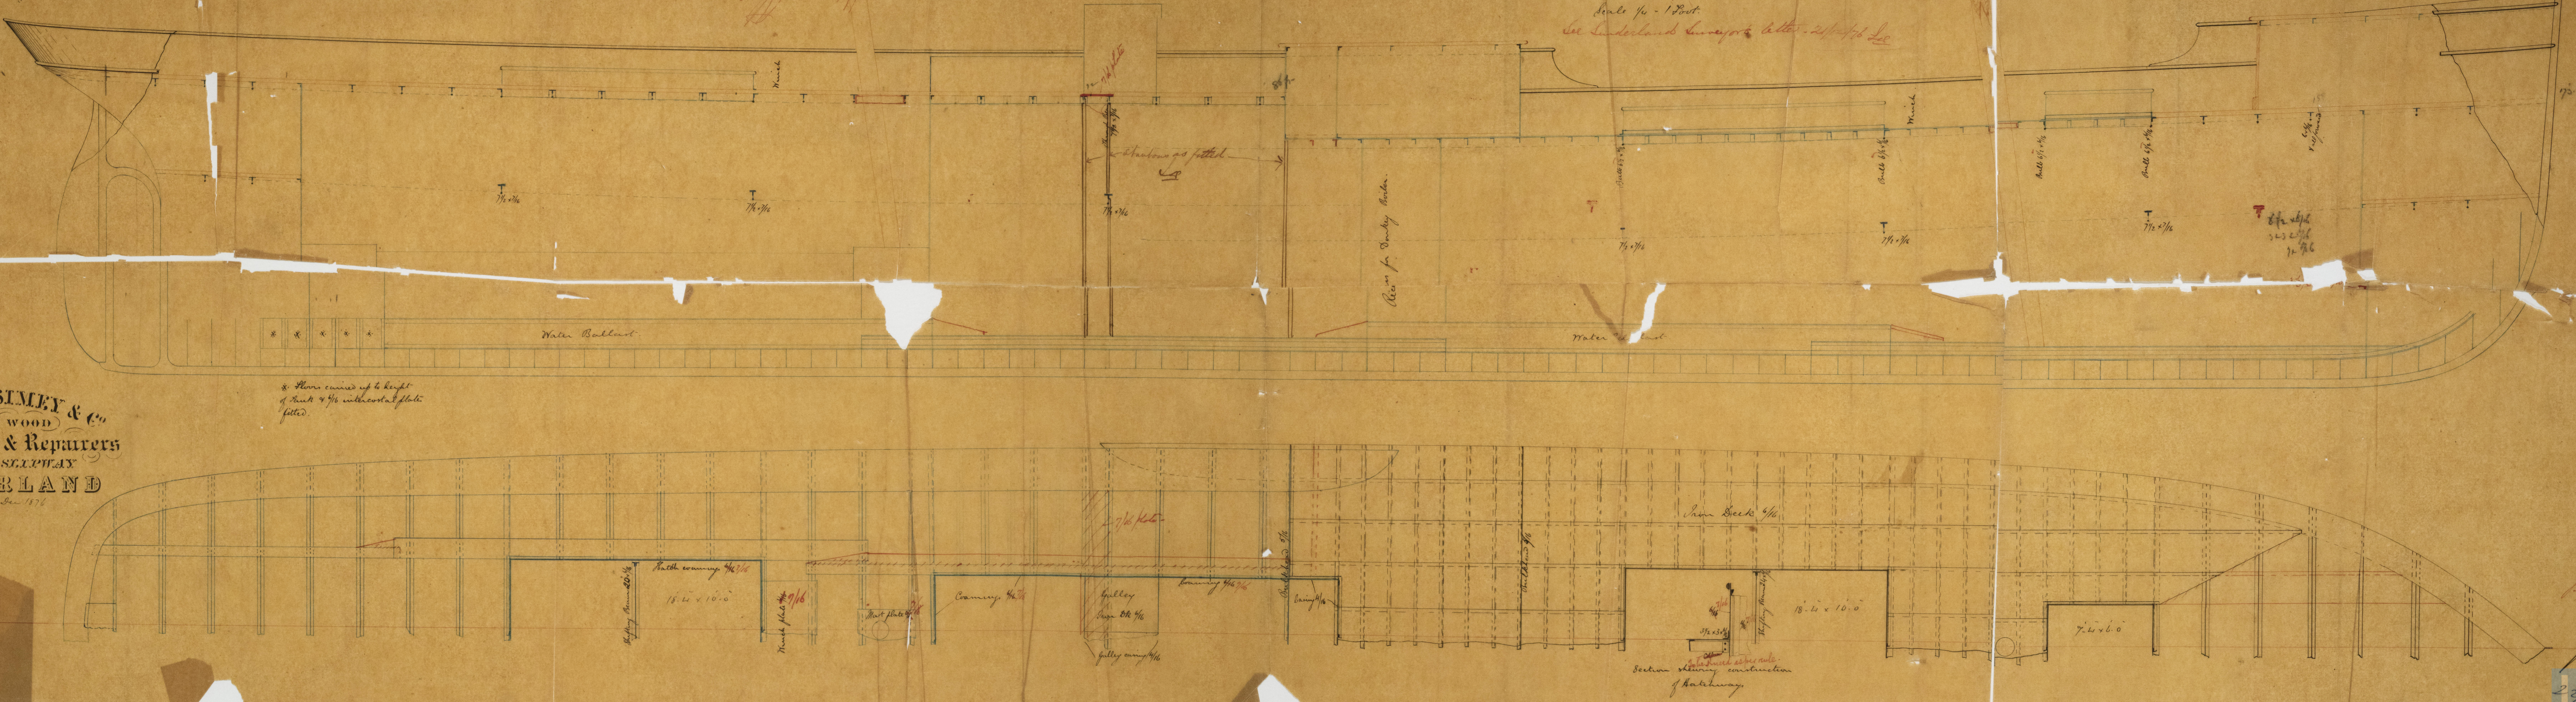

See 2/12/76

18th Dec 1876
Lloyd's Register Foundation

IRON 522-0020