


Depth to length - - - 1:12.4

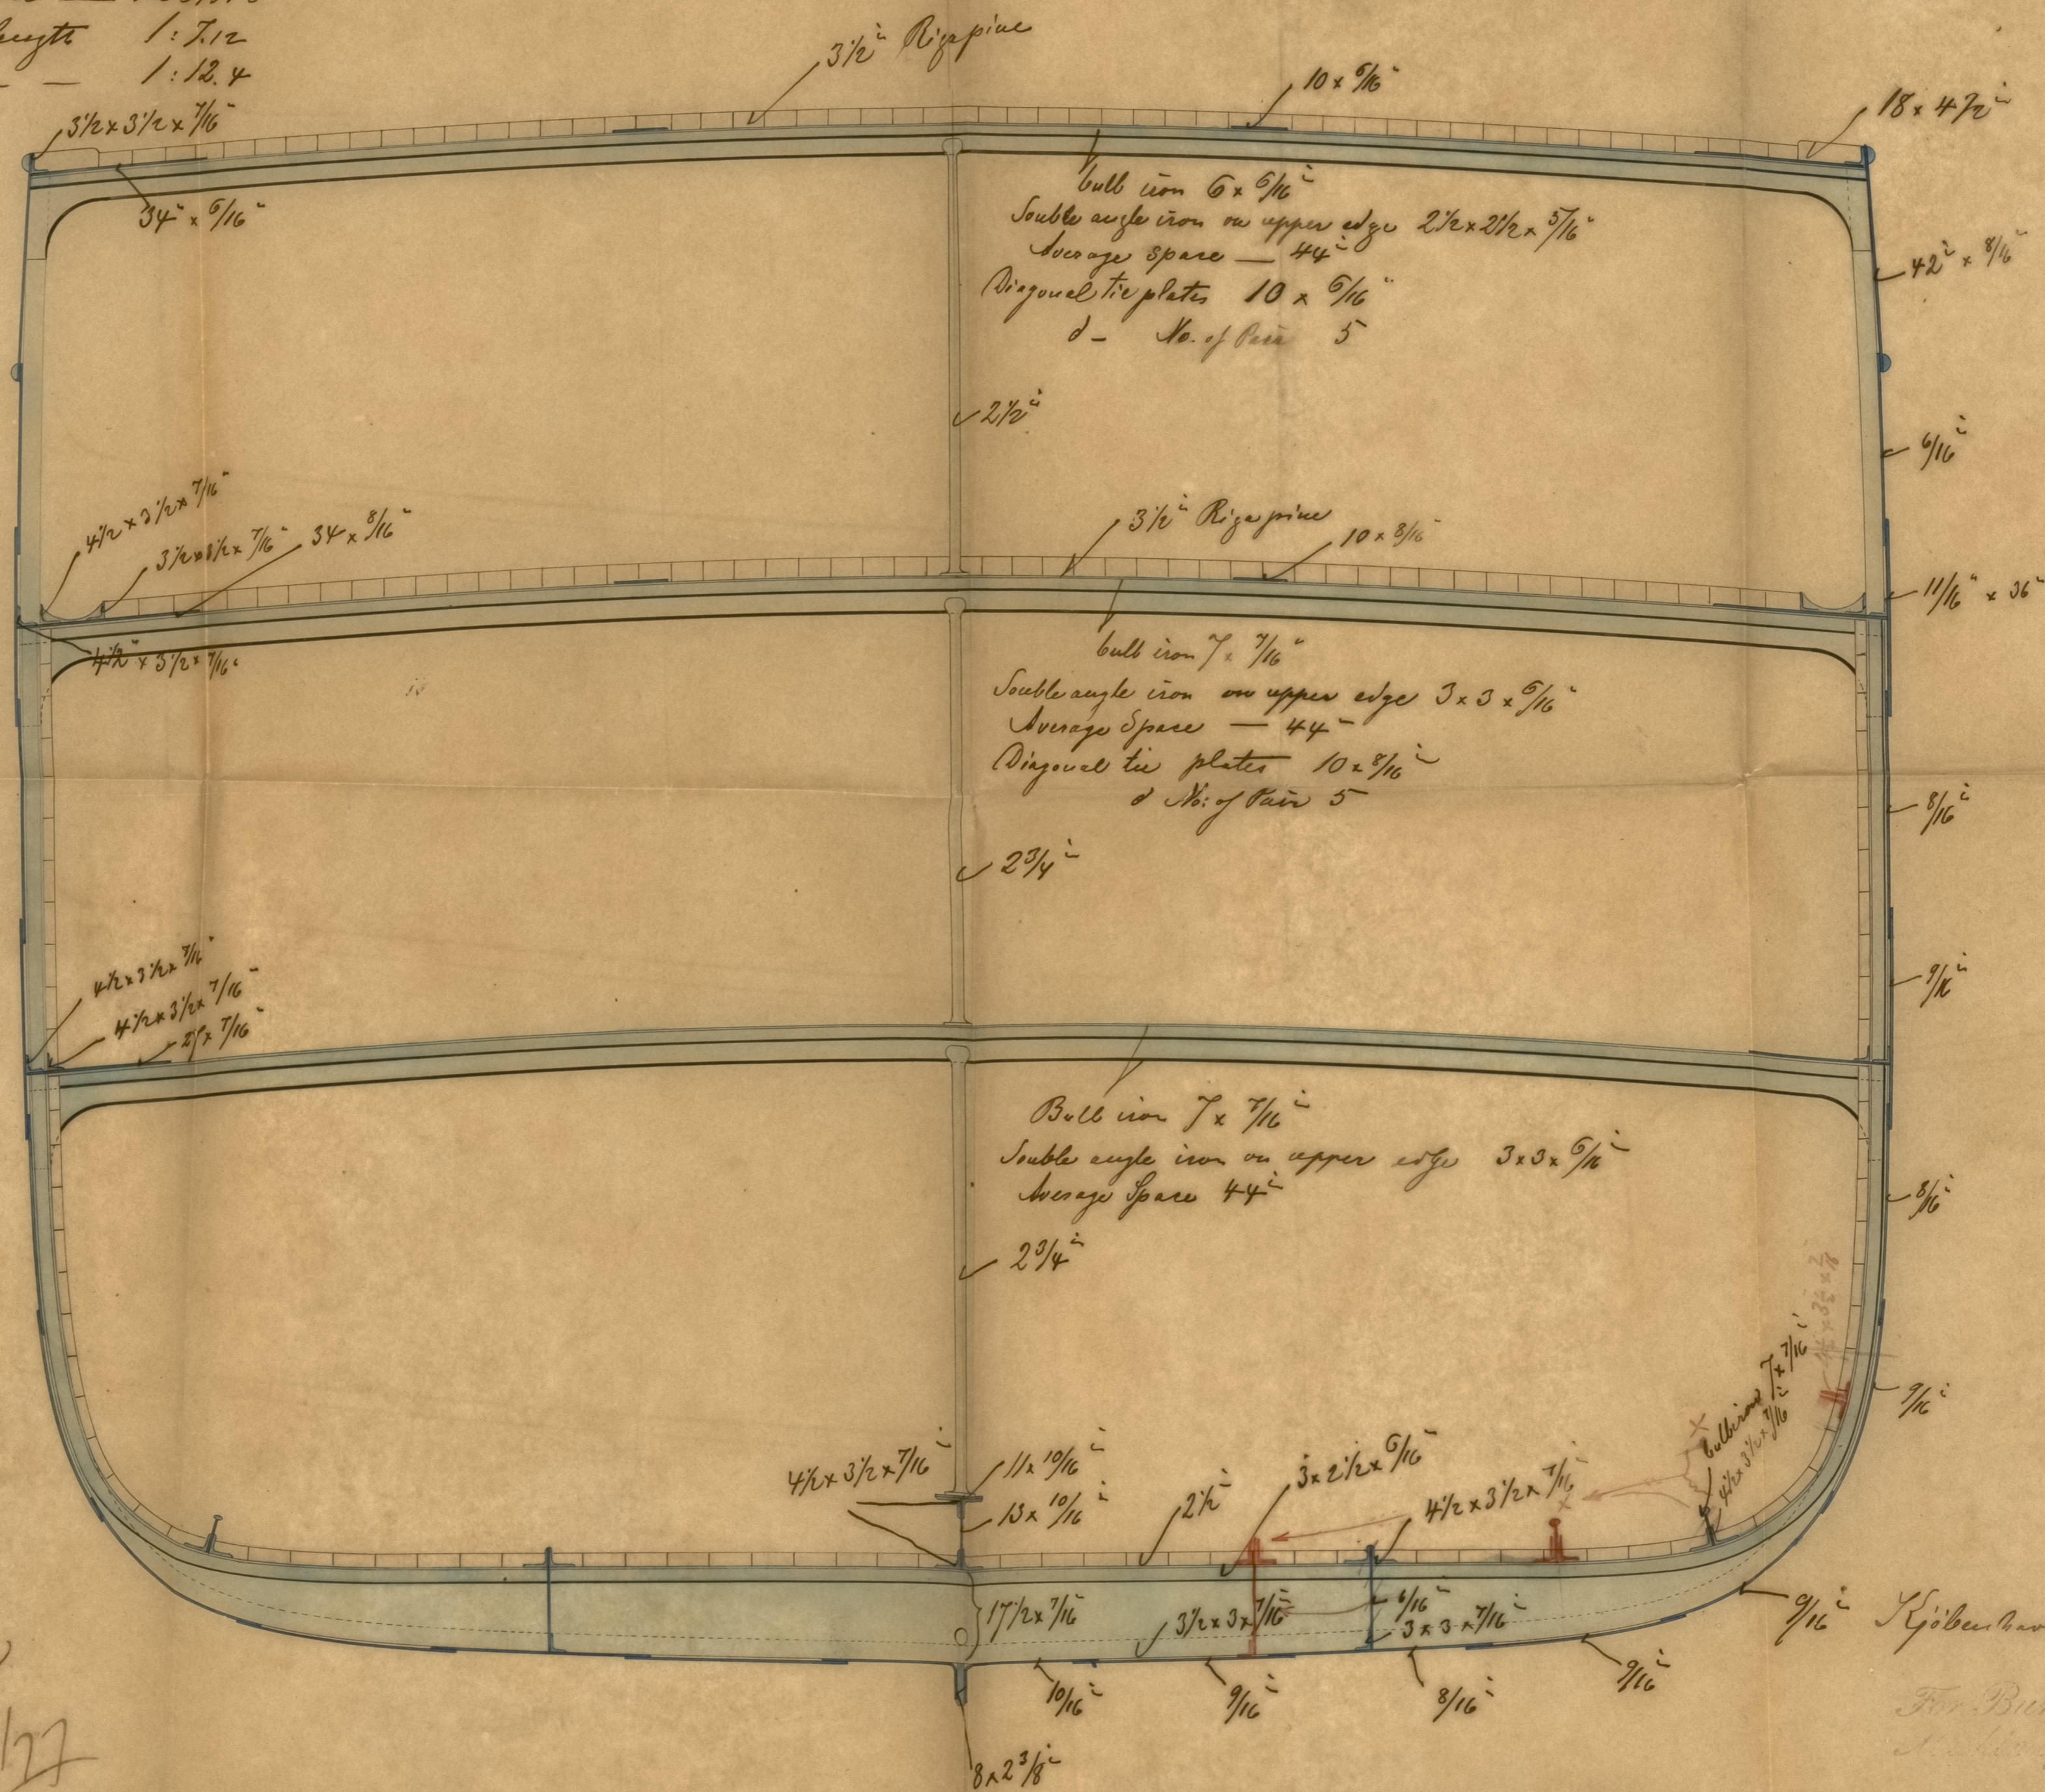

1876
12/2/77

Kjöbenhavn den Februar 1877.

13m
13/2/77
Mainy