

Duplicate

"River Laffan" Report No 2459


29/1/77

No 116 in Yard
DIMENSIONS For Lloyds

Length — — — — — 190.0
Half Beam — — — — — 15.92
Half Girth — — — — — 32.25
Depth — — — — — 21.45

— Numerals 6962 & 13227 —
— No for Outfit 141068 —
— Length — 5.89 Breadths —
do — 8.85 Depths —
— To Class 100.A.1 —
Scale $\frac{1}{4}'' = 1$ foot

Rec 29/1/77

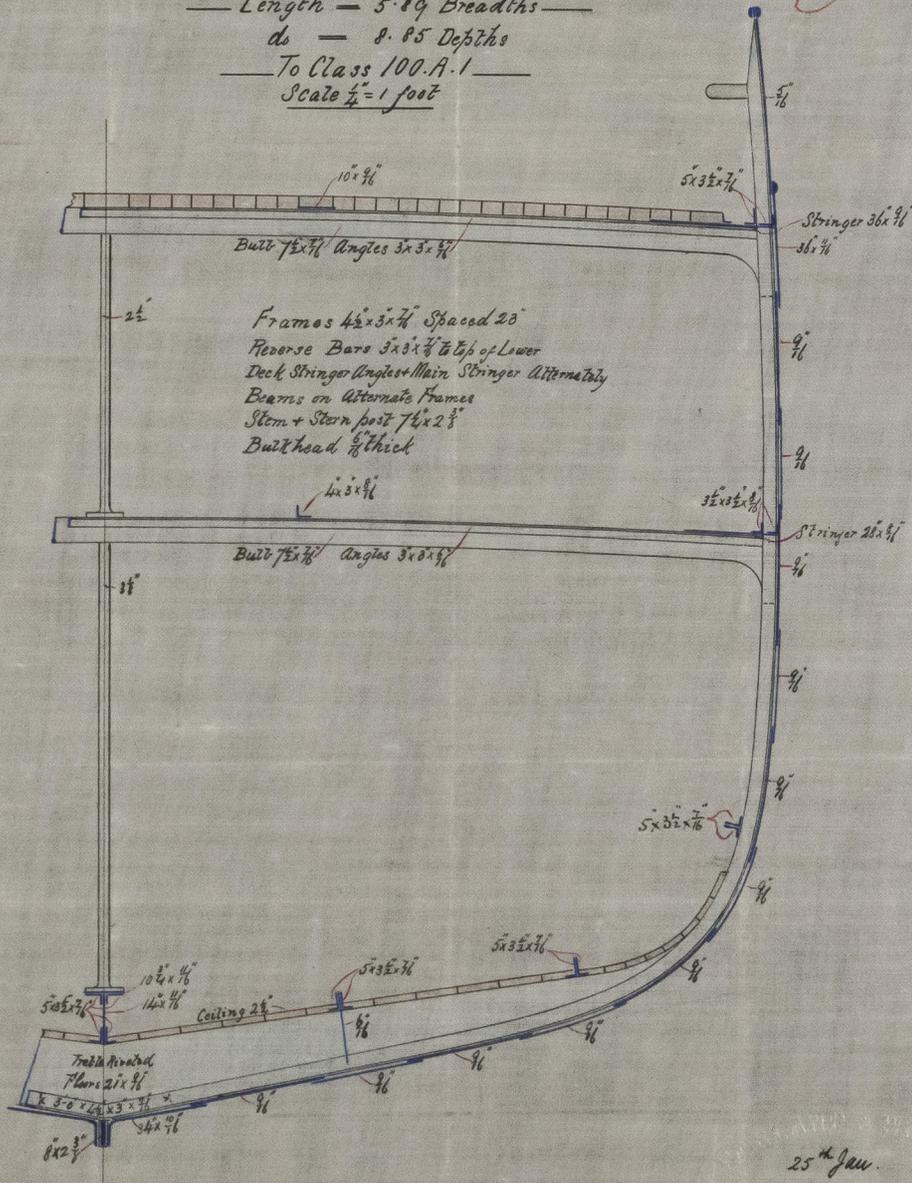

*M. V.
29/1/77*

25th Jan.

1877



*1877
© 29/1/77*

Lloyd's Register
Foundation

IRON 522-0063