



Proposed Stringer in Engine Room Space, and shows what is proposed in line of Weld Beams - that an angle iron 10 x 10 x 1/2 with a face plate 10 x 1/2 running from Bulkhead to Bulkhead -

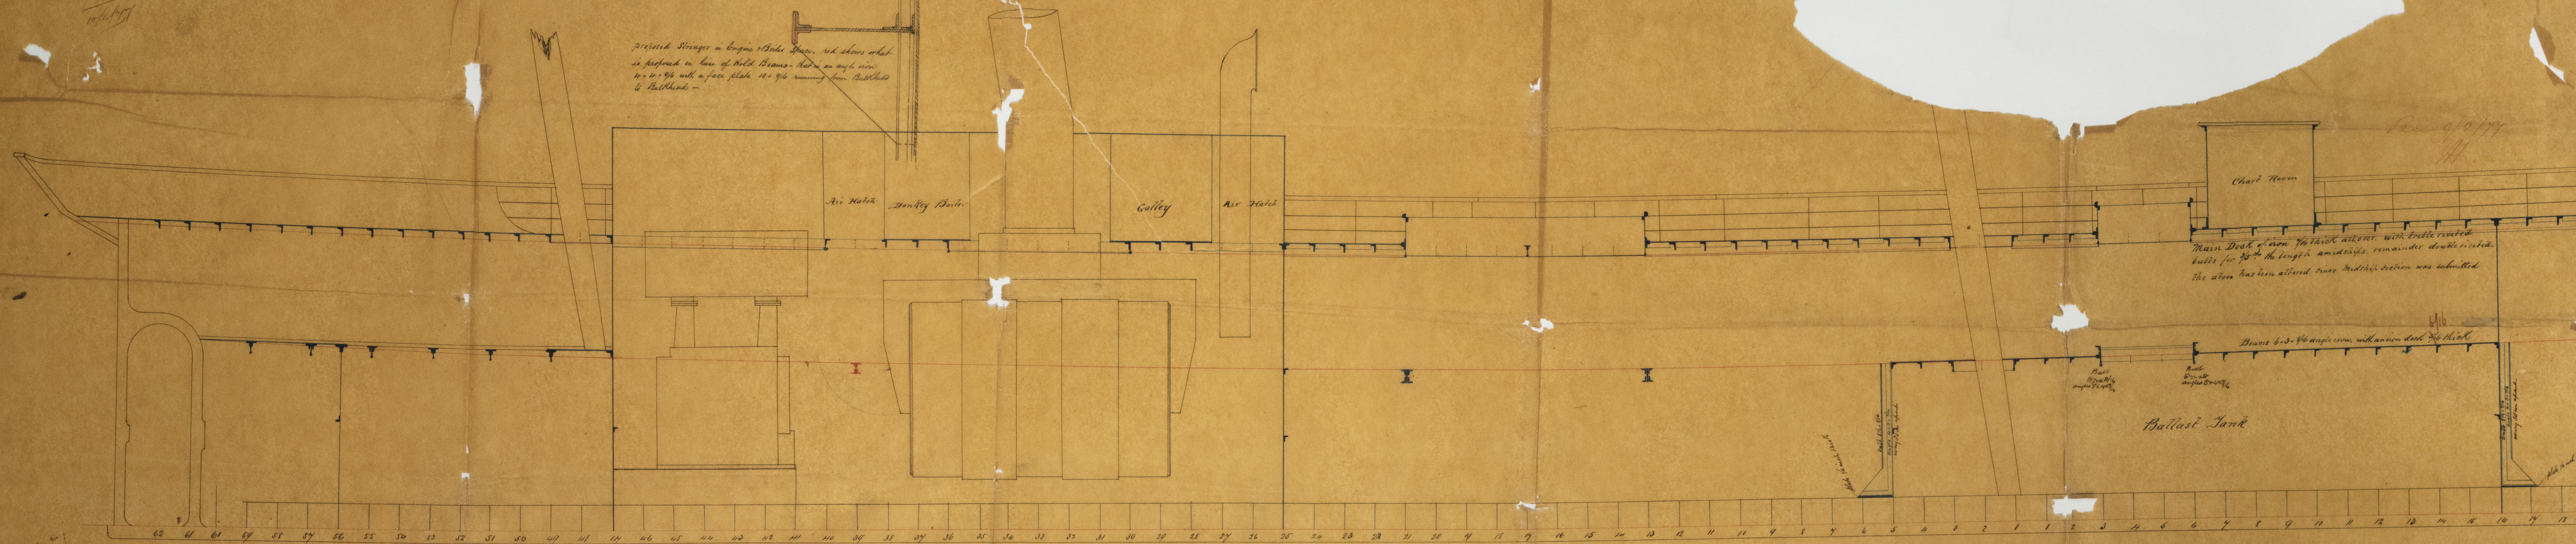

IRON 522-0073 1/2

S.S. SUMMERLEE  
*Design Report No. 159*

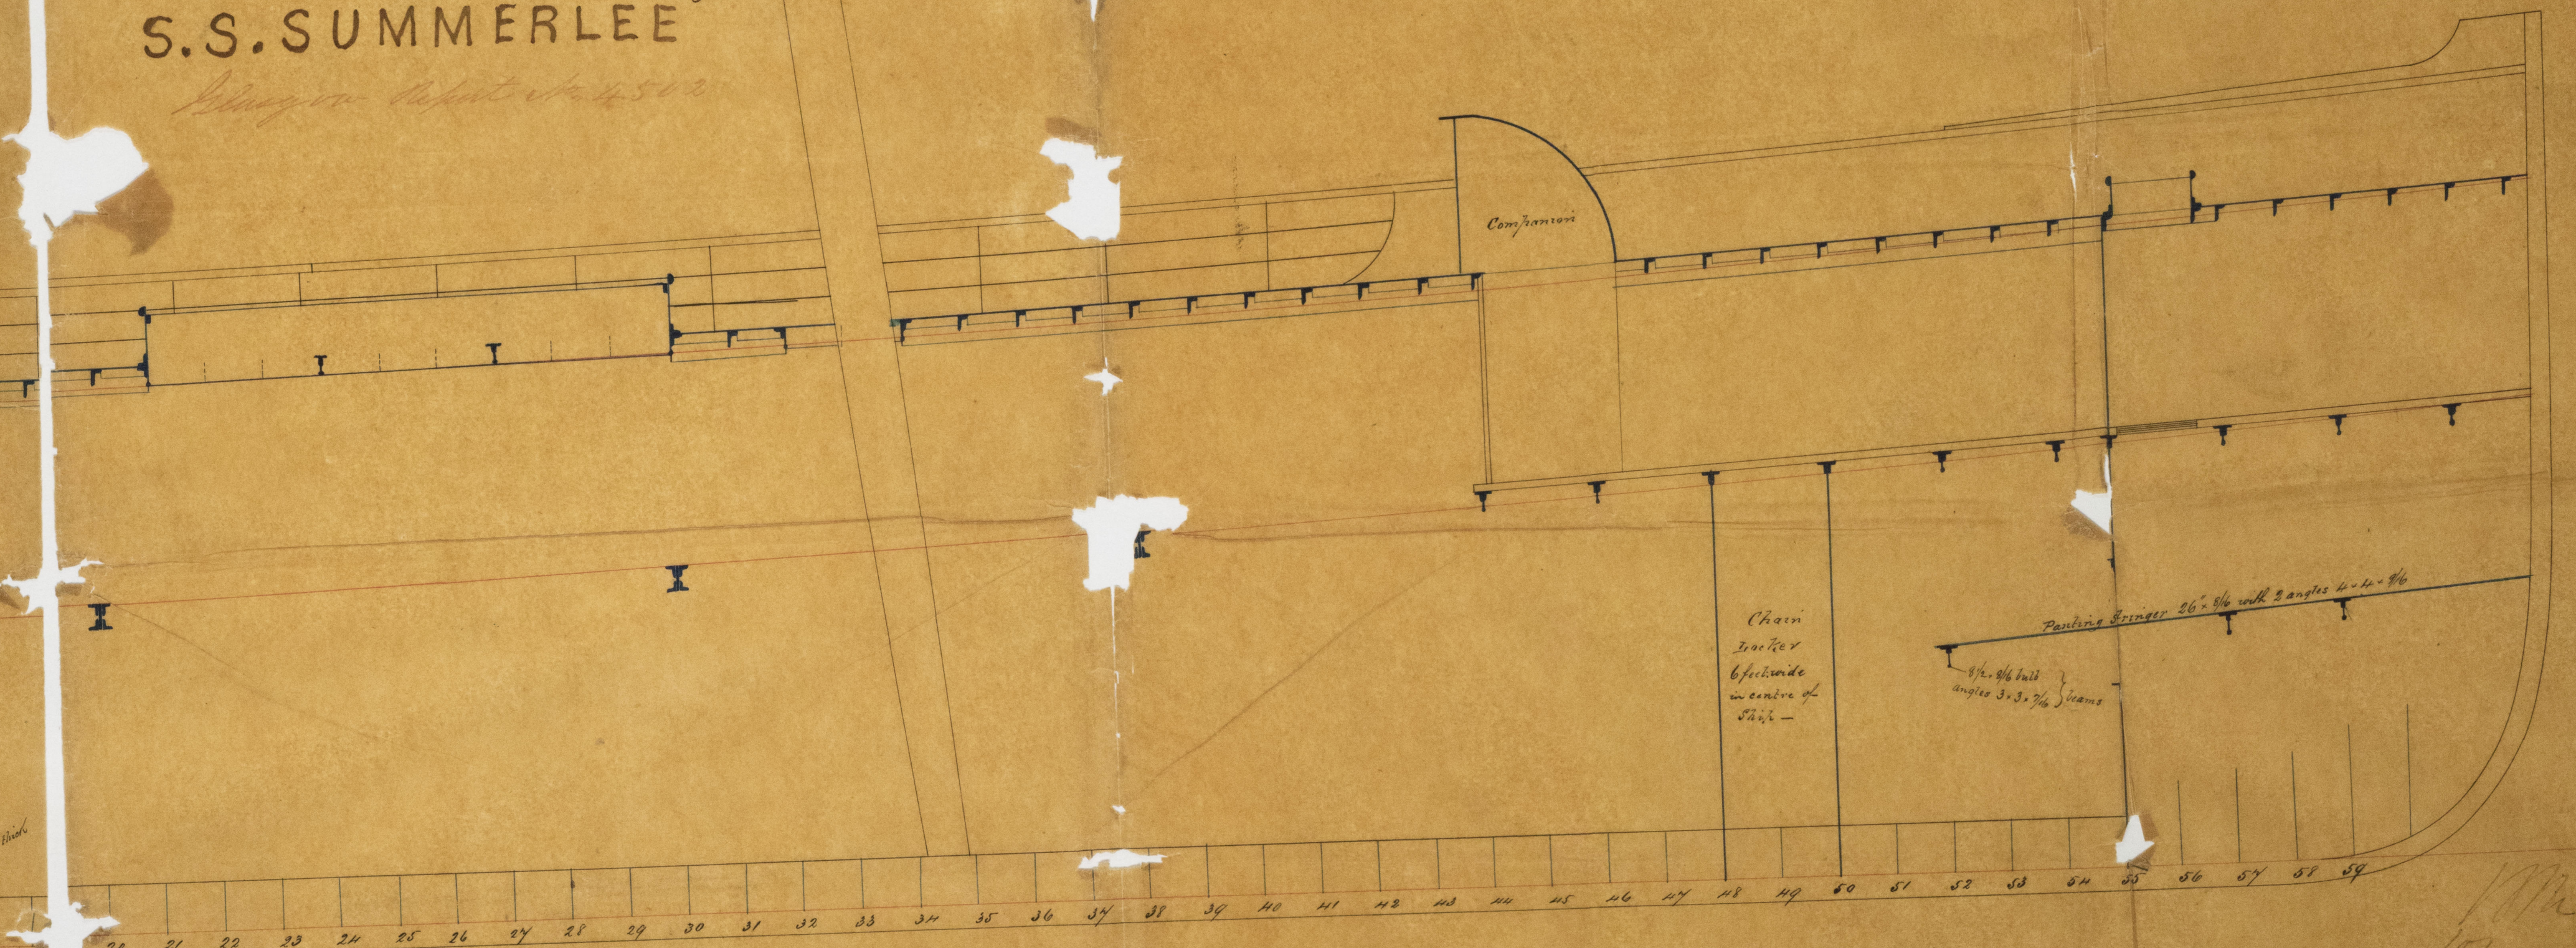

No. 159 Boat  
 Scale 1/4 inch = one foot

IRON 522-0073 1/2

