


"Lanadarae". Report No 12647

Rec 20/11/76 & 29/11/76

21/4/76

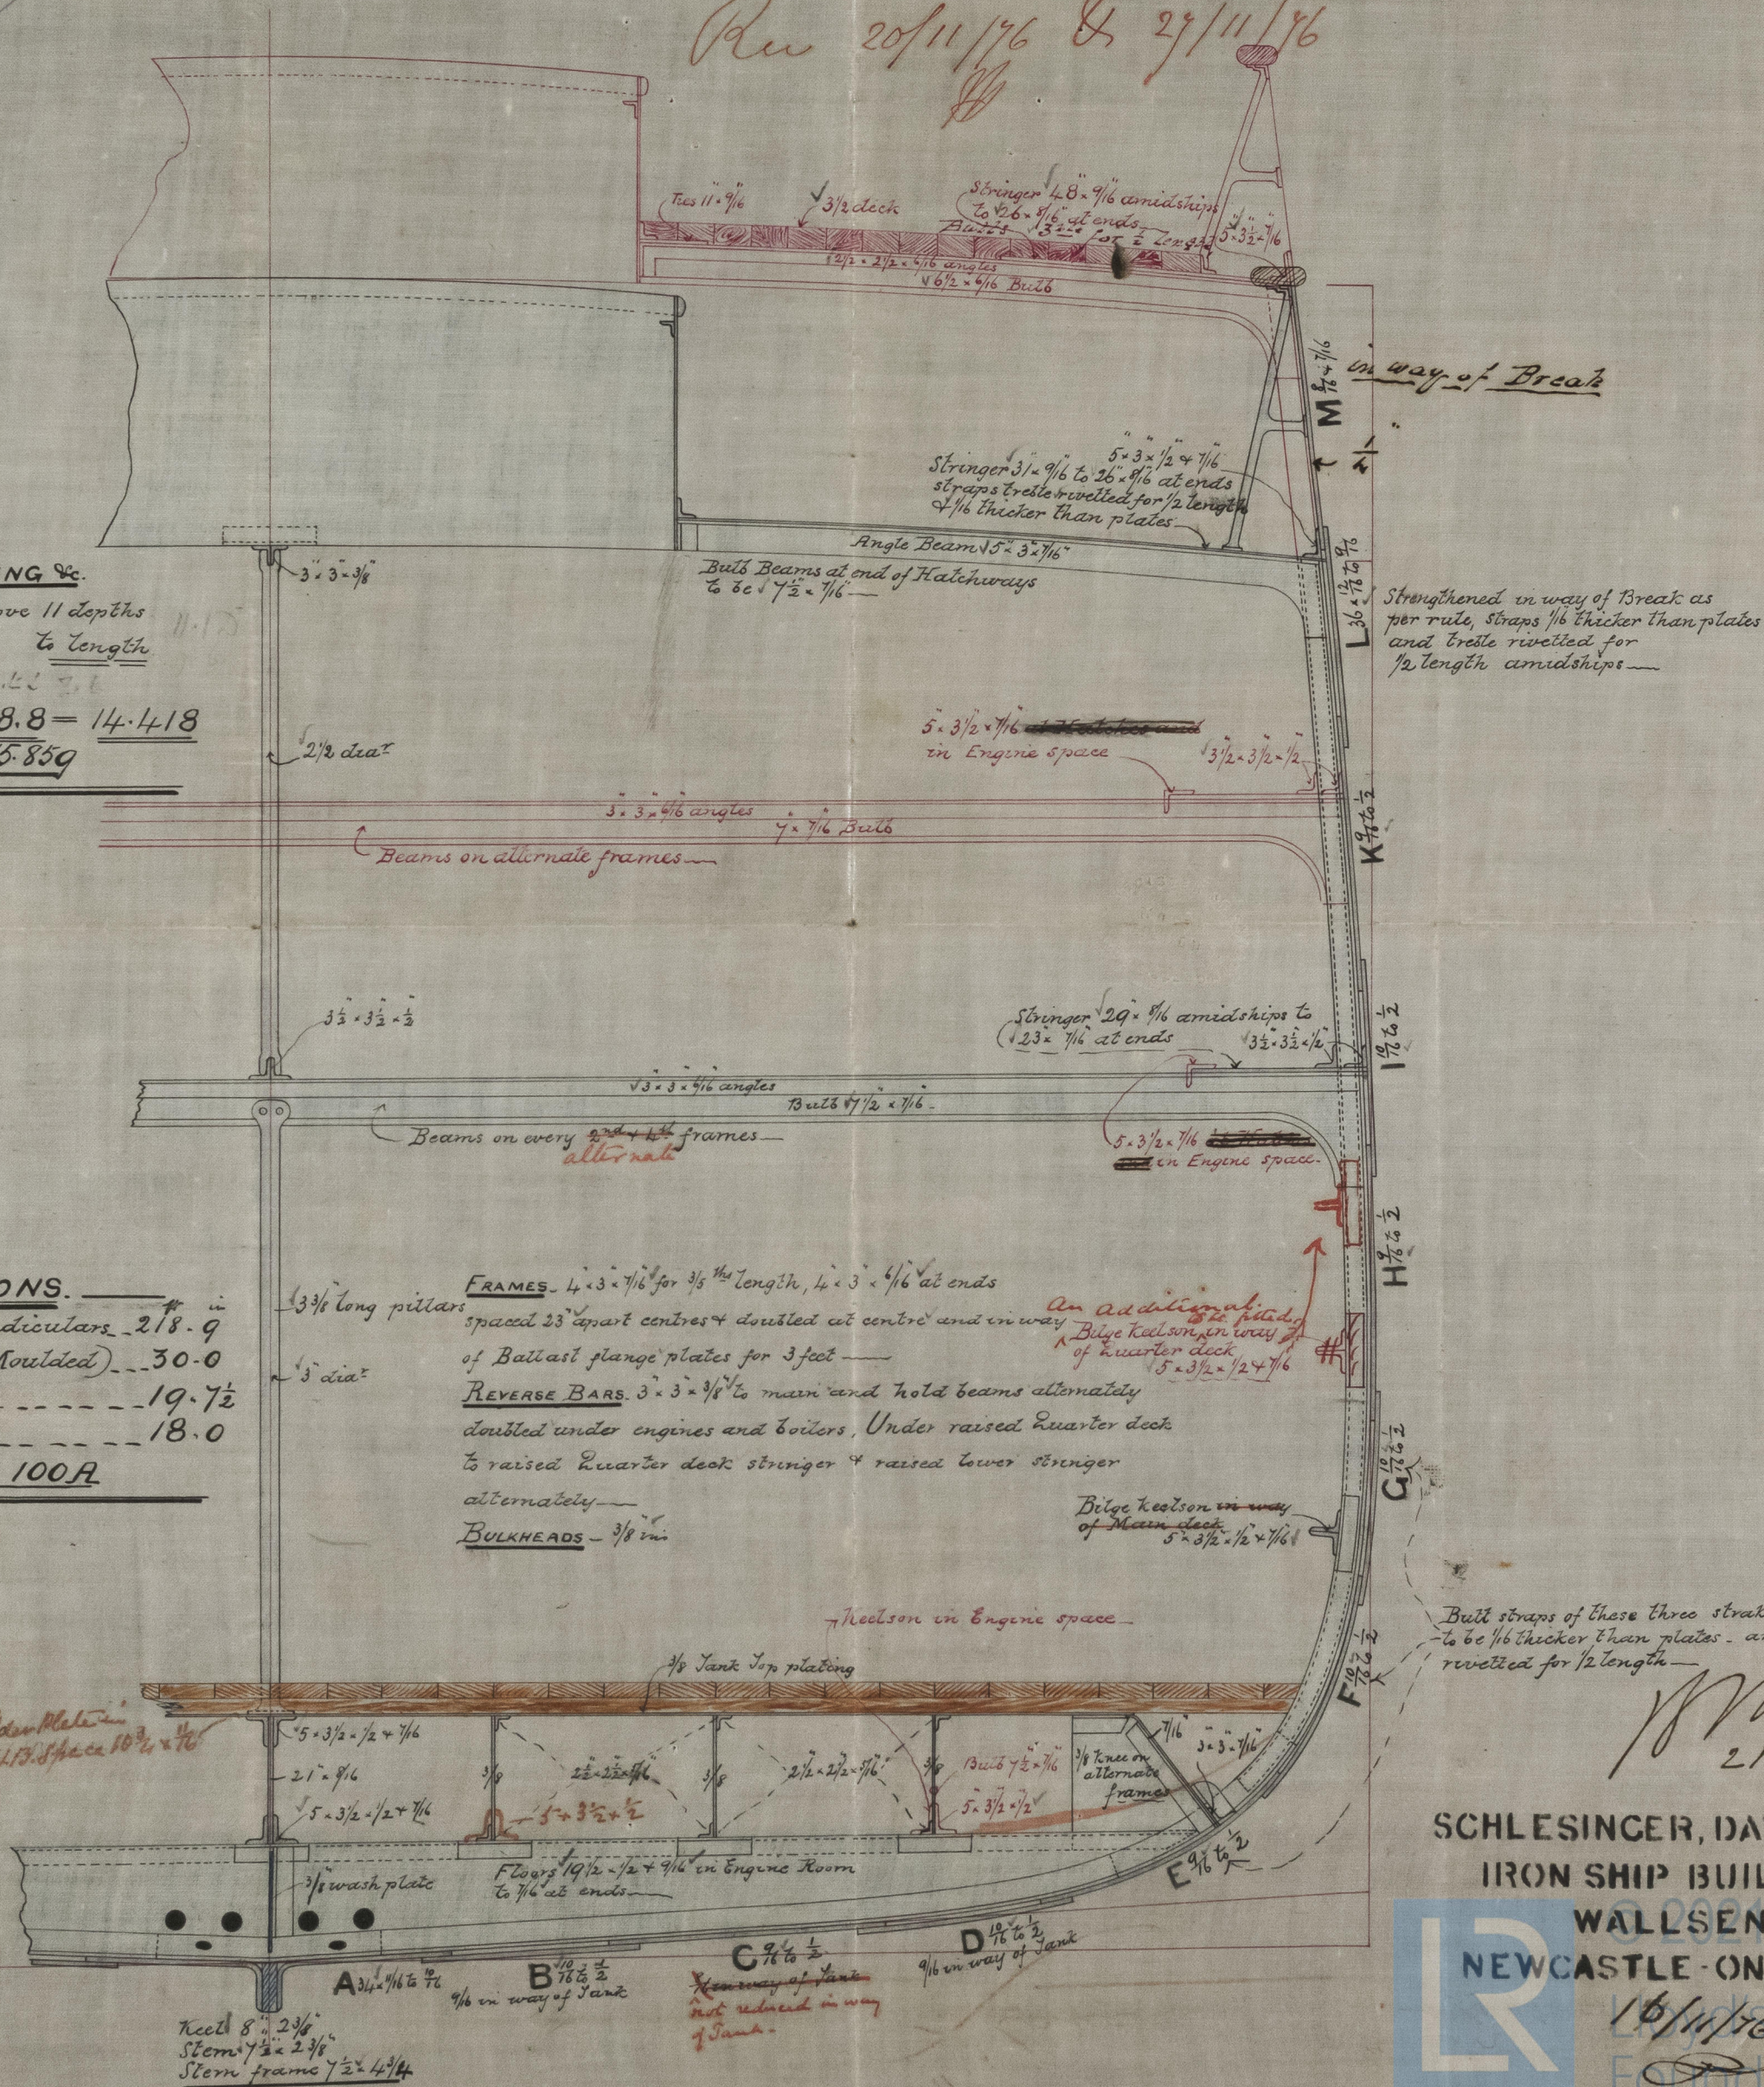

SCHLESINGER, DAVIS & CO
IRON SHIP BUILDERS,
WALLSEND,
NEWCASTLE-ON-TYNE

16/11/76 C.W.B.

1E0N522- 0082