


Midship Section

S. S. Cuba <sup>not</sup> "Earl Beaconsfield"  
Scale  $\frac{1}{2}$ " = 1 Foot  
Bull B64

Scale  $\frac{1}{2}'' = 1 \text{ Foot}$

Rec 1. 111 4/5

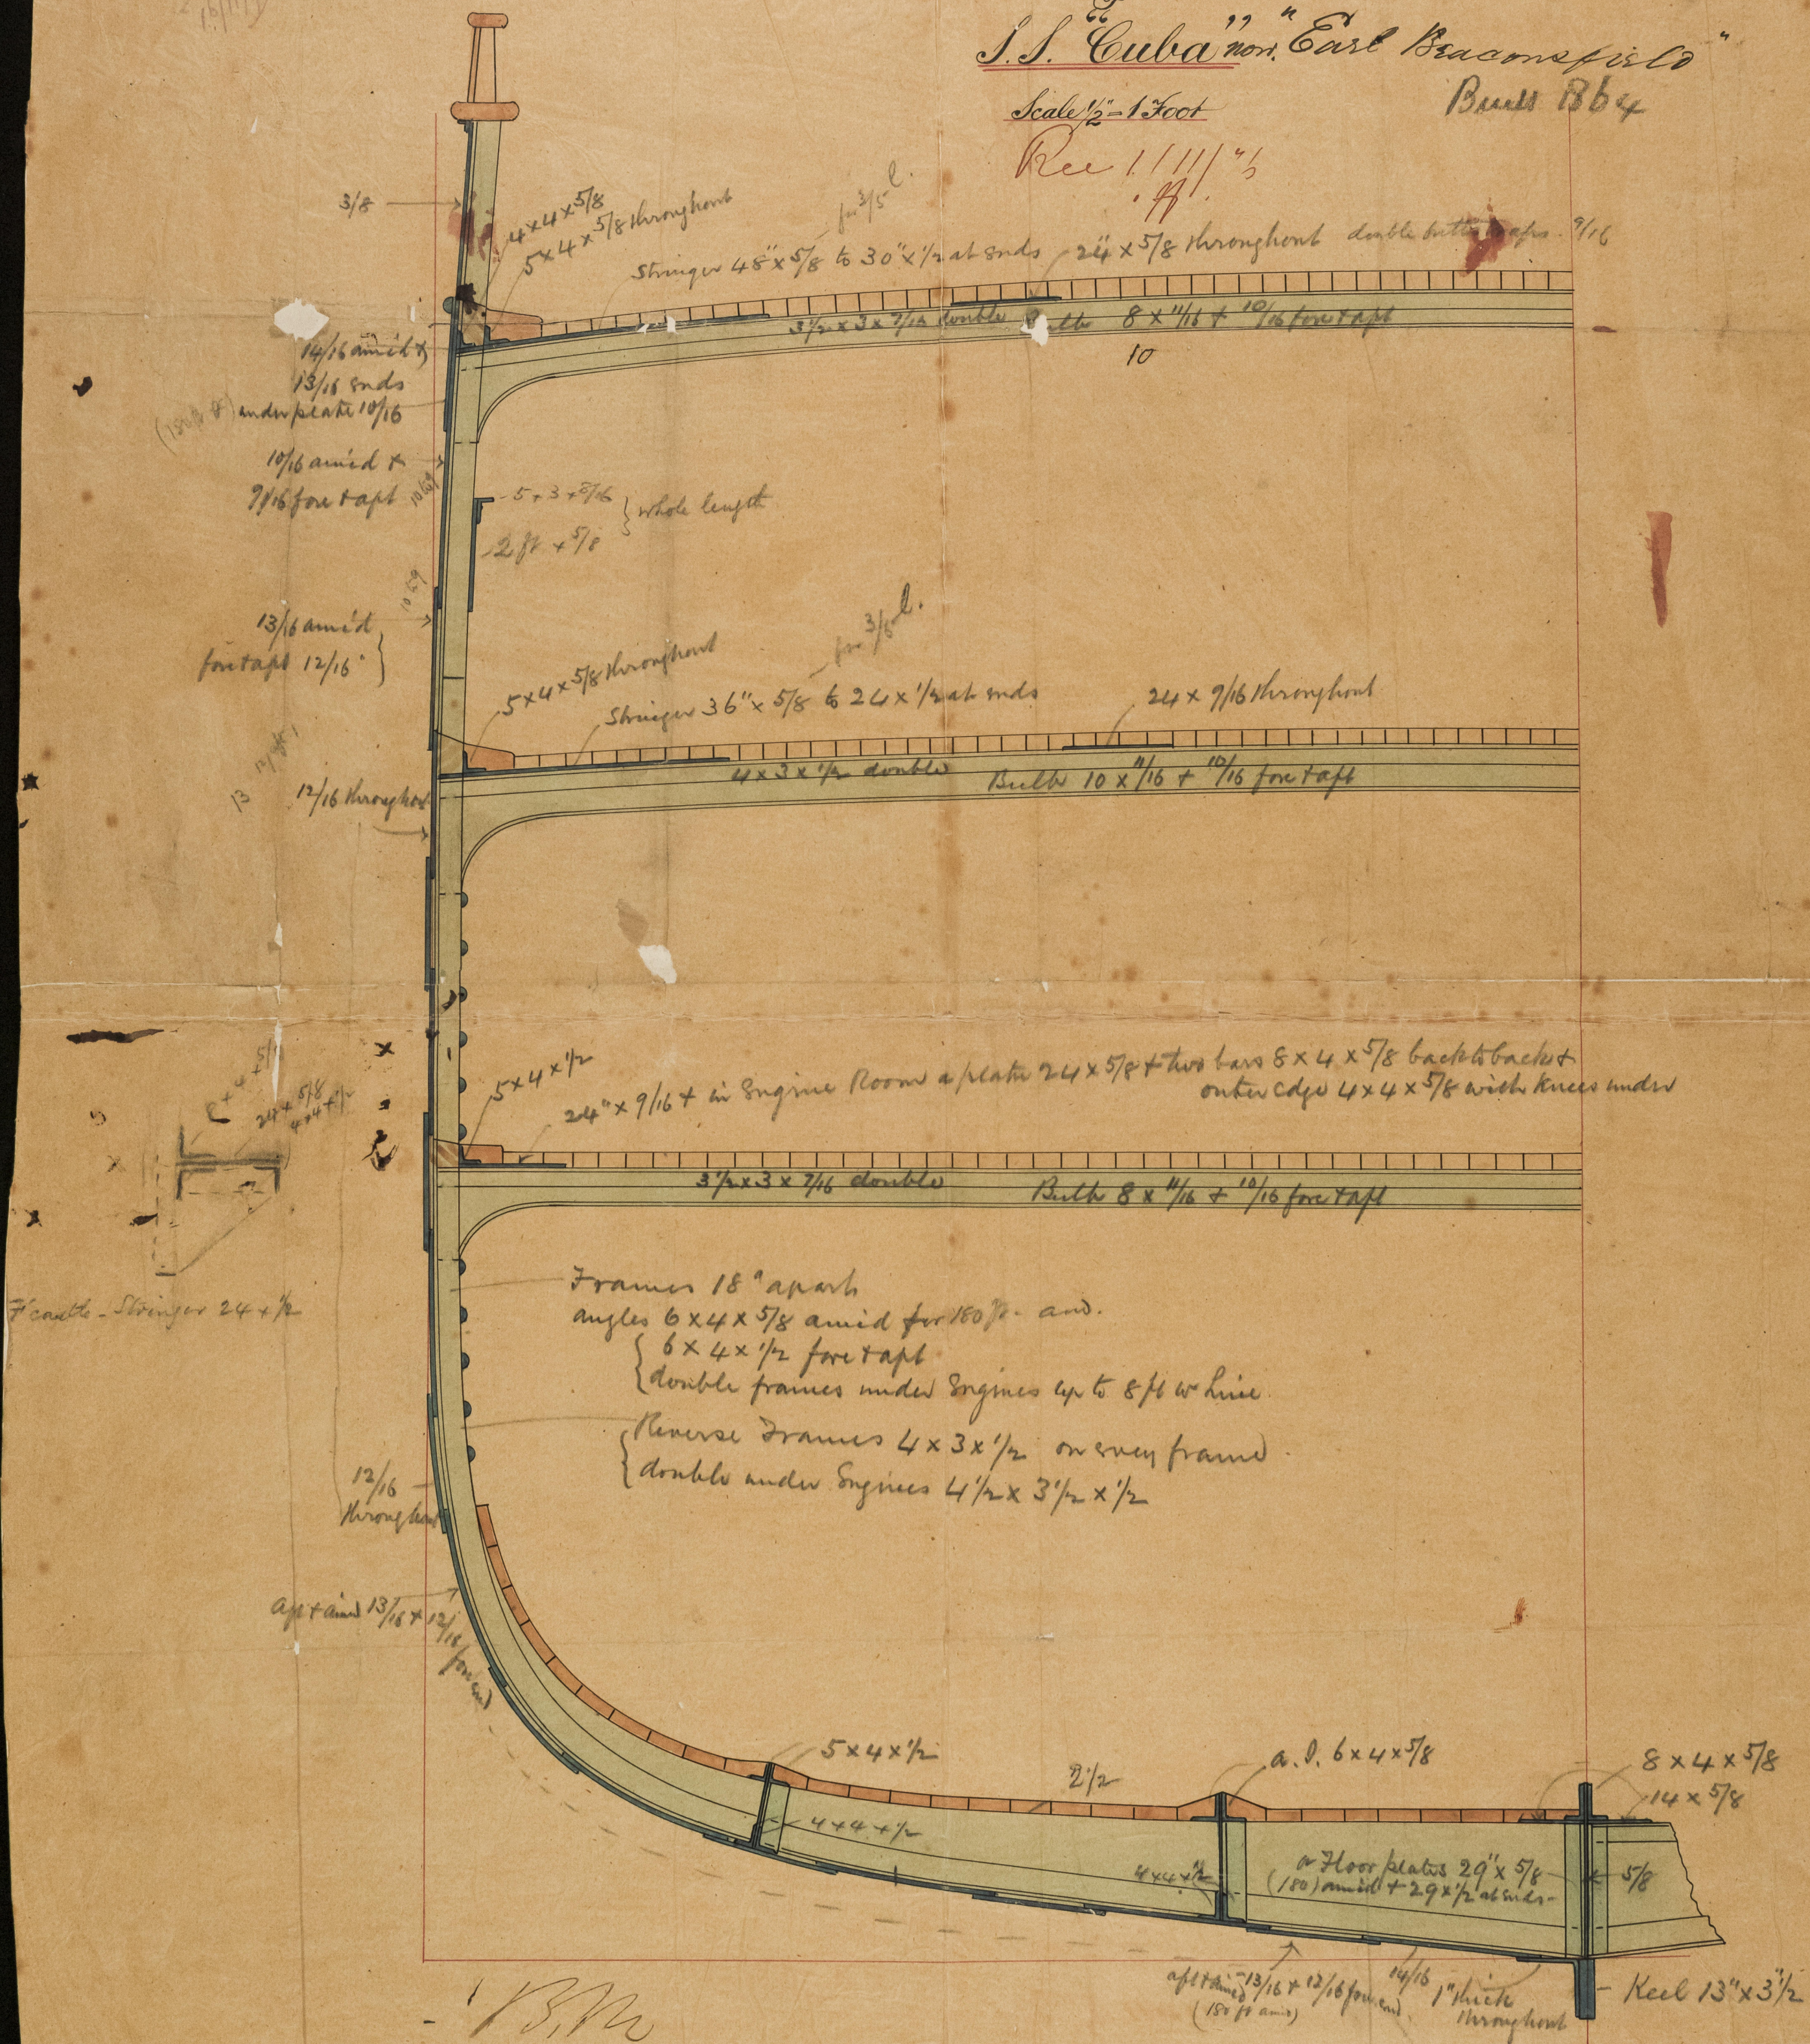

1831  
157<sup>th</sup>/76