

Iron S.S. Prudent report No. 11452



Feb 28th 1896

Midship Section S.S. No 93

Iron 19315

Scale  $\frac{1}{2}$  = 1 Foot

Class 100A Lloyds

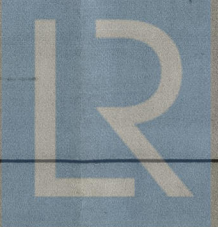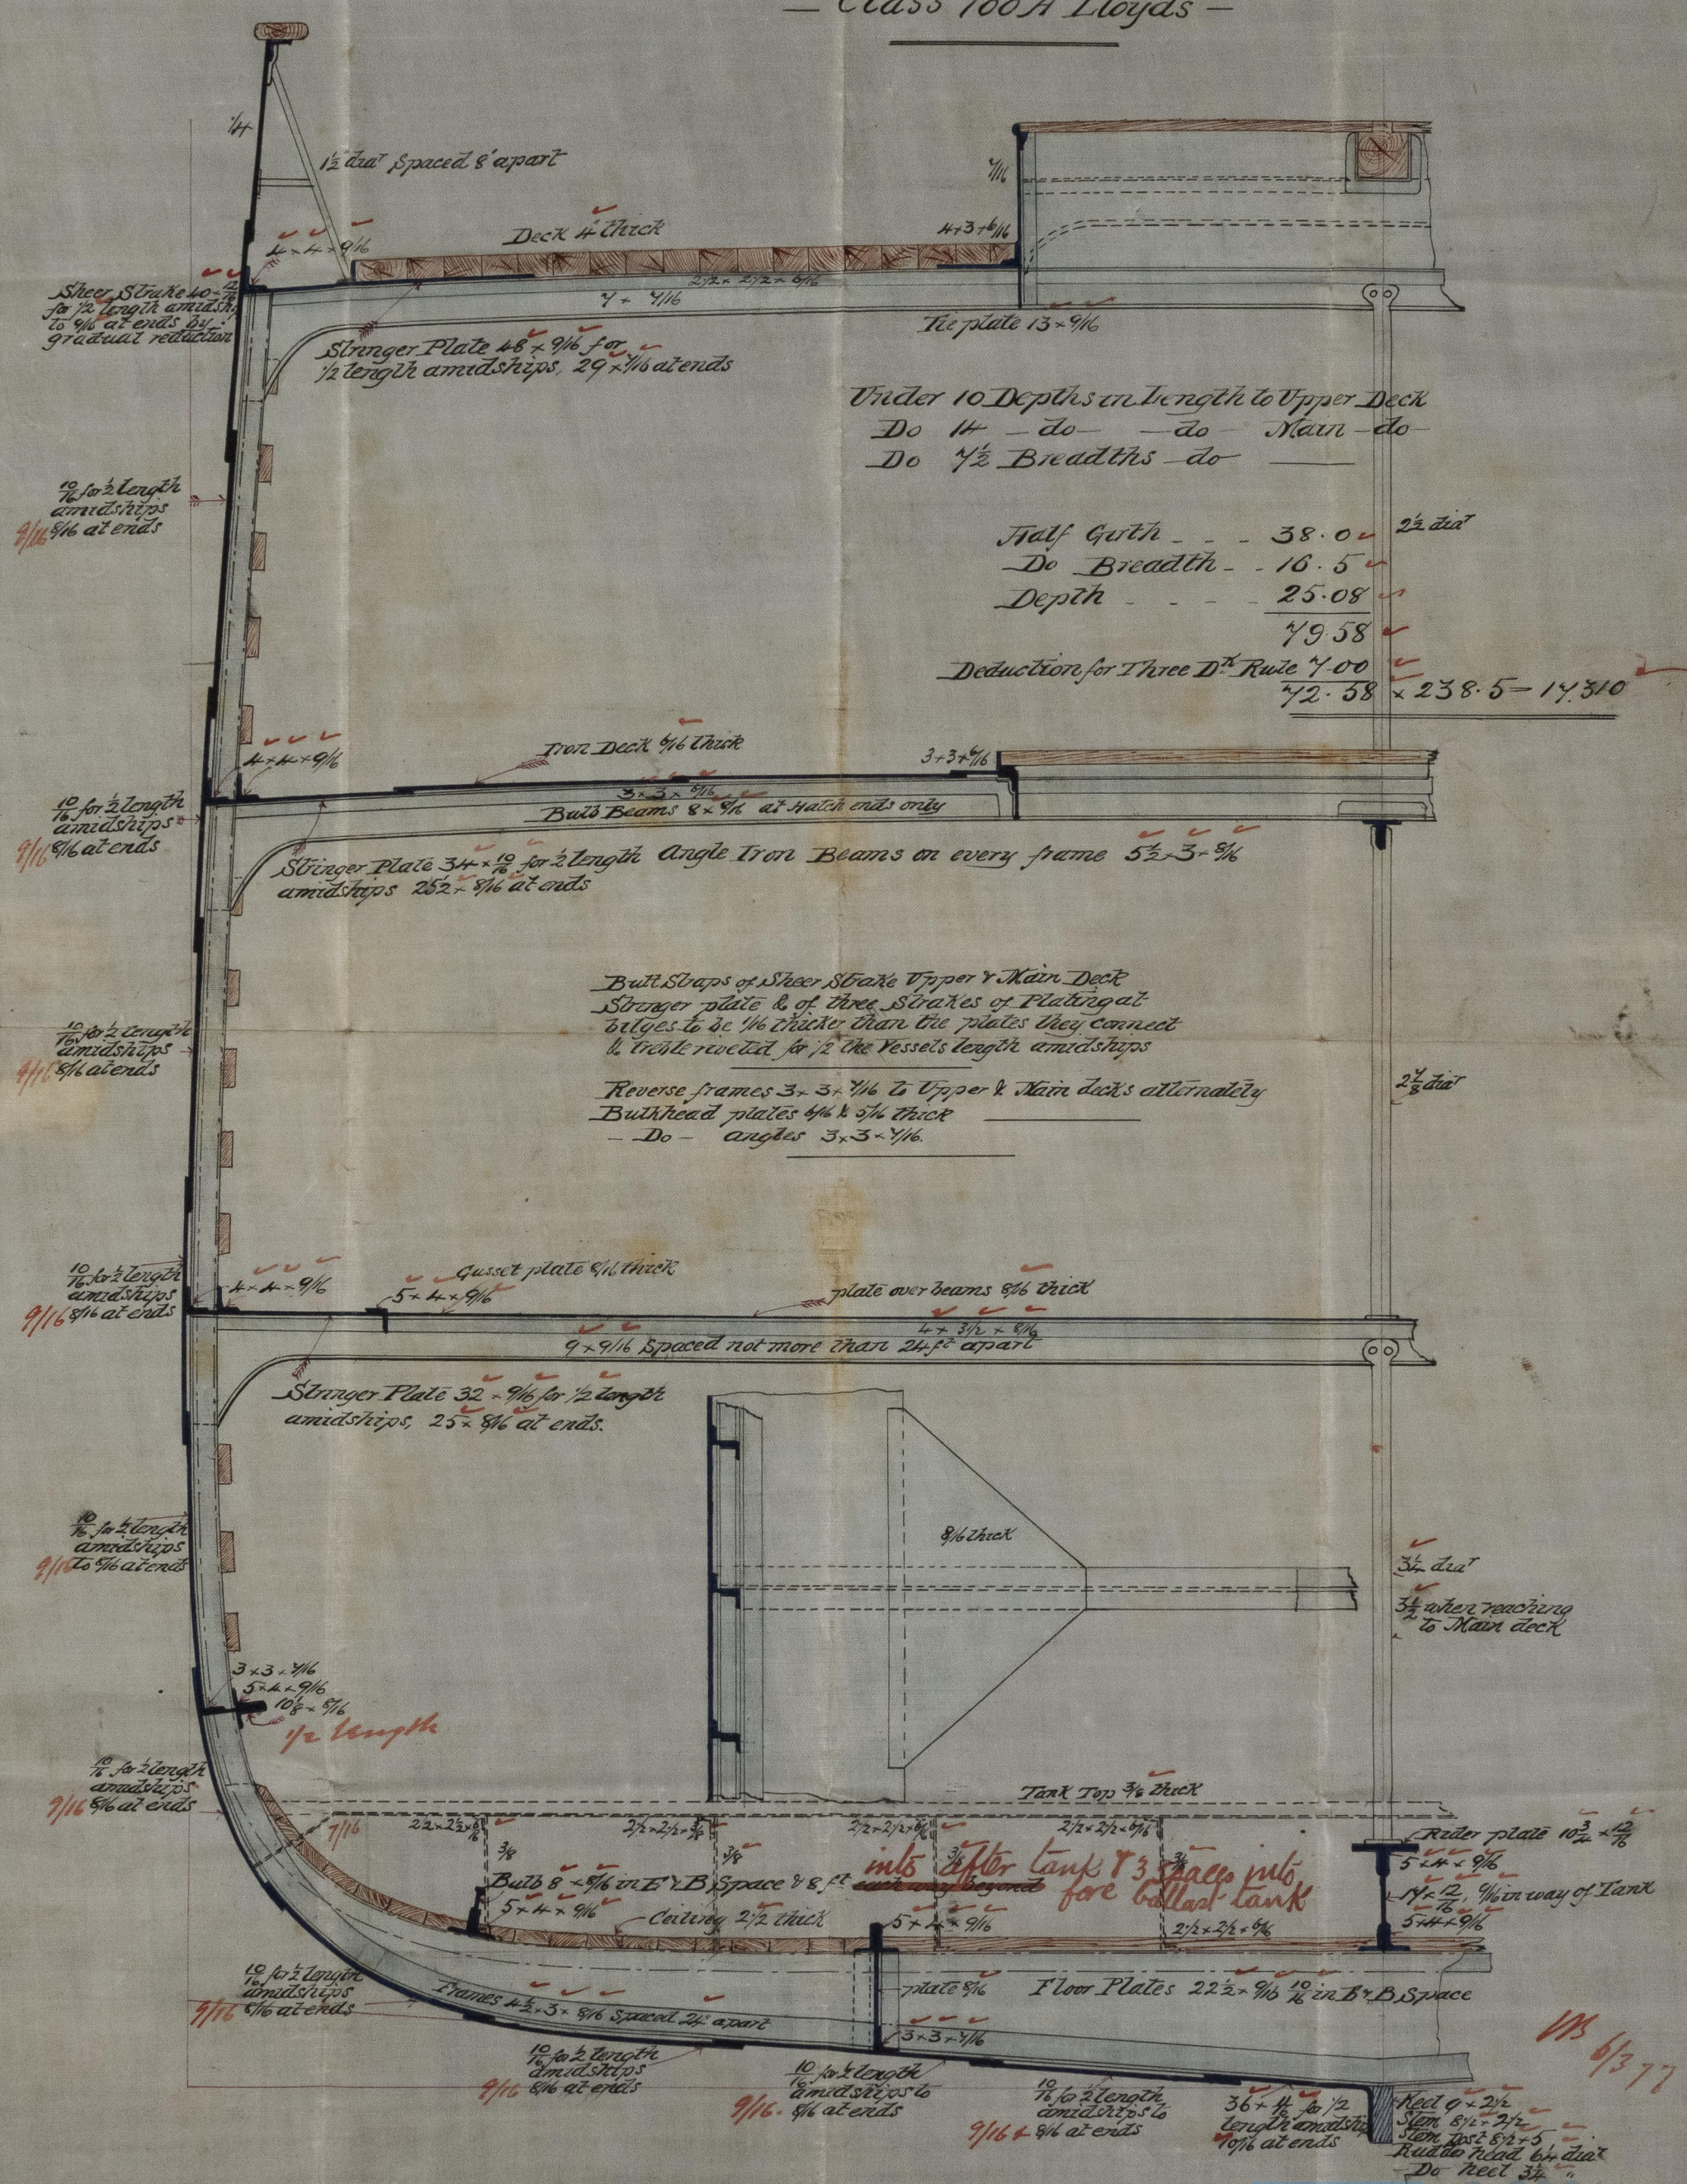

© 2021

Lloyd's Register Foundation

IRON 523-0013