

22/3/77


N^o 7 LONGITUDINAL SECTION

SCALE 1/4" = 1 FOOT

Rev 23/3/77

S.S. "QUEEN OF THE SOUTH"

Glasgow Report No 4506

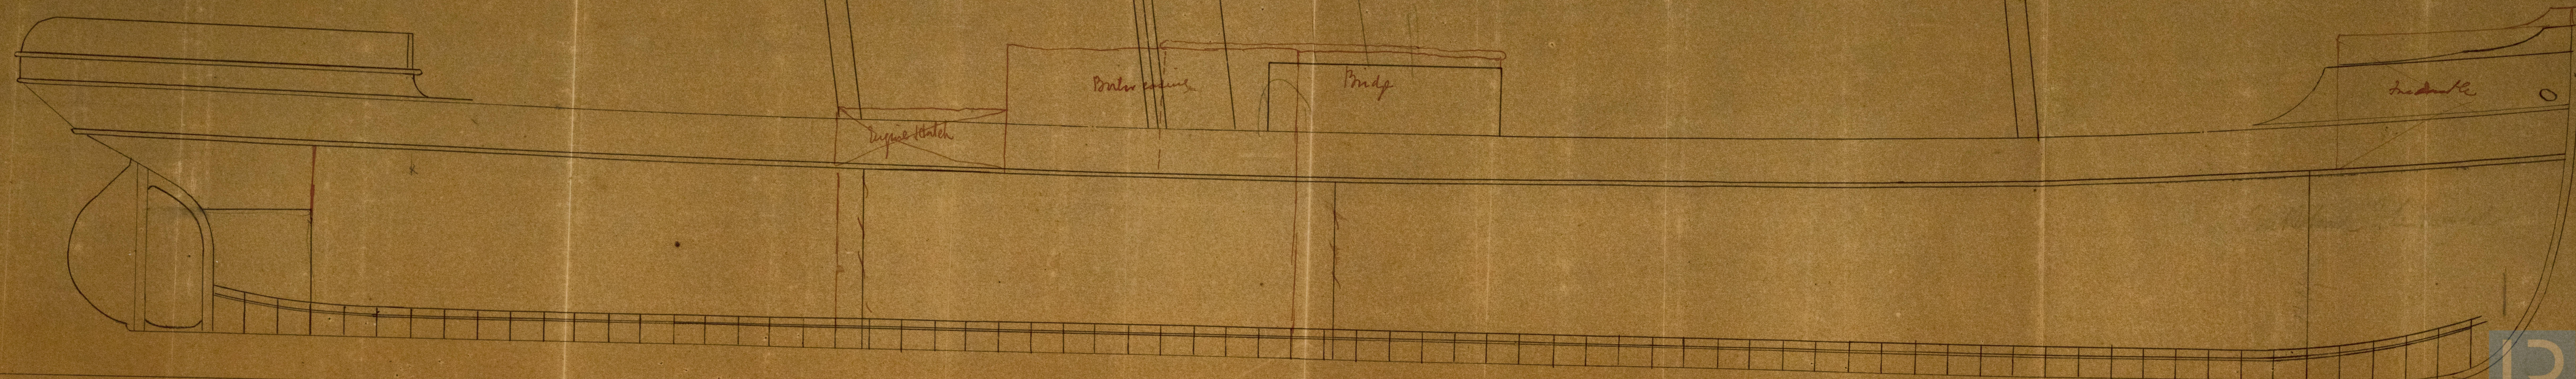

1200523-0016



© 2022 22/3/77
Lloyd's Register
14/3/77