


5/2/77

S.S. "Agnes"
Report No. 3840

— Outline Sheer plan. —
— No 22. SS —
— 18 1/2 ft. —
— mms —

Rev 5/2/77

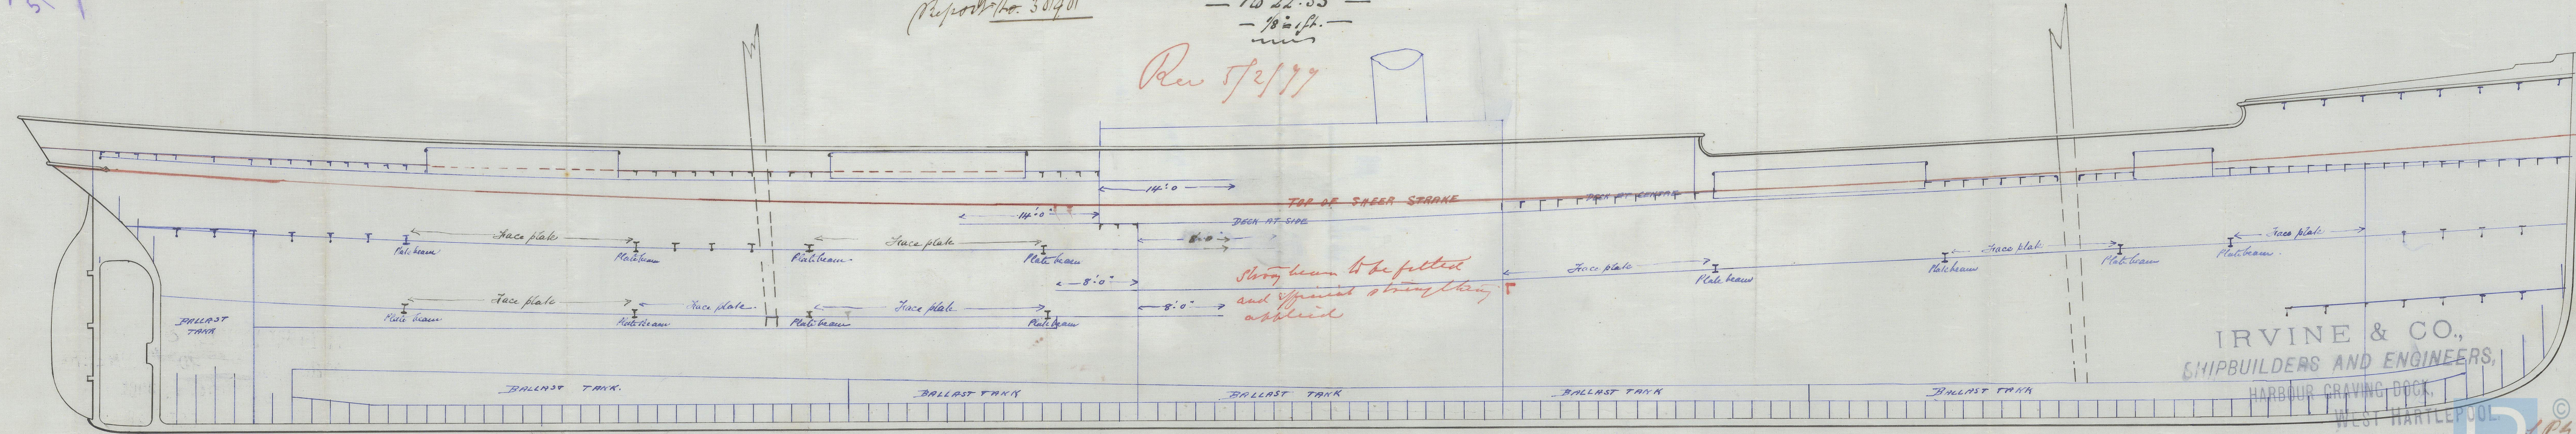

IRVINE & CO.,
SHIPBUILDERS AND ENGINEERS,
HARBOUR GRAVING DOCK,
WEST HARTLEPOOL.

IR00523-0082