


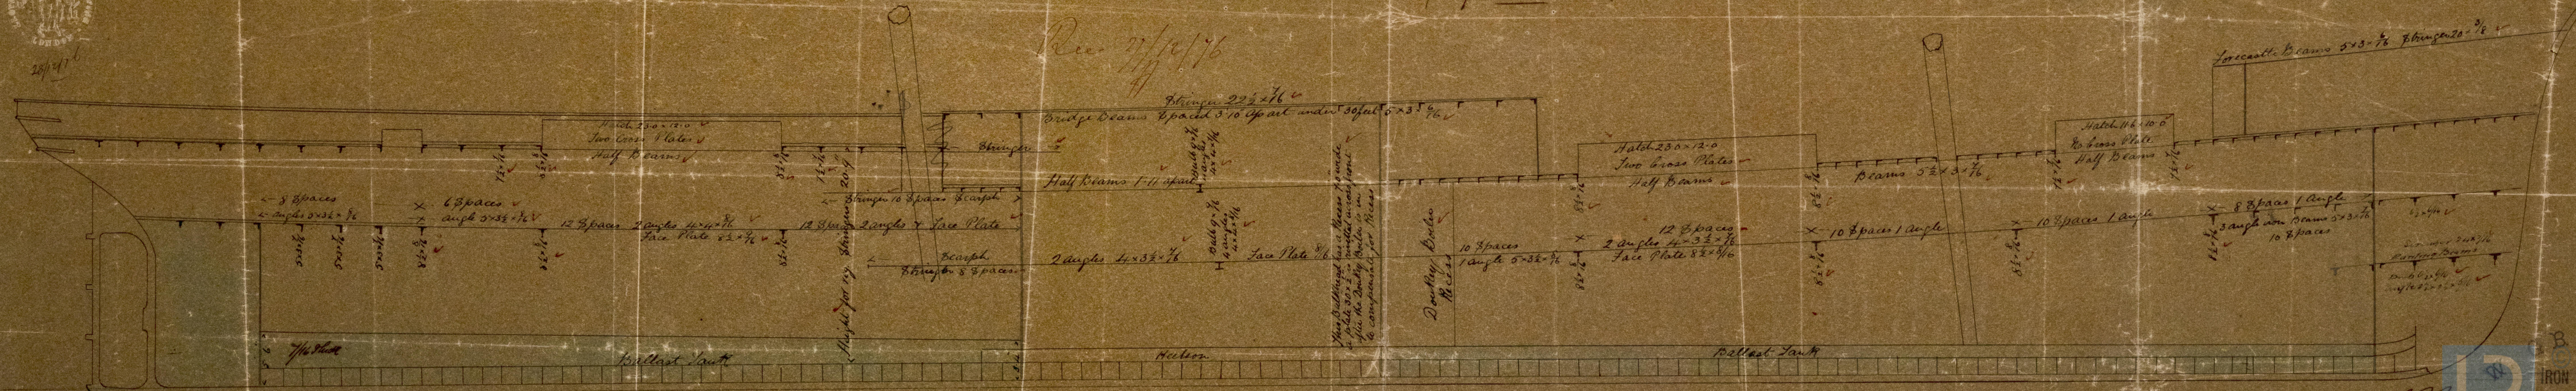

S.S. "Amanda"  
Report No. 3899

Recd 27/12/76  
47



174



RAY & CO.  
IRON SHIPBUILDERS  
AND  
REPAIRERS  
HARTLEPOOL  
Dec 22nd 1876

IRON 523-0086

1876  
24/12/76  
28/12/76