# No 174 S.S.

See Amended Drawing attached which the keyed is built to.

28/12/76

24/10/77

Class 100 A.1. Lloyds.

| | | Lloyds. |
|---|---|---|
| Length over all | | |
| Length between Perps | 235.0 | 233.9 |
| Breadth extreme | 32.0 | 31.10 |
| Depth of Hold to Top of Floors | 17.0 | |
| Depth from Top of Main Deck to Keel | | 18.4½ |
| Gross Tonnage about | 1300 Tons. | |
| Nos for Frames | 65.11 | |
| " " Plating | 15427 | |
| " " Equipment | 16969 | |
| Depths in Length 12/13 | Breadths in Do. 7/12 | |

½ Breadth 15.11
3 @ 6/16 1.7½
3.1.4½
65.11

Rec 27/12/76

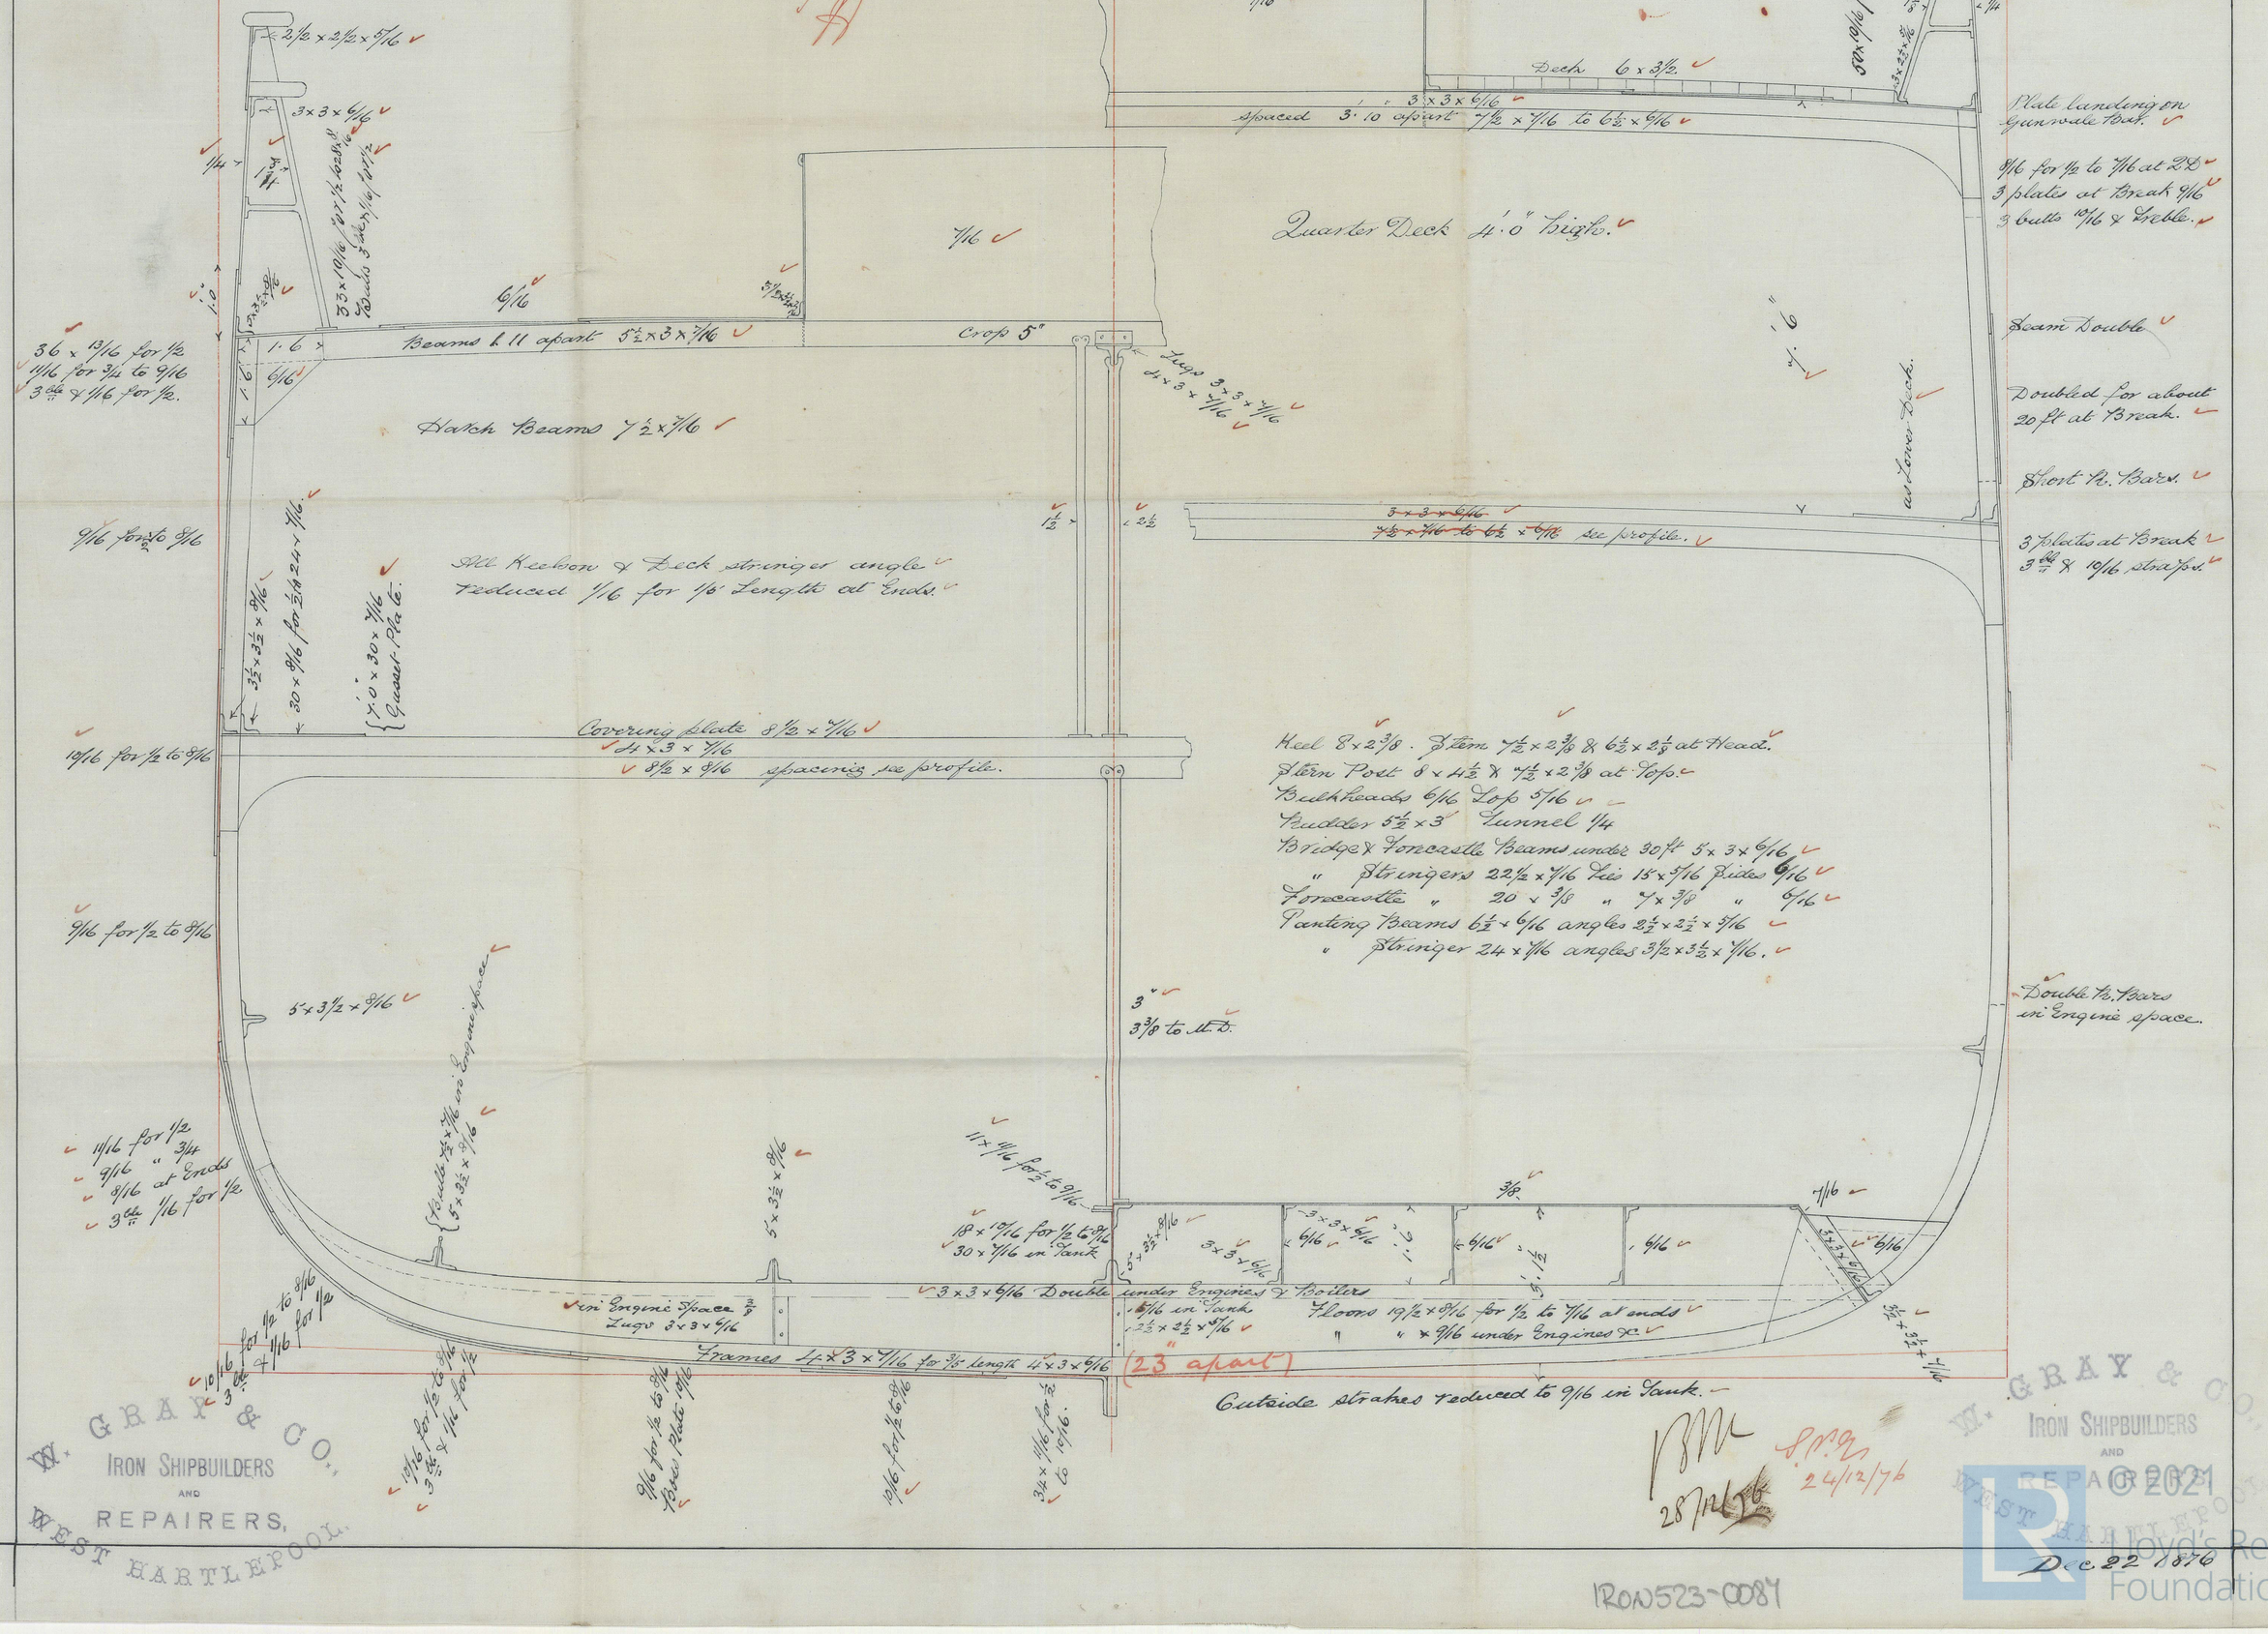


W. GRAY & CO.
IRON SHIPBUILDERS AND REPAIRERS,
WEST HARTLEPOOL.

W. GRAY & CO.
IRON SHIPBUILDERS AND REPAIRERS
WEST HARTLEPOOL.

28/12/76

24/12/76

Dec 22 1876

© 2021 Lloyd's Register Foundation

IRON523-0084