

Iron

No 19395

3/8" Eng Tarsund

S.S. "Amanda"

Report No. 3099

No 174 S S

Class 100 A1 at Lloyd's

Length over all

Between Peris

Breadth extreme

Depth of Hold to top of Floor

from top of Main Deck to Keel

Gross Tonnage about 1300 tons

Net for Tonnage 65 7/8

Plating 15427

Equipment 16969

Depth in length 12/13 Breadth in do 7/13

Build at Lloyd's

235.0 233.9

31.6 31.4

17.3

18.10 1/2


15.8

12.1

31.4

65 7/8

12.1

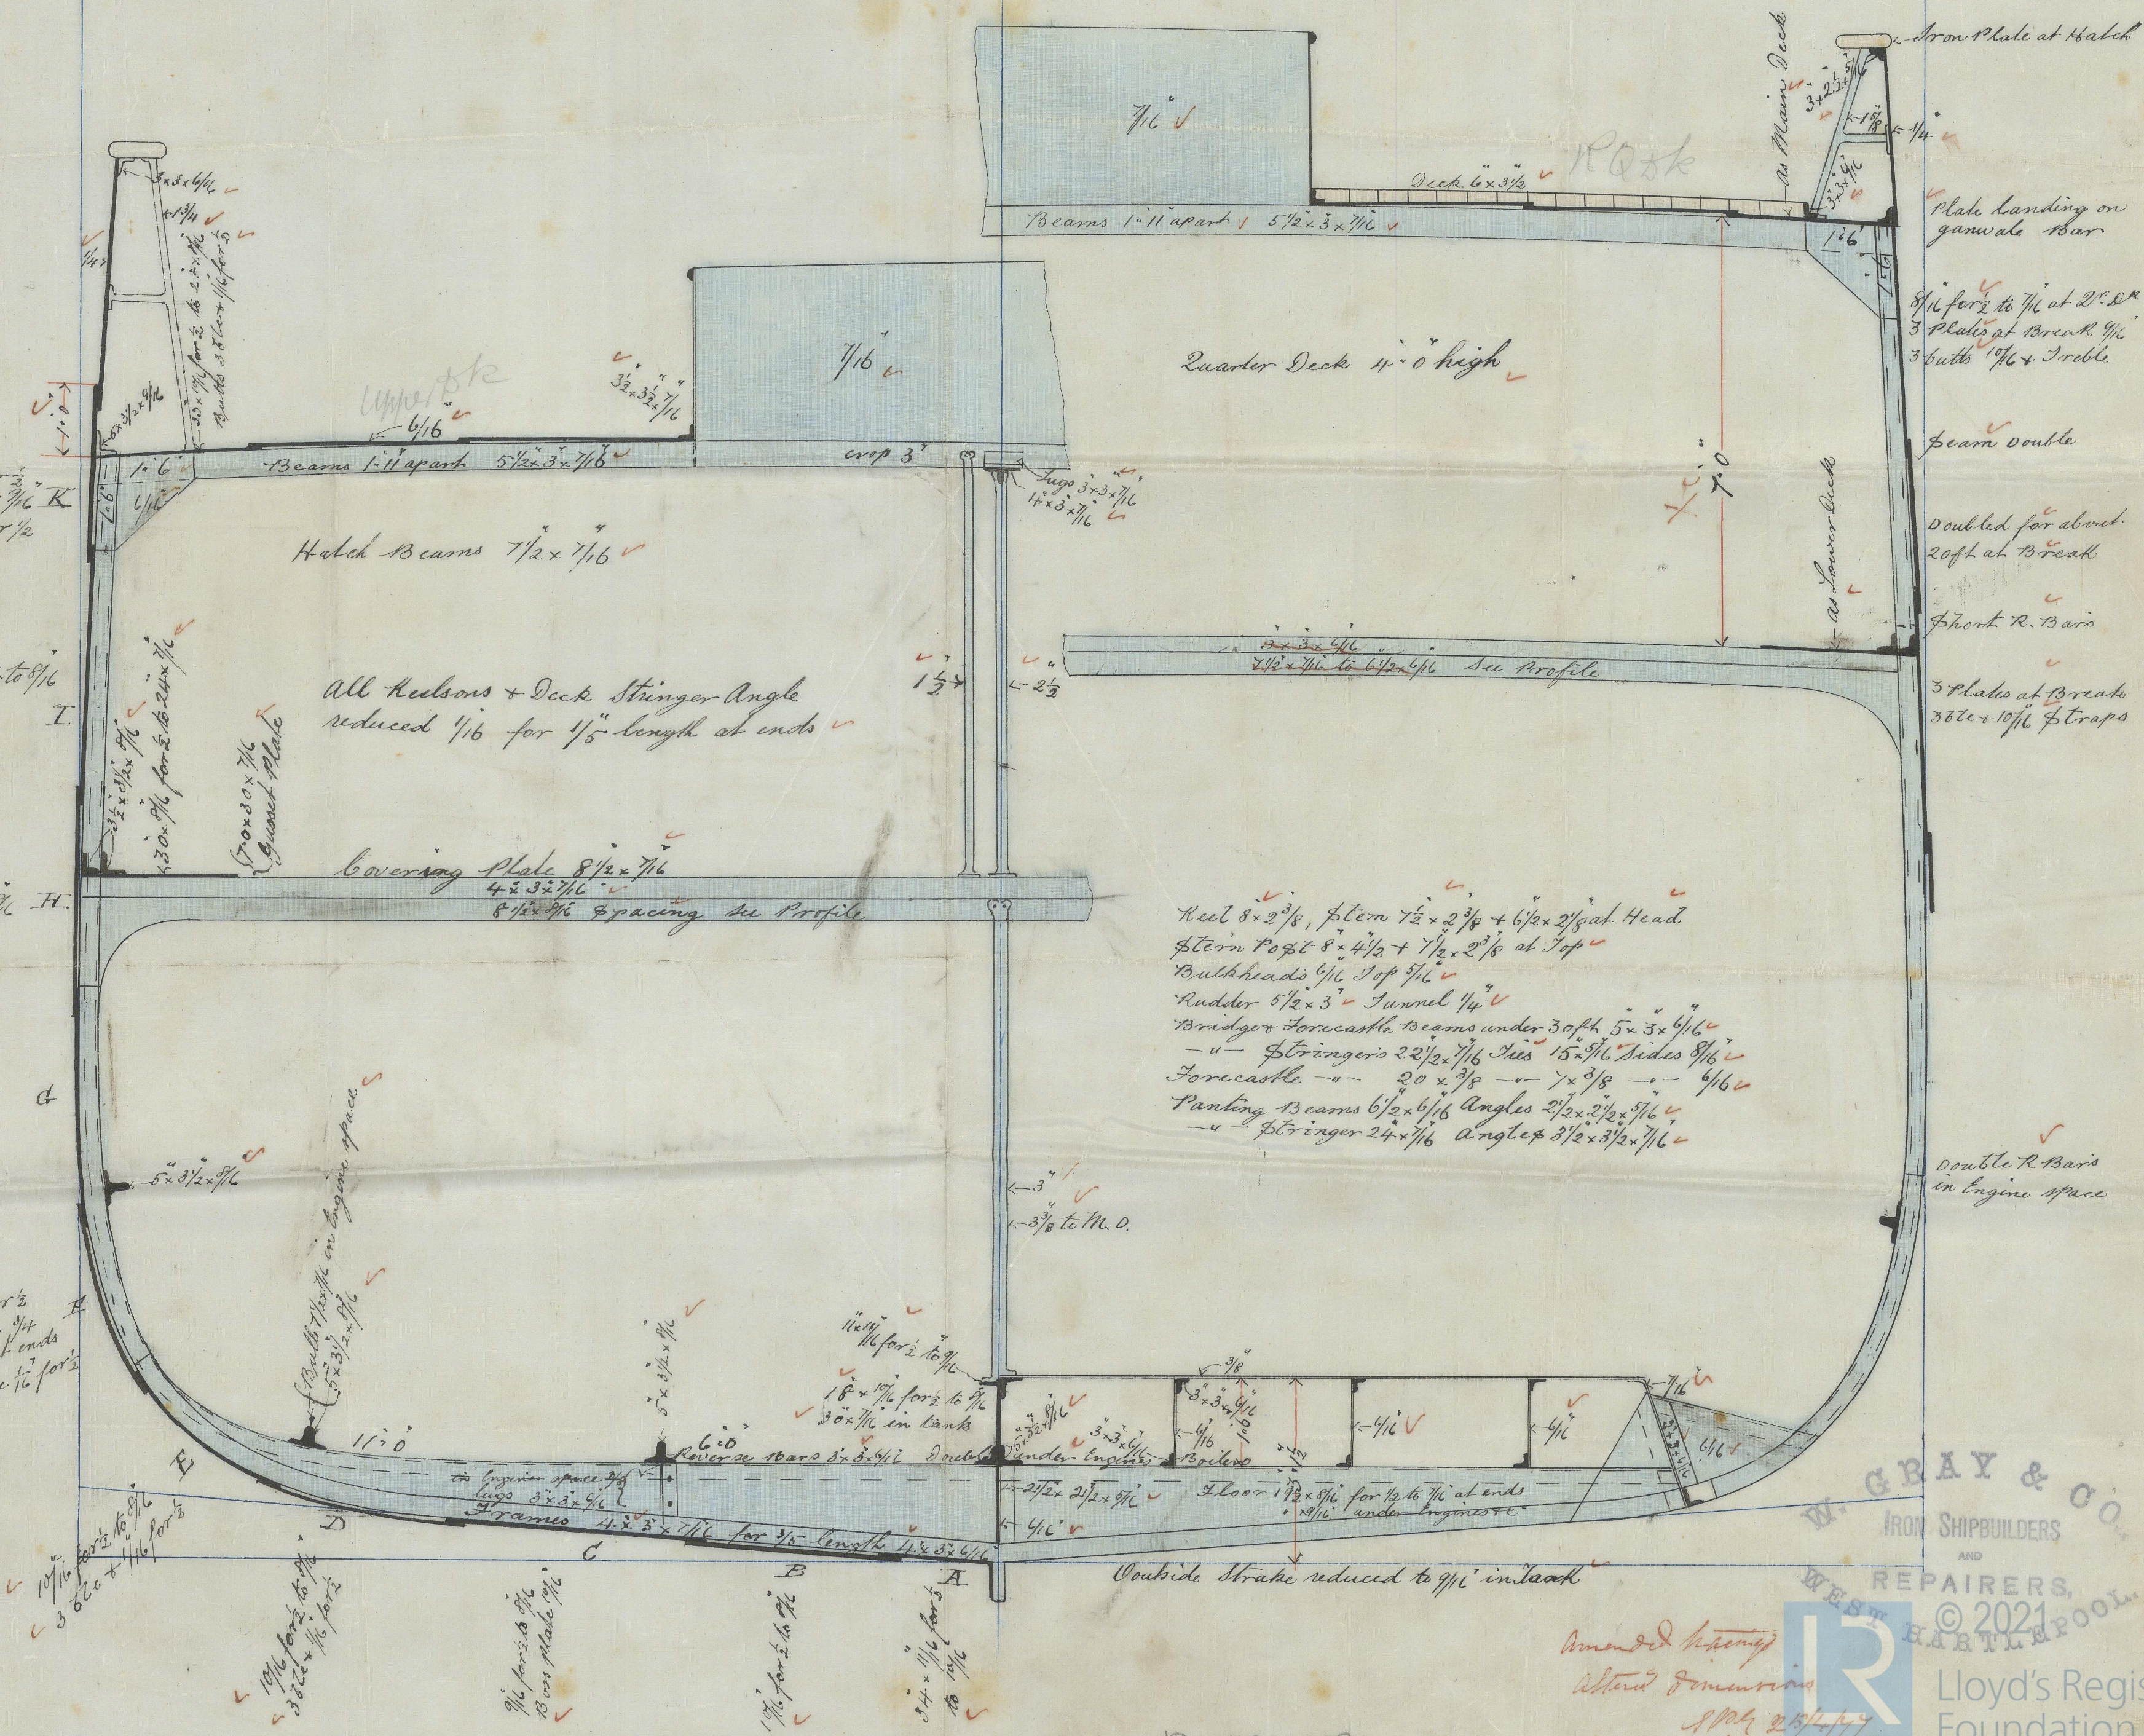

W. GRAY & CO.  
IRON SHIPBUILDERS  
AND  
REPAIRERS,  
WEST HARTLEPOOL

© 2021  
Lloyd's Register  
Foundation

1800523-0090