

Top gallant F.C. 3/4 ft  
Full Deck 30 ft

# S.S. "Antonio" Repair No. 11.444.

Equipment required  
25325

Equipment:  
2 Bowers 52 but. ✓  
1 " 27 1/2 " ✓  
1 Stream 13 " ✓  
1 Hedge 6 1/2 " ✓  
1 " 3 1/2 " ✓

27 of others of 1 1/2 chain cable. ✓






Revisions

Under 11 Depth to upper str. ✓  
" 15 " middle ✓  
" 18 Breadth. ✓

Rev 15777

Numbers:

Length 279.0  
1/2 Breadth 16.9 ✓  
1/2 Depth 12.45 ✓  
Depth of keel 26.16 ✓  
82.52 ✓  
75.53 ✓  
15104 ✓  
2870 ✓

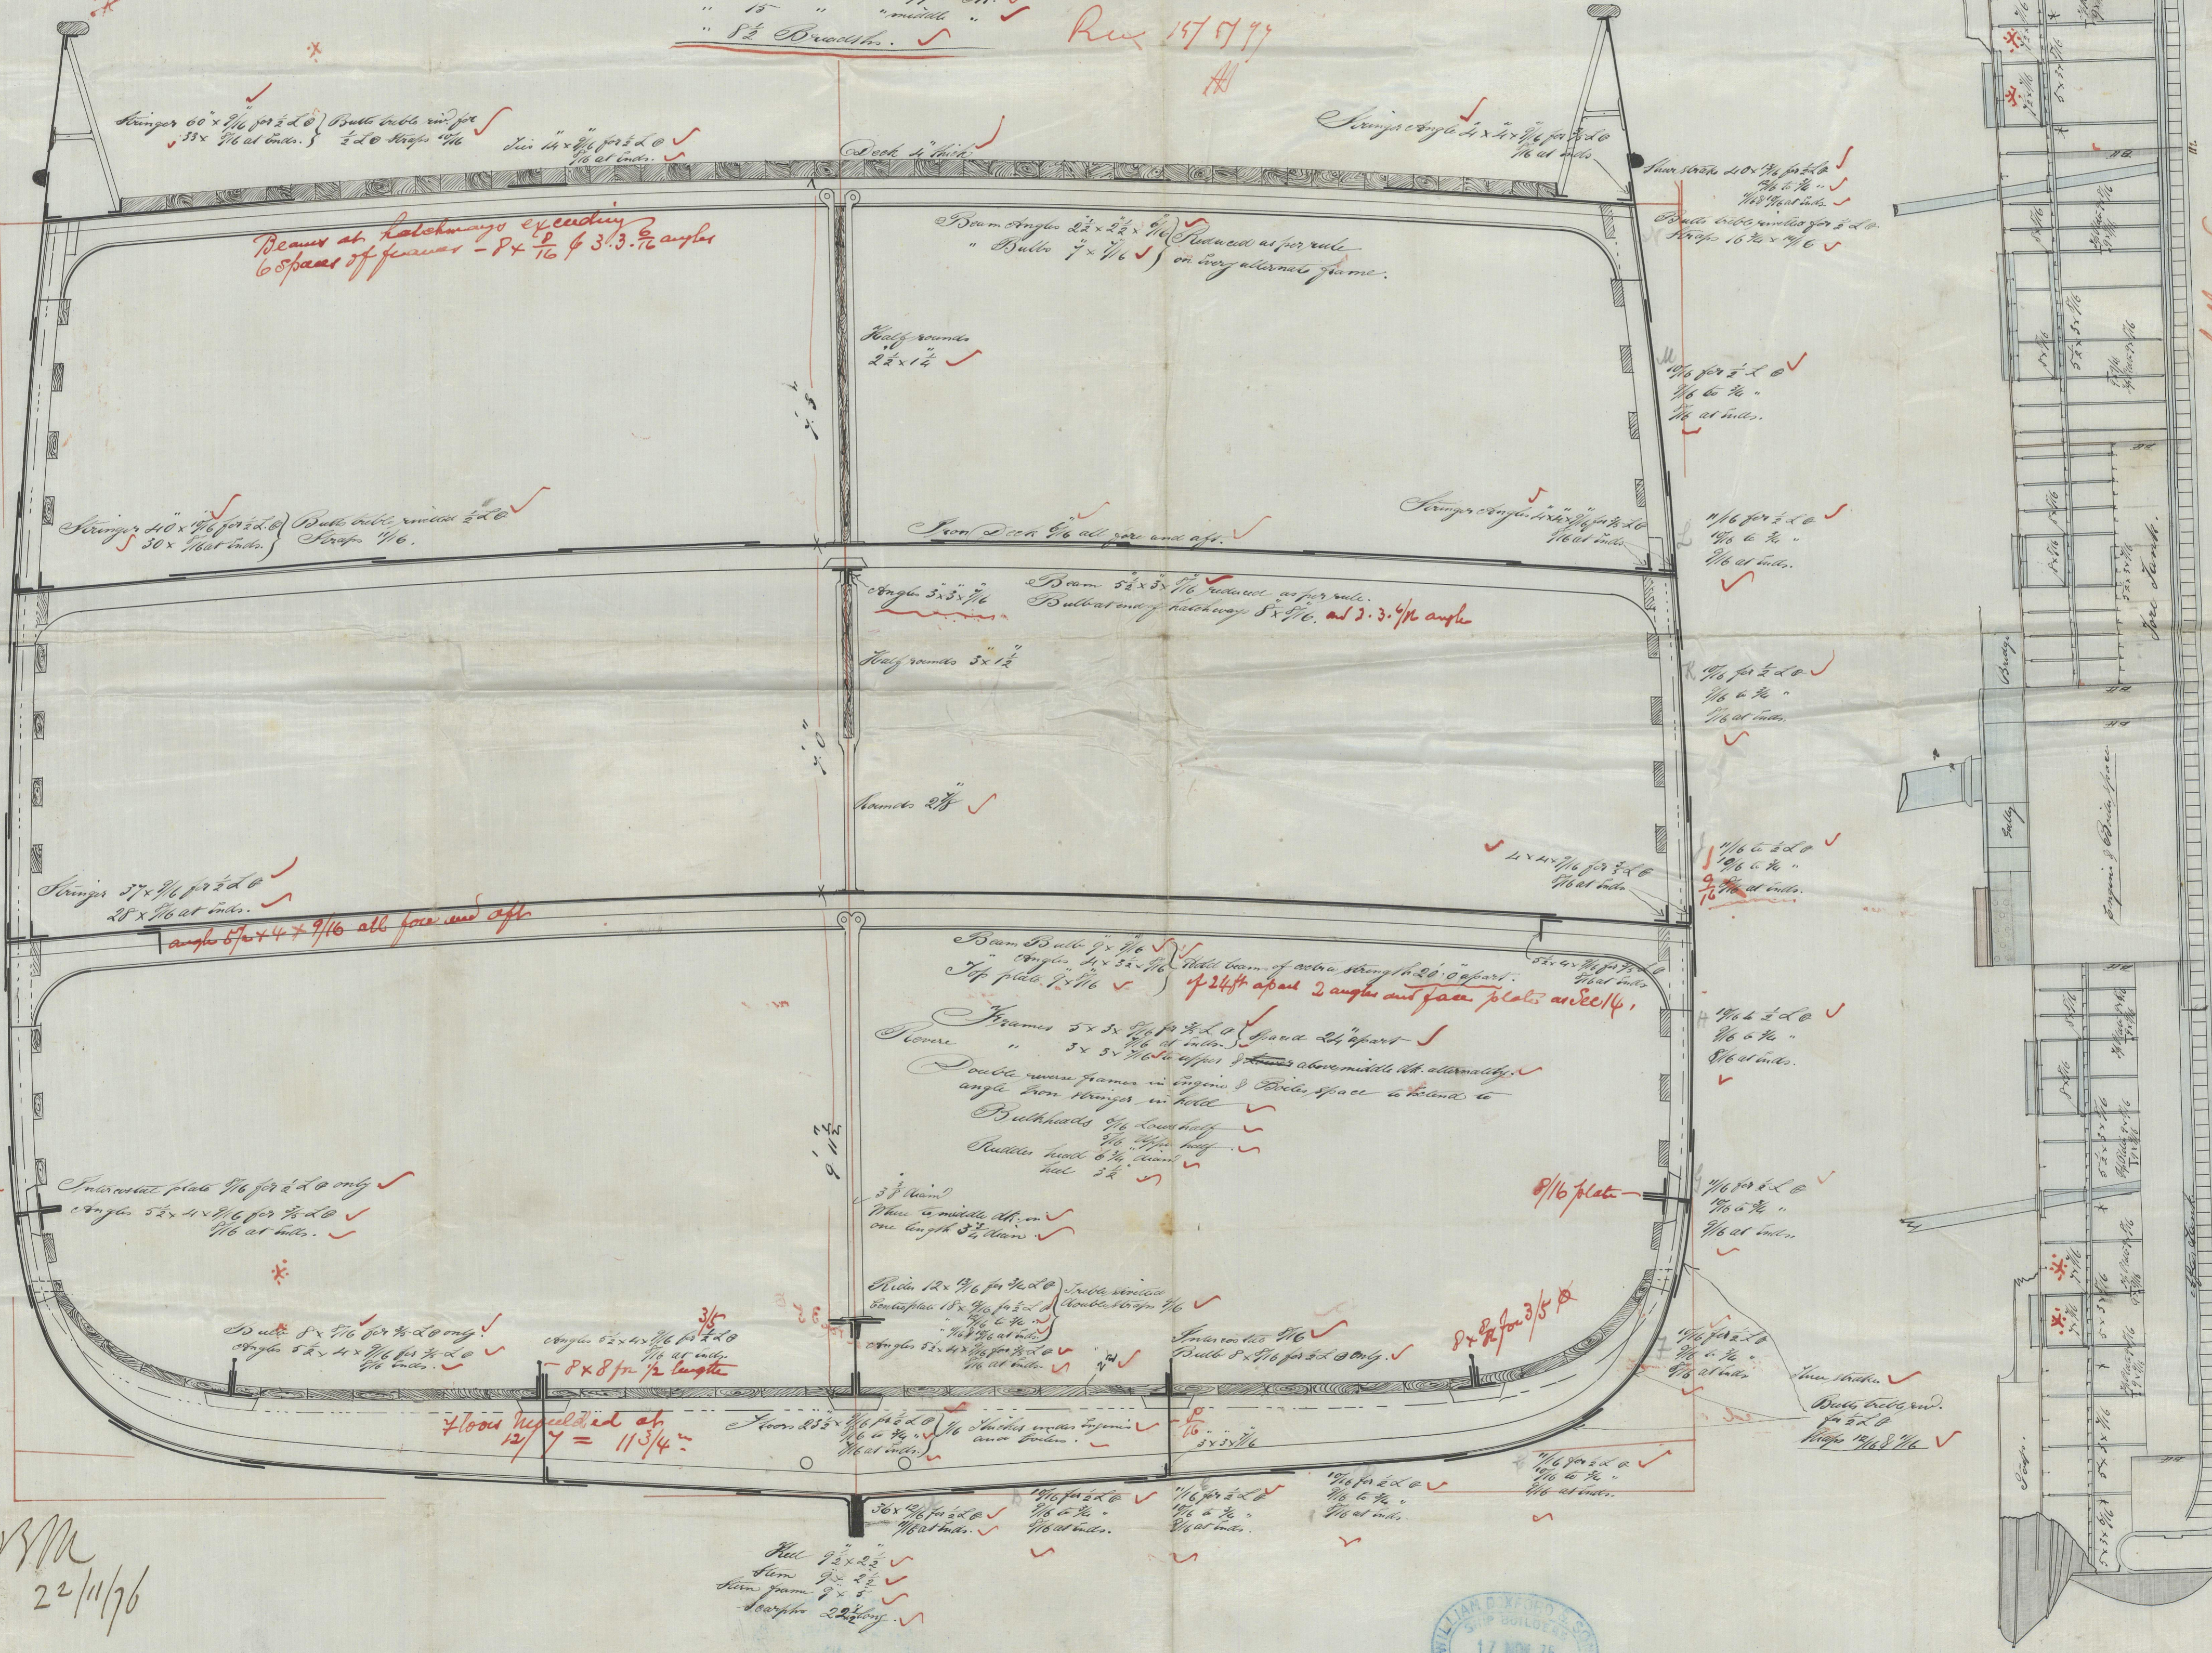


Mem. Bds.  
Main 1/16 inch  
For B. & W. 15777

The main Deck Beams the marked on to be built up  
revised in the forepart as to this length. Dec 13.

BM  
22/11/76

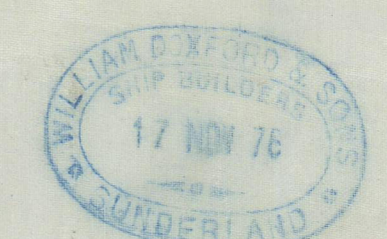

IRON 523-0091