

S.S. "Antonio" Report 11.444

S.S. No. 92

Sections of Iron Masts

Scale 1" = 1 Foot

Fore Mast 74.9 8/16 ✓

23" diam. ✓

Plating 6/16 & 5/16 ✓

Seams double riv'd ✓

Butts below partners double ✓

remainder treble riv'd ✓


Straps 1/16 thicker than plates ✓

Doubled in way of wedging

6.0 x 6/16 ✓

cheeks 8/16 ✓

angles 4 1/2 . 3 . 7/16

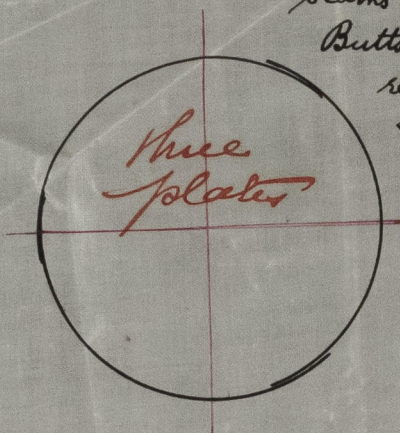

Main Mast 71.0 8/16 ✓

21 1/2 diam. ✓

Plating 6/16 & 5/16. Seams double riv'd ✓

Butts below partner double ✓


riv'd remainder treble ✓

Straps 1/16 thicker than plates ✓

Doubled at wedging 6.0 x 6/16 ✓

cheeks 8/16 ✓

angles 4 1/2 . 3 . 7/16

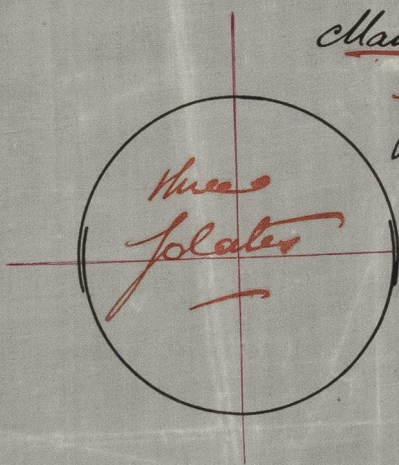

Messrs. W. Doxford & Sons

Tallion 17/4/77

E. H. - J. H. -

18/4/77



© 2021

Lloyd's Register  
Foundation

1200523-0092