

16/5/77


S.S. "Antonio" Sketch showing Disposition of Beams  
in Engine & Boiler Space

Report No. 11.444.


S.S. No. 92 Run 15/7/77  
Lat 41° 10' 00"




Plan of Upper Dk.

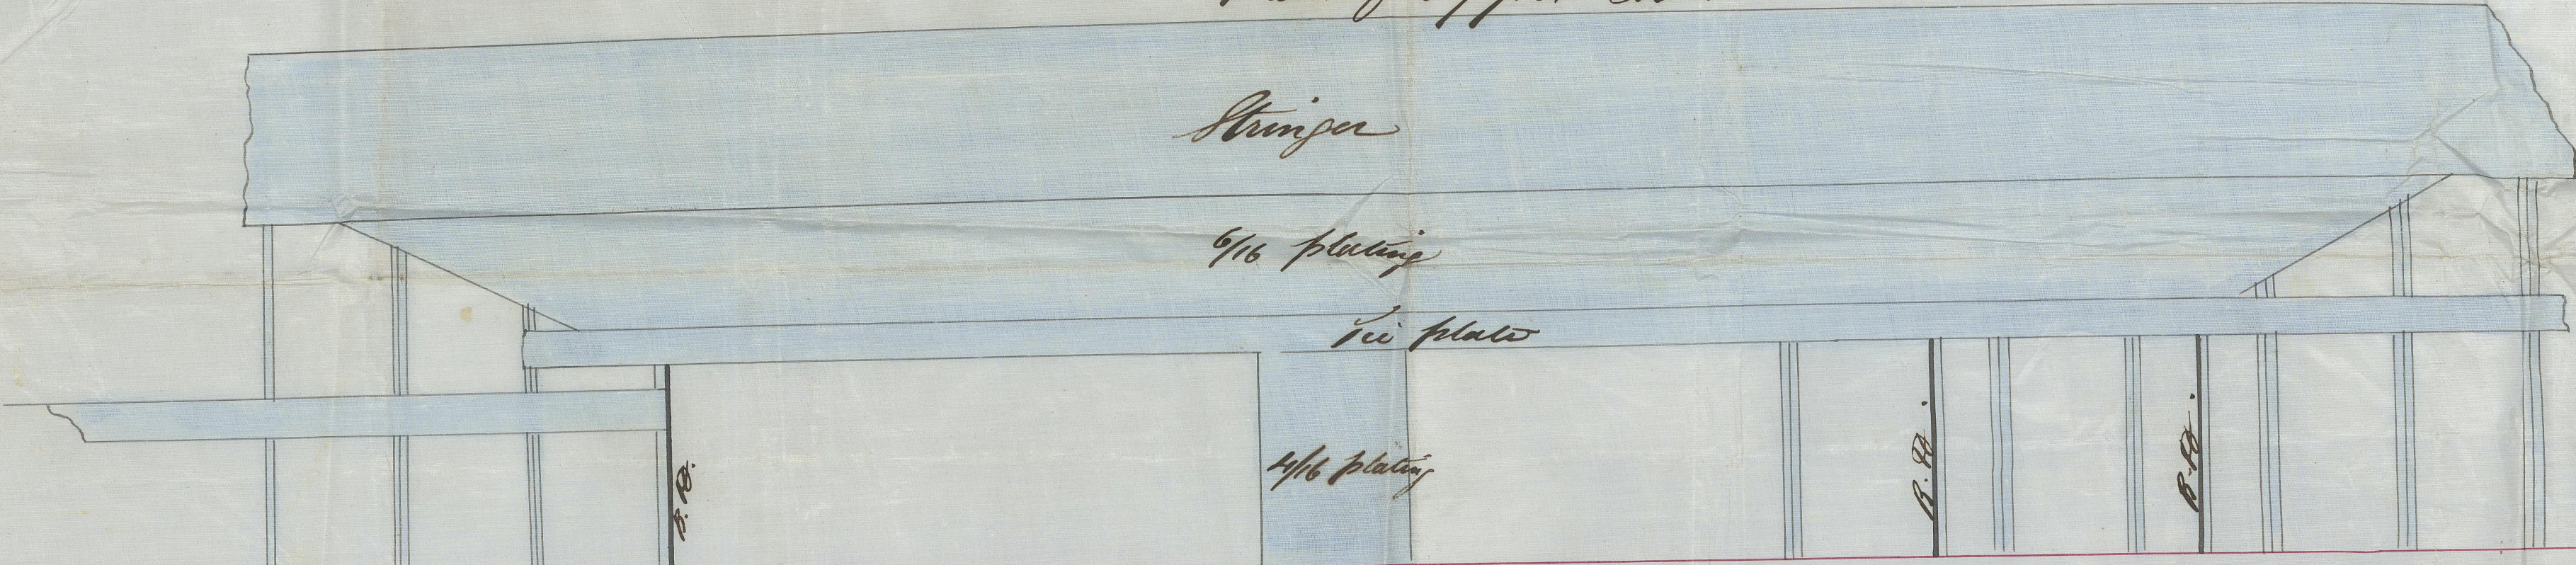

Plan of Middle Dk.

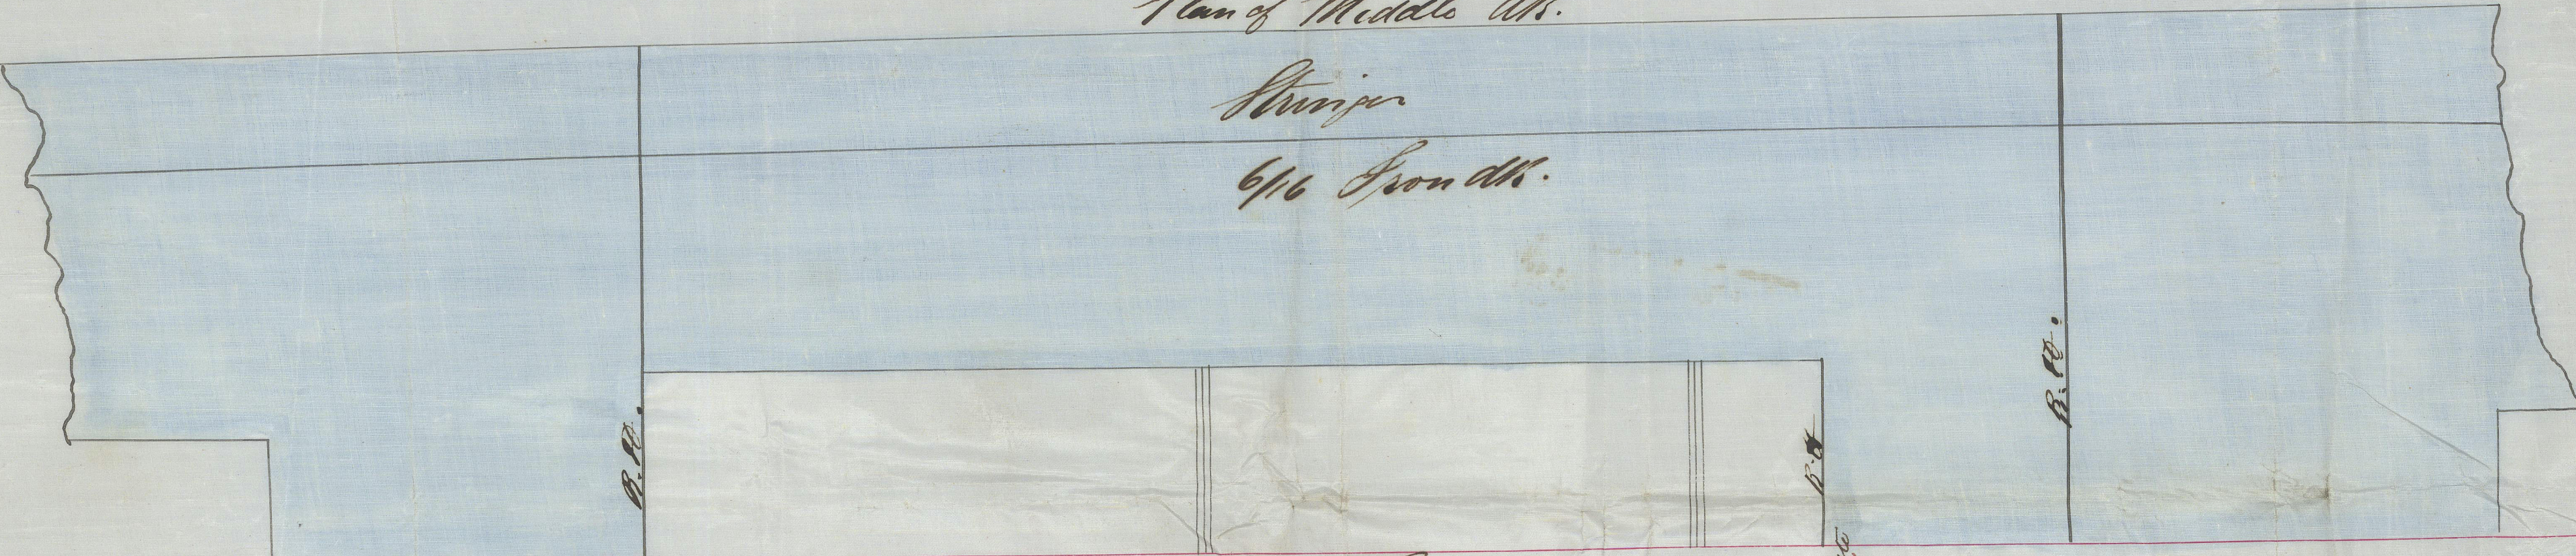

Plan of Lower Dk.

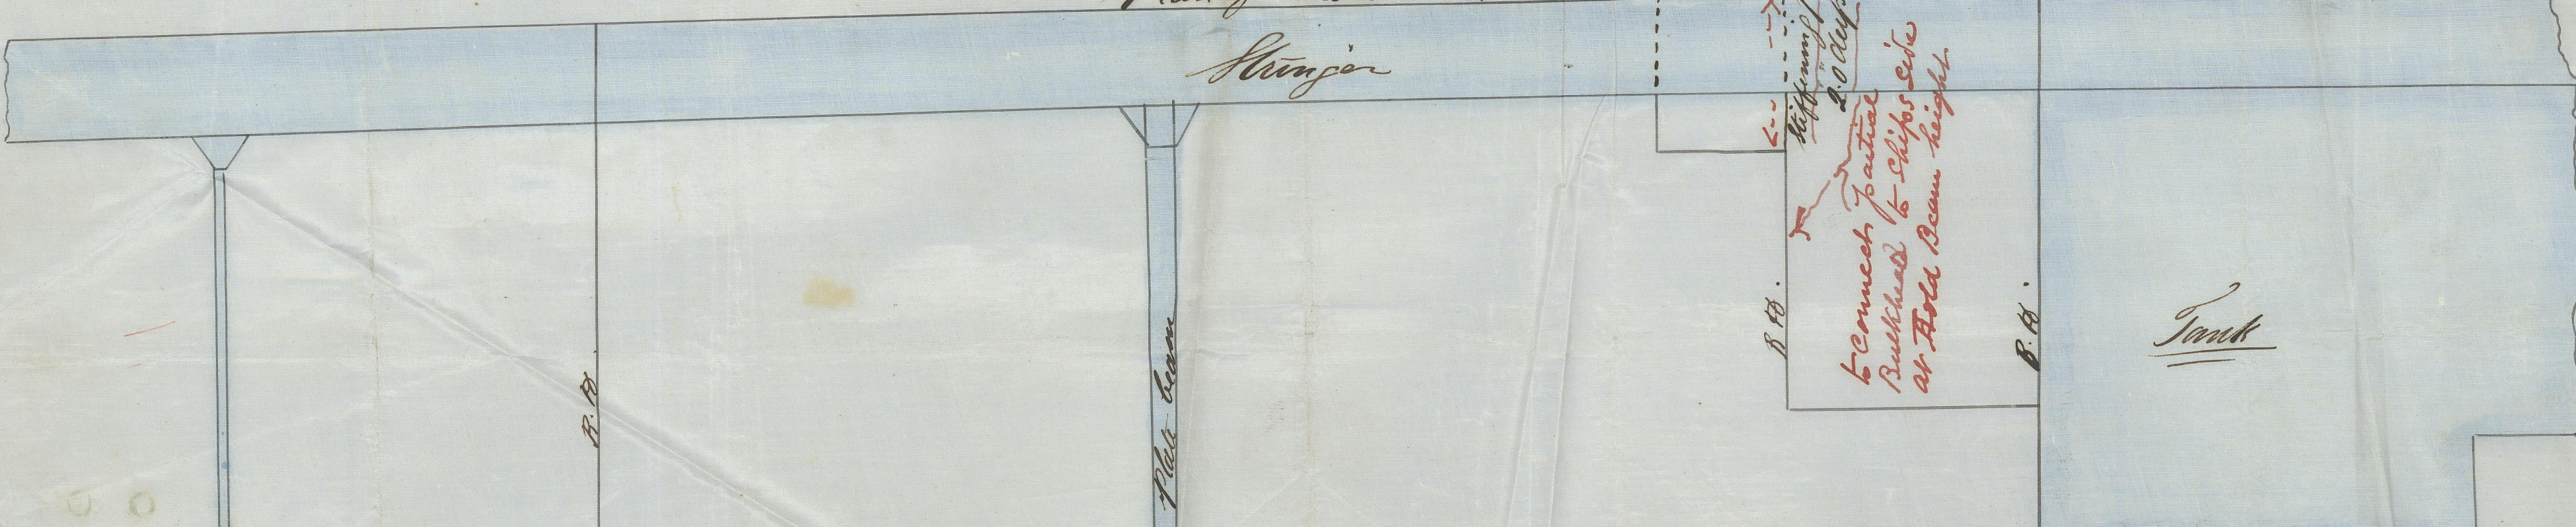


1872  
1675727

