
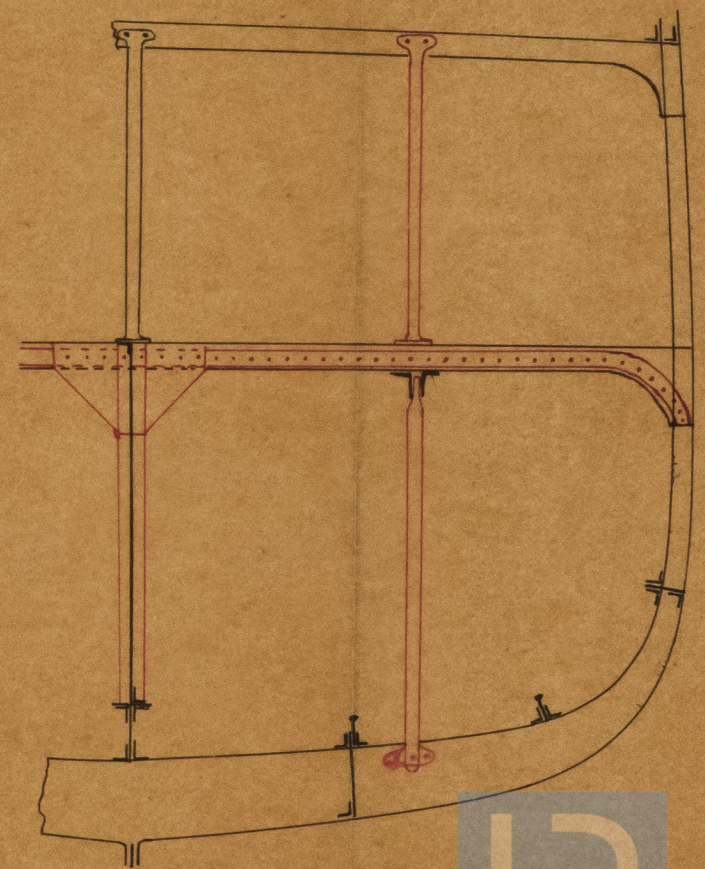


copy to W. M. Mearns 2 Jan. 79.

S. S. "Antonio."

Additional strengthenings for Water Ballast Tank.

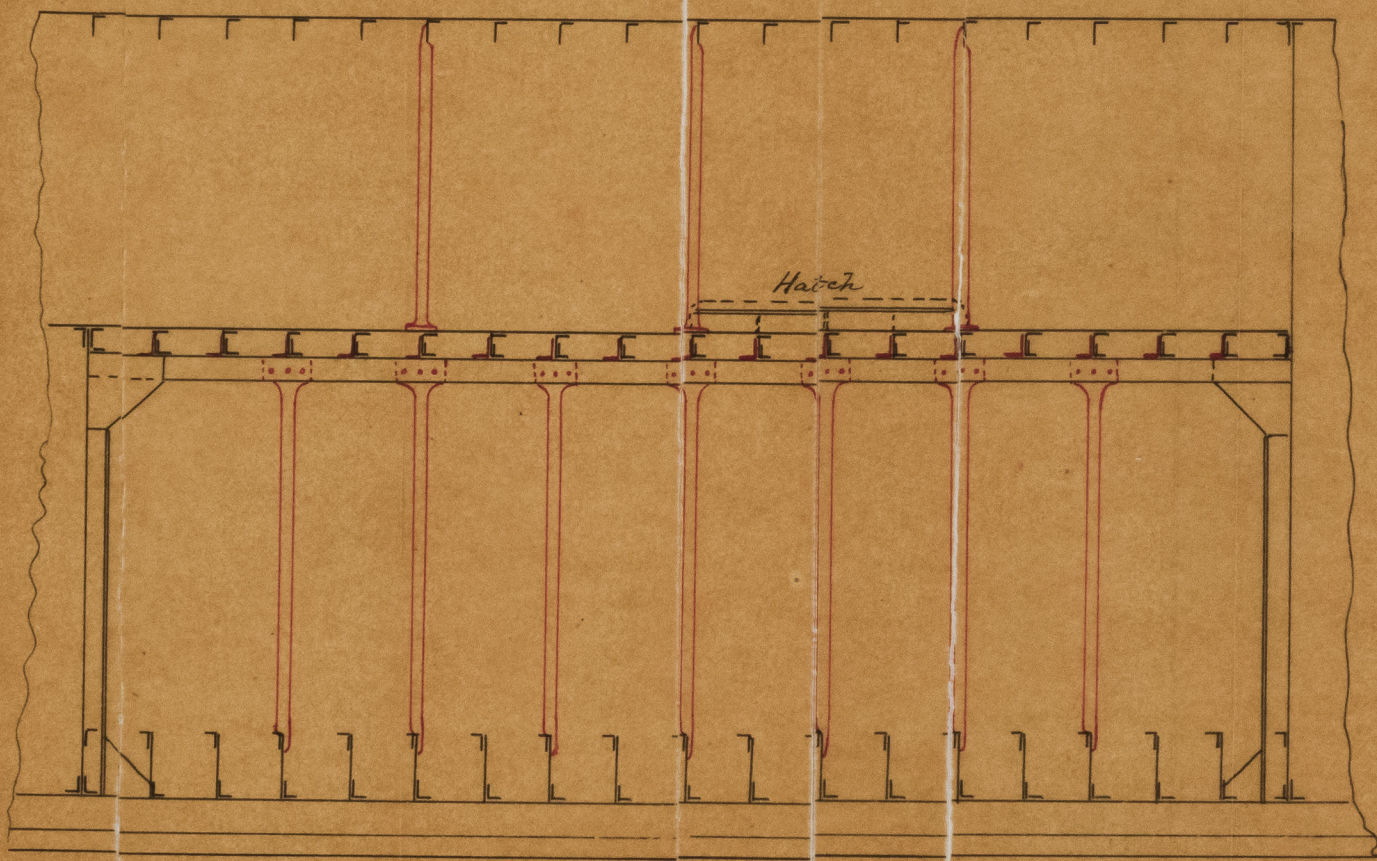

Scale $\frac{3}{16}'' = 1 \text{ foot.}$



2 Jan. 1879

1200523-009

© 2021
Lloyd's Register
Foundation