



Strengthening of Water Ballast Tank

Dec 31/12/78

Scale: $\frac{3}{16}'' = 1 \text{ Foot}$

S. S. Antonio

December 18. 1878 -

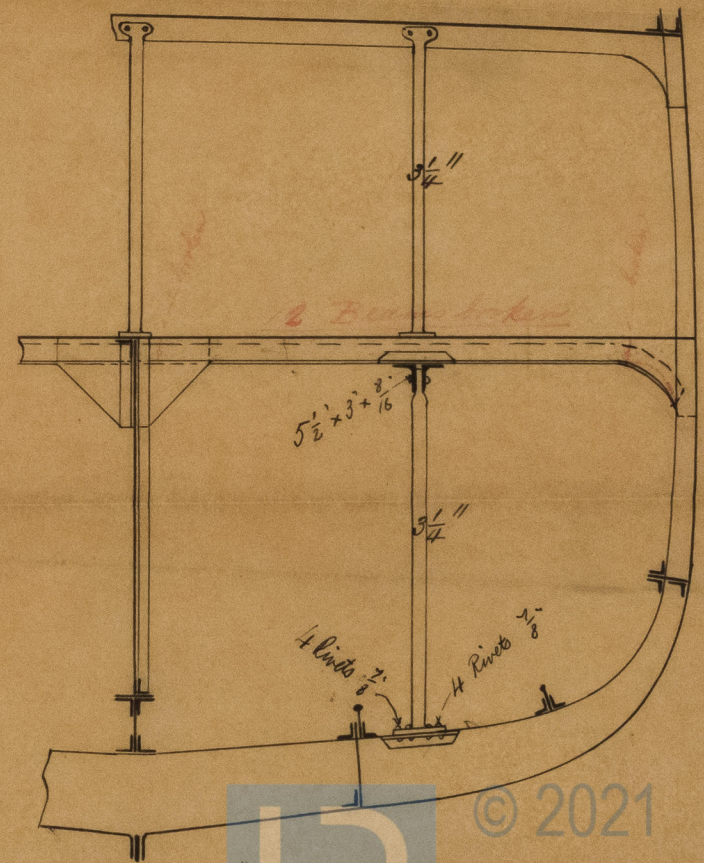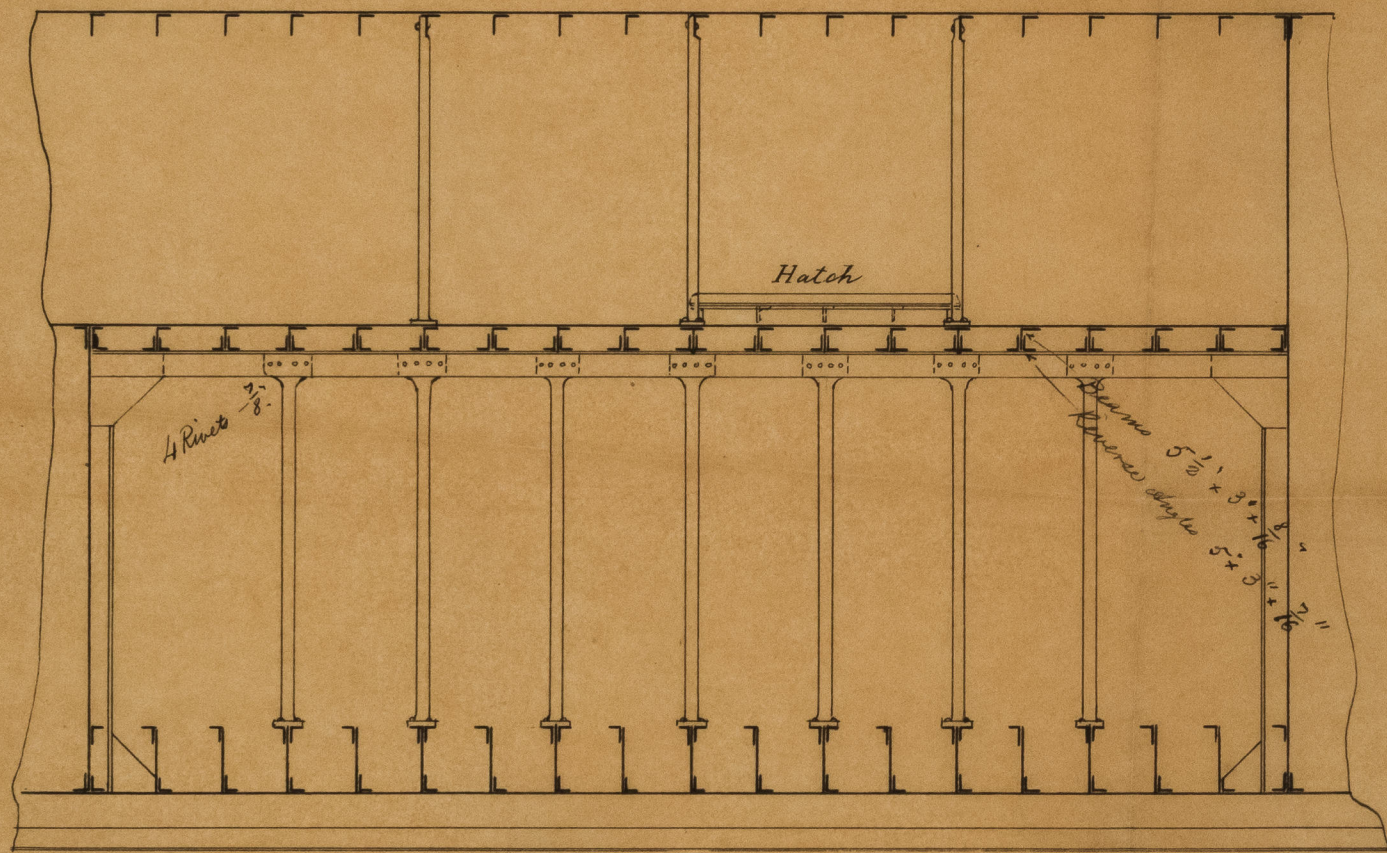

Charles Anshutt
Surveyor
Philadelphia

© 2021

Lloyd's Register
Foundation

IRON 523-0094