

MS H2 x 43

"Glenannor" - Report No. 3160 (Barrow)

MIDSHIP SECTION

"Glenannor" & "Glenlochy"


S. S. 220 x 27 "10 x 18" 8 1/2 hold.

Class 100 A


1/2 Breadth - - - - 13 "11"
Depth - - - - - 20 "4 1/2"
1/2 Girth - - - - 31 "10 1/2"
66 "2 x 219 = 14,491

10.77 Depths
7.9 Breadths

Scale 1/2 inch = 1 foot.

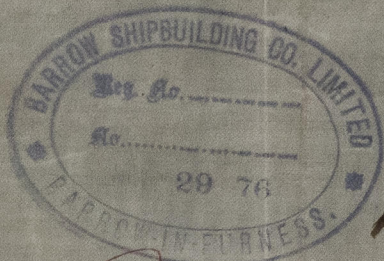

Rec 4/12/76

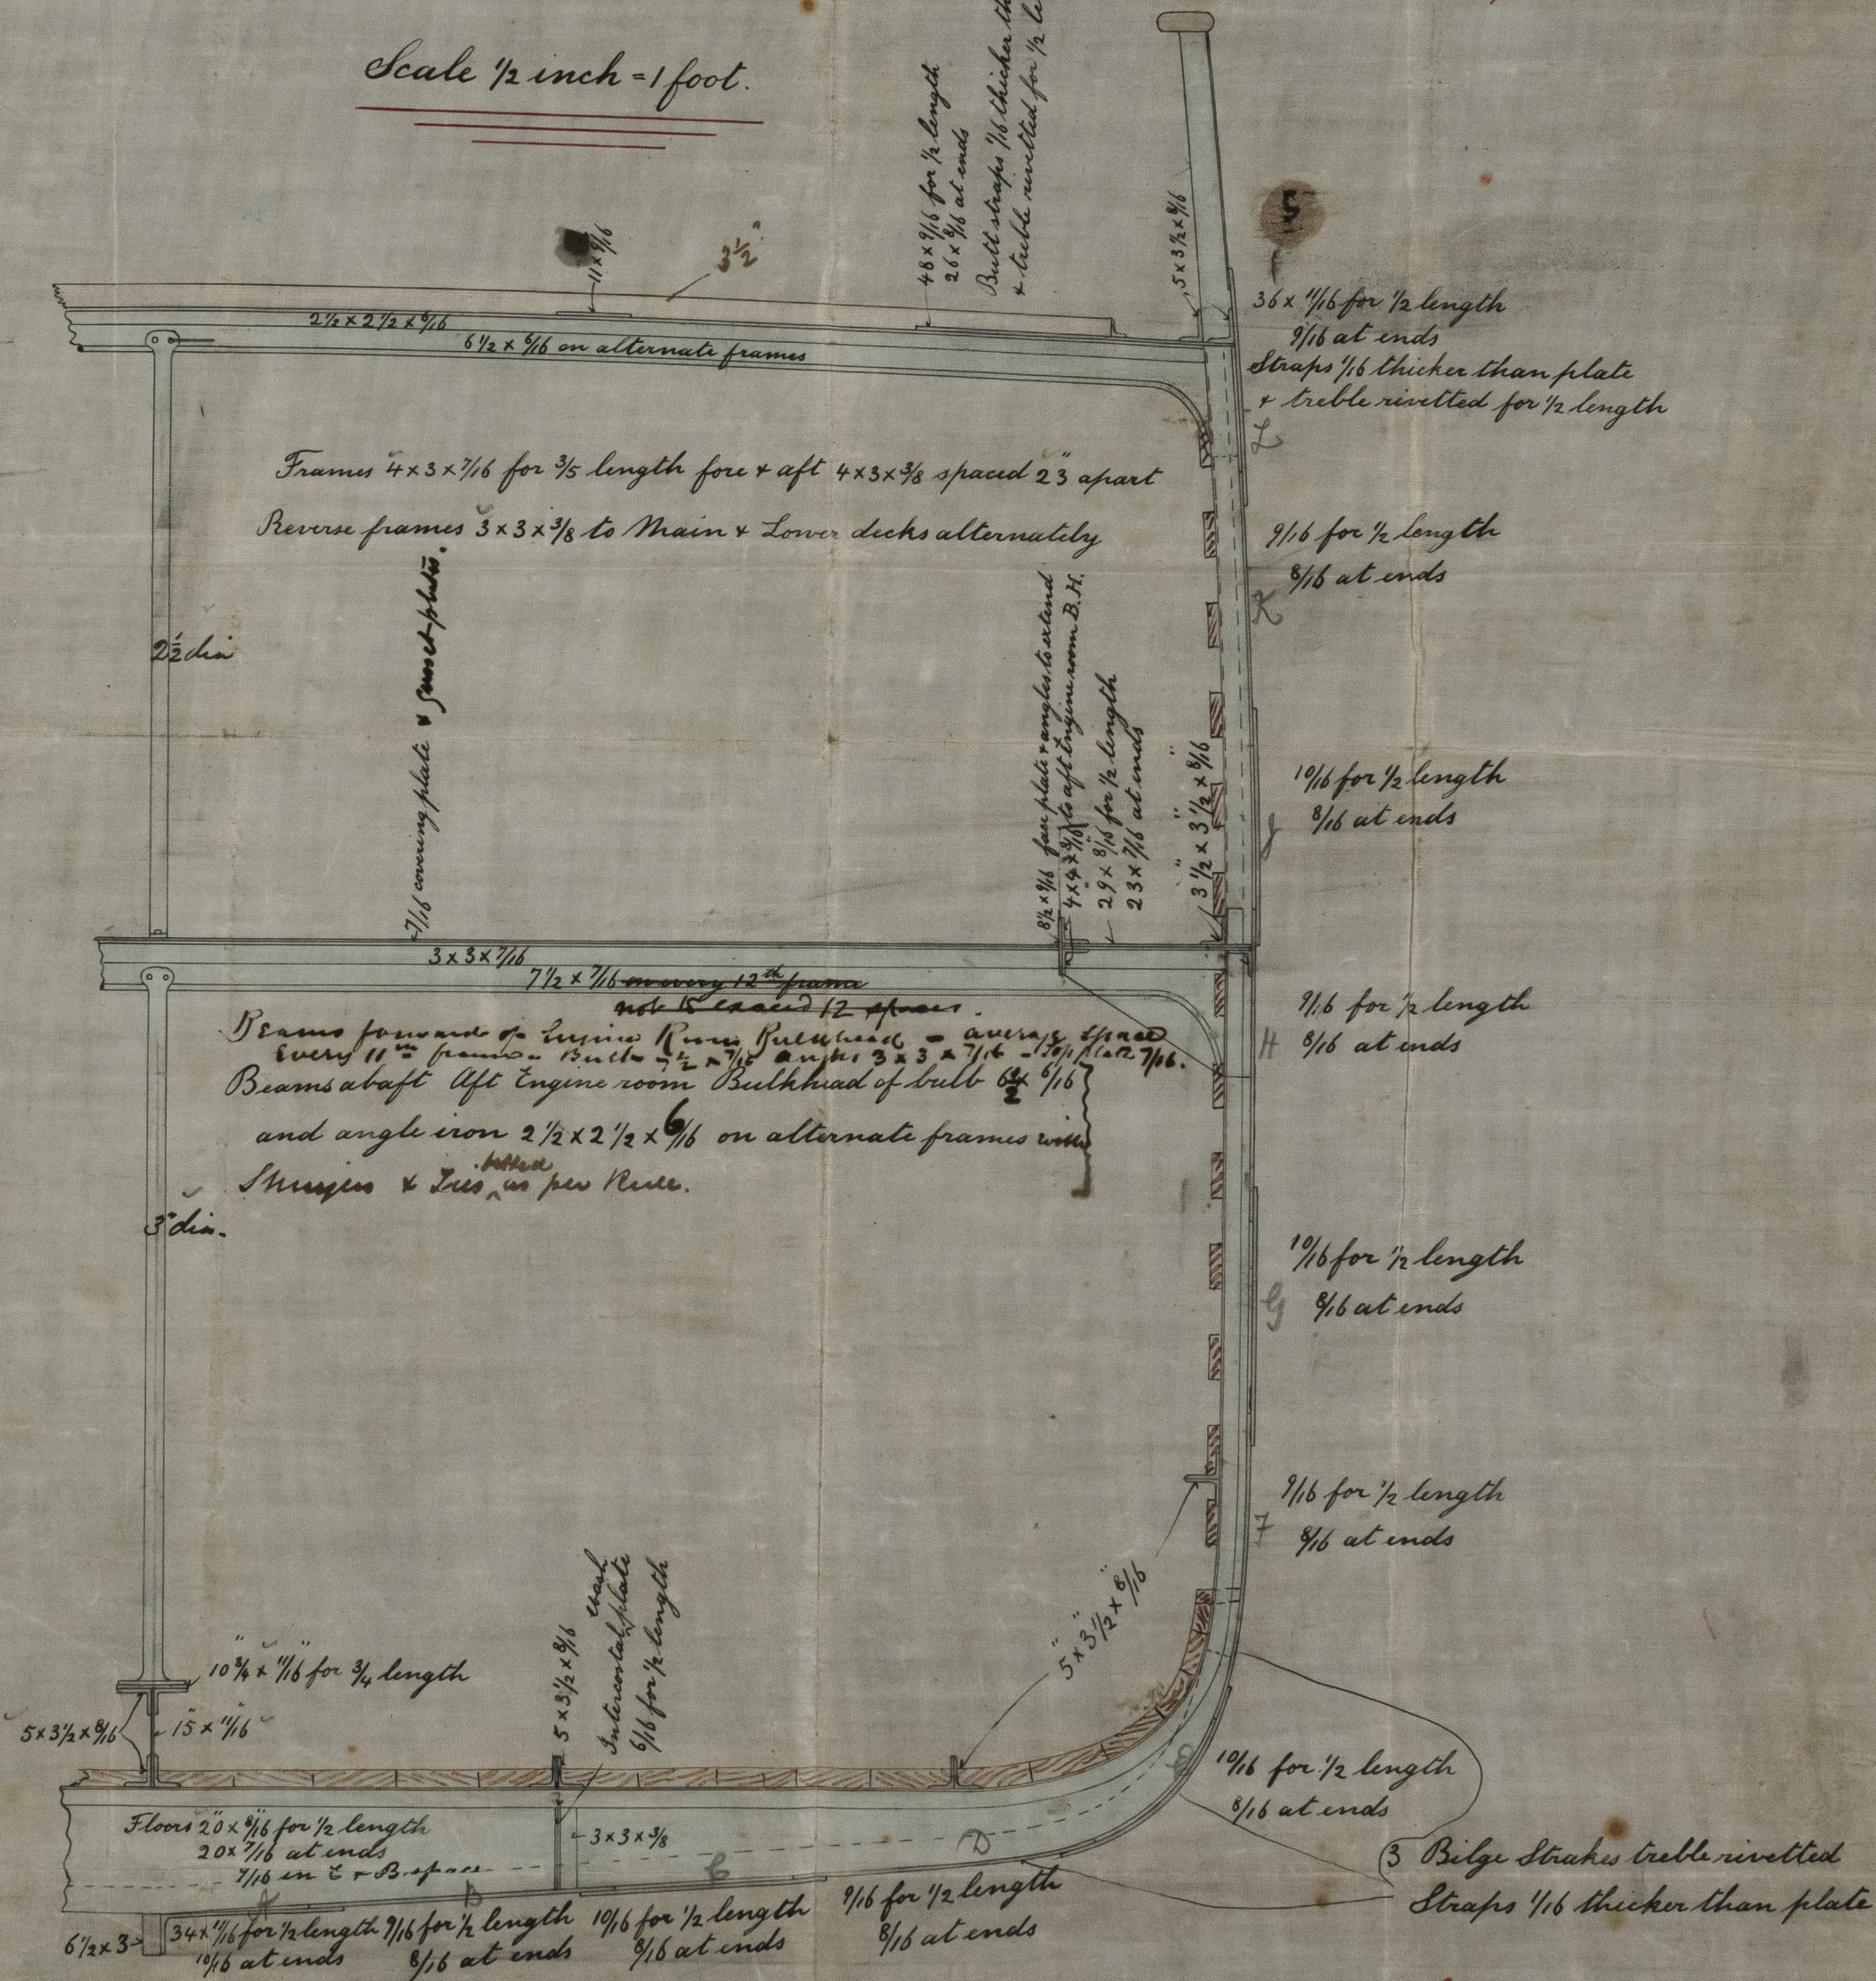

Stern post 7 1/2 x 4 3/4