

Length from aft of Stem to fore part of Post 238.9
Breadth Moulded - - - - - 30.10
Depth to Skin - - - - - 18.62
12 to 13 depths to Length
7 1/2 - 8 breadths

S. S. "Osprey" No of report 3903.

MIDSHIP SECTION

Iron 19511

No 156 SS


Scale 1/2 Inch to one Foot

240-0" x 31-0" x 17-0"

Class 100 A

Rev 17/2/77 & 10/10/77
1/2" thick 29.11"
1/2" breadth 15.5"
depth to floor 17.0"
" of floor plate 1-6 1/2"
63.103 x 238.9 = 15250

61 14300
65 15500

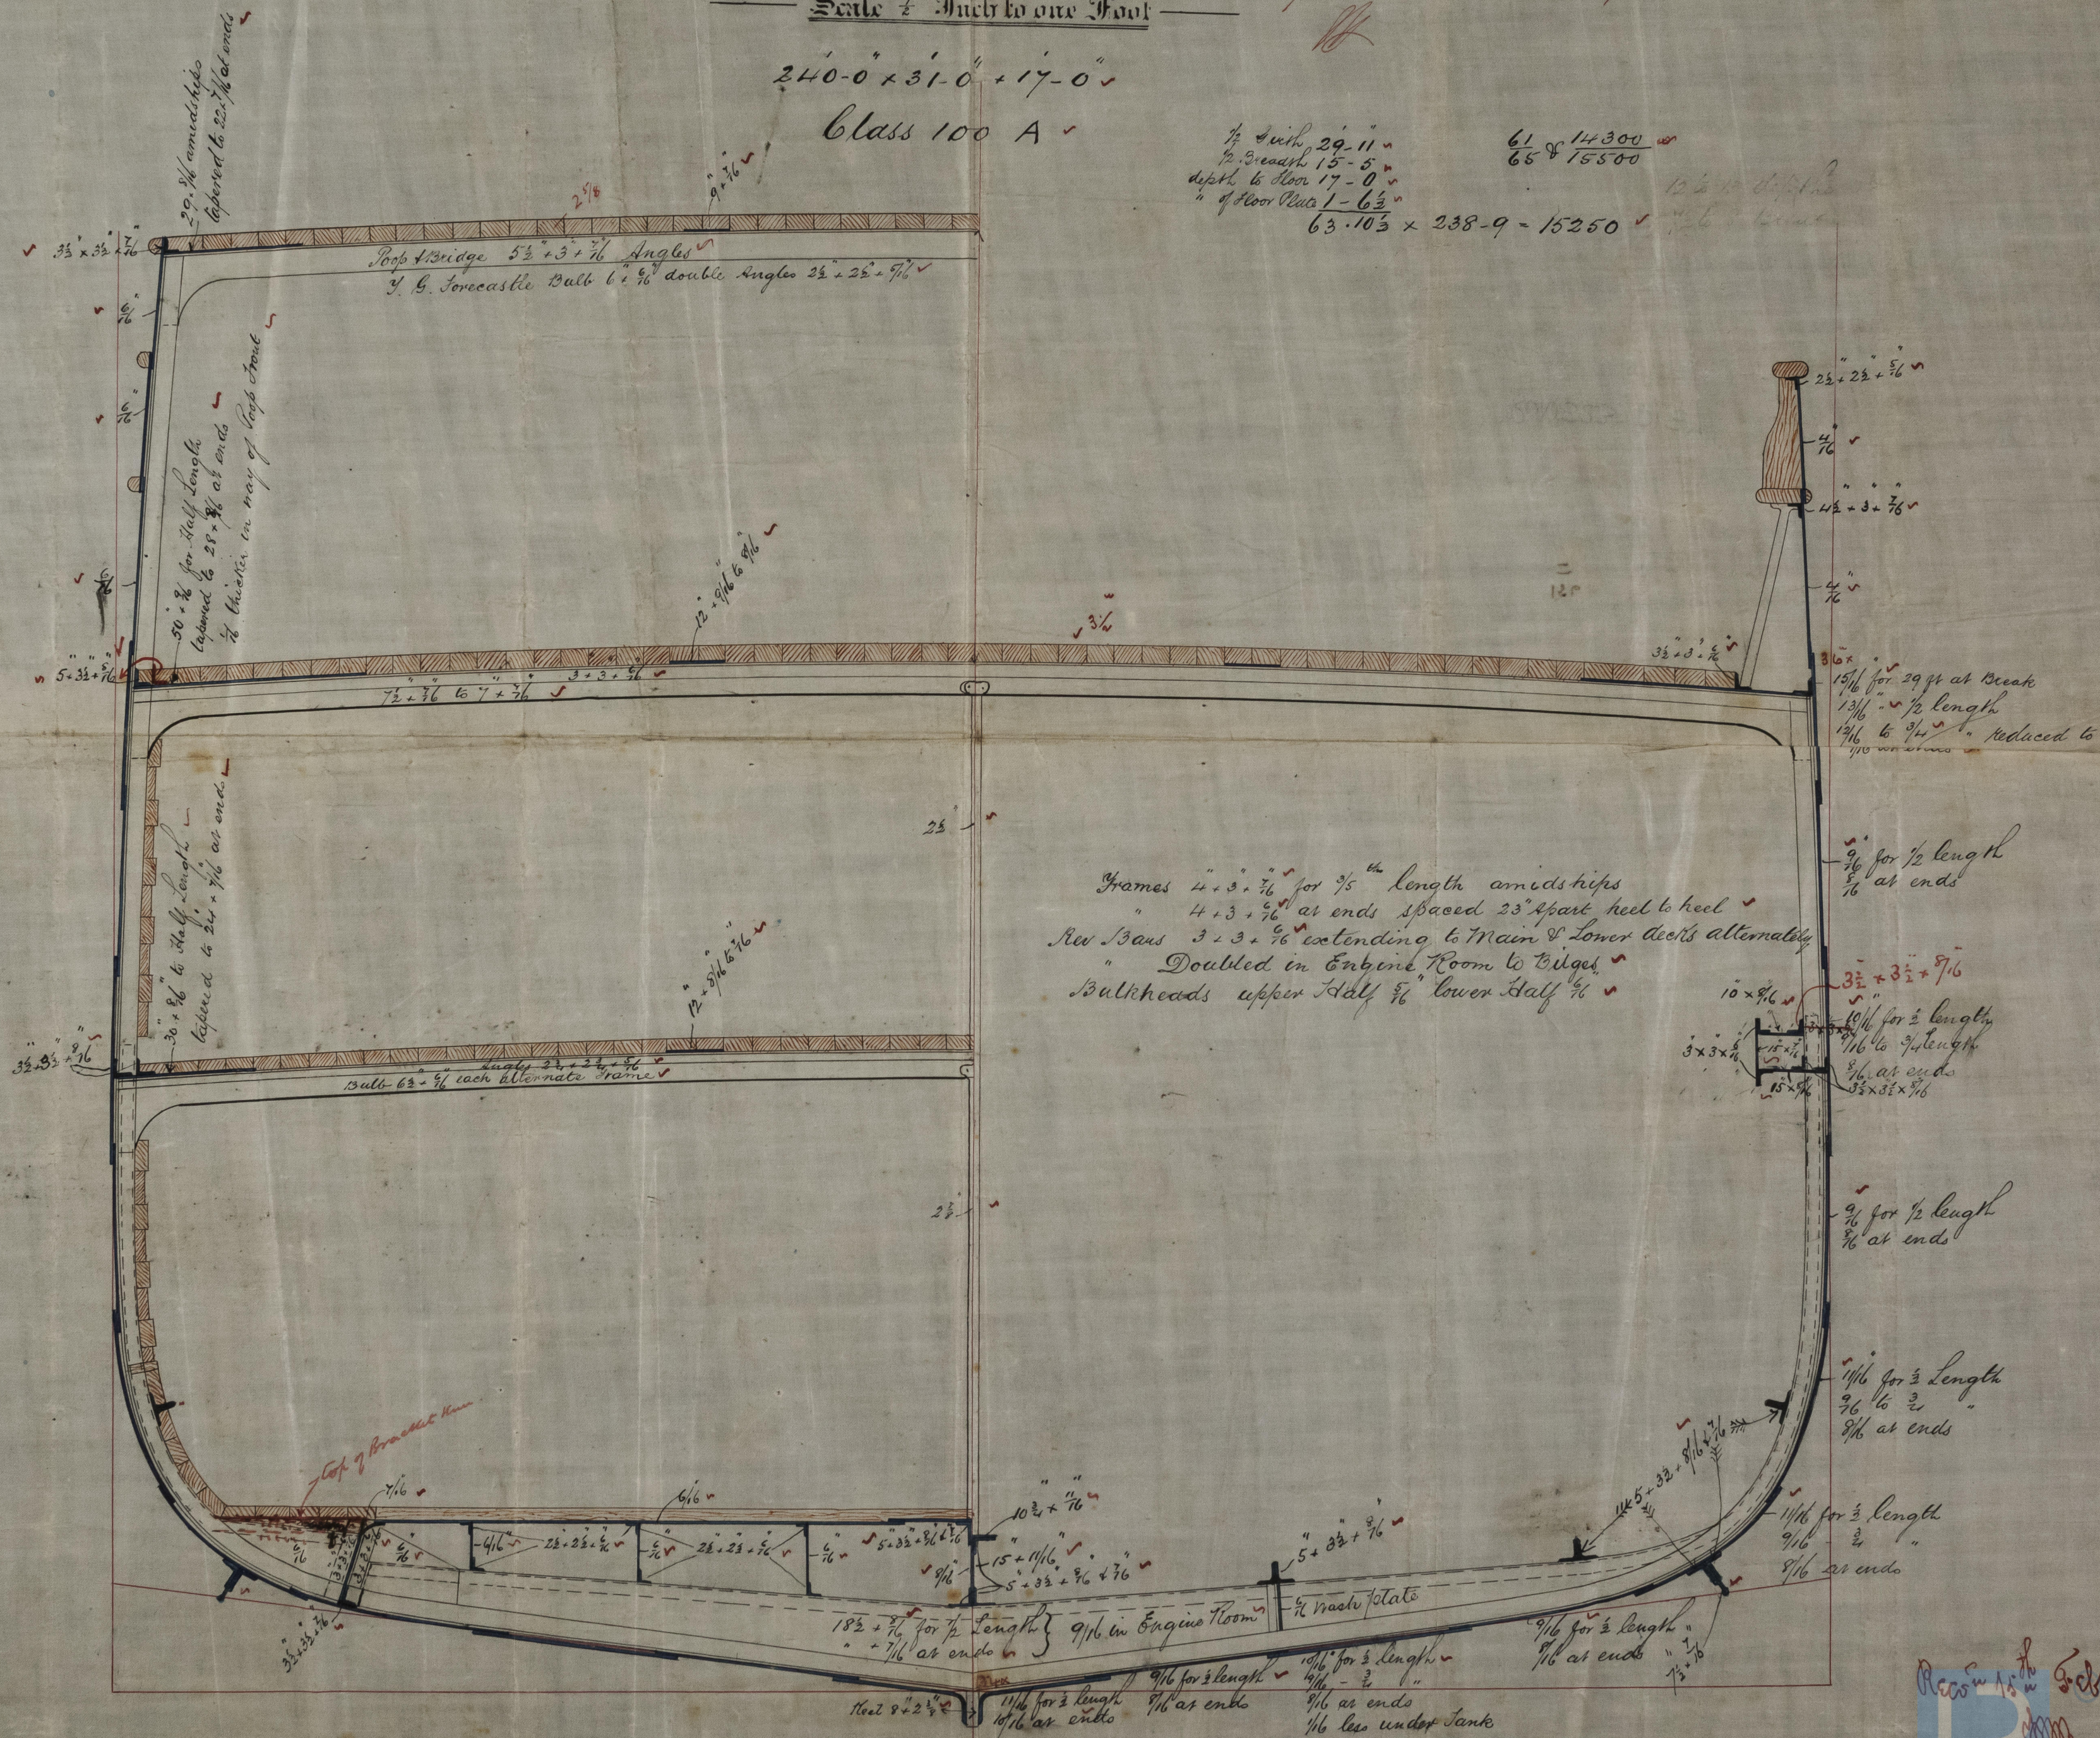

Recorded in Feb 1877

Lloyd's Register Foundation

IRON 523-0137

18/5/43












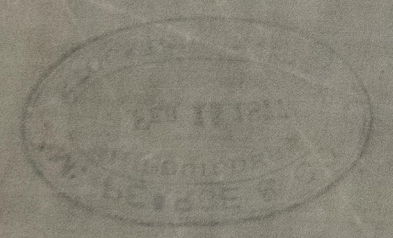

© 2021
Lloyd's Register
Foundation