


Bk. "Stuart." Dundee Rept. No. 4098.


19/1/77

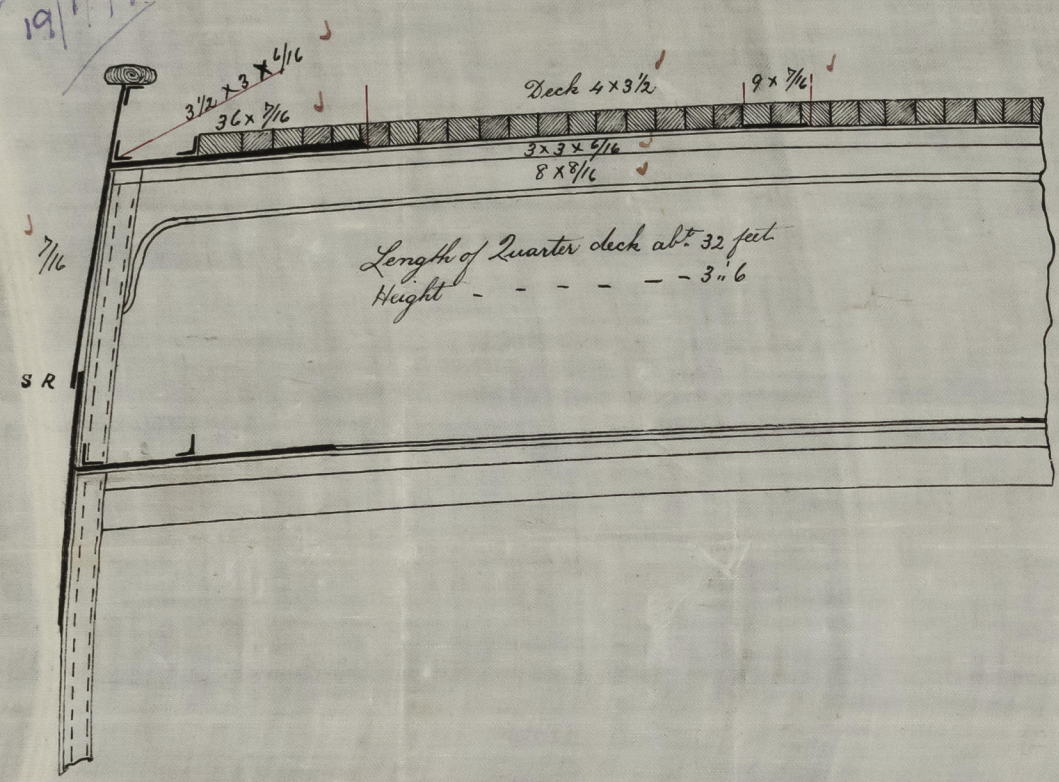


Midship Section  
of  
Ships No 67 & 68 to Flap 100A

Dimensions  
Length (as per Rule) - - - - - 195.0  
Breadth moulded - - - - - 34.0  
Depth from top of keel to upper Deck Beams - - - - - 21.54  
Girth of half Midship Section - - - - - 33.64  
Numbers to regulate scantlings 72.22 & 140.82  
Proportions length over 9 Depth and over 5 Breadths

Scale 1/2 in = 1 Foot

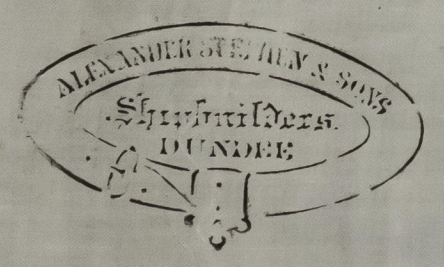

Rec. 19/1/77

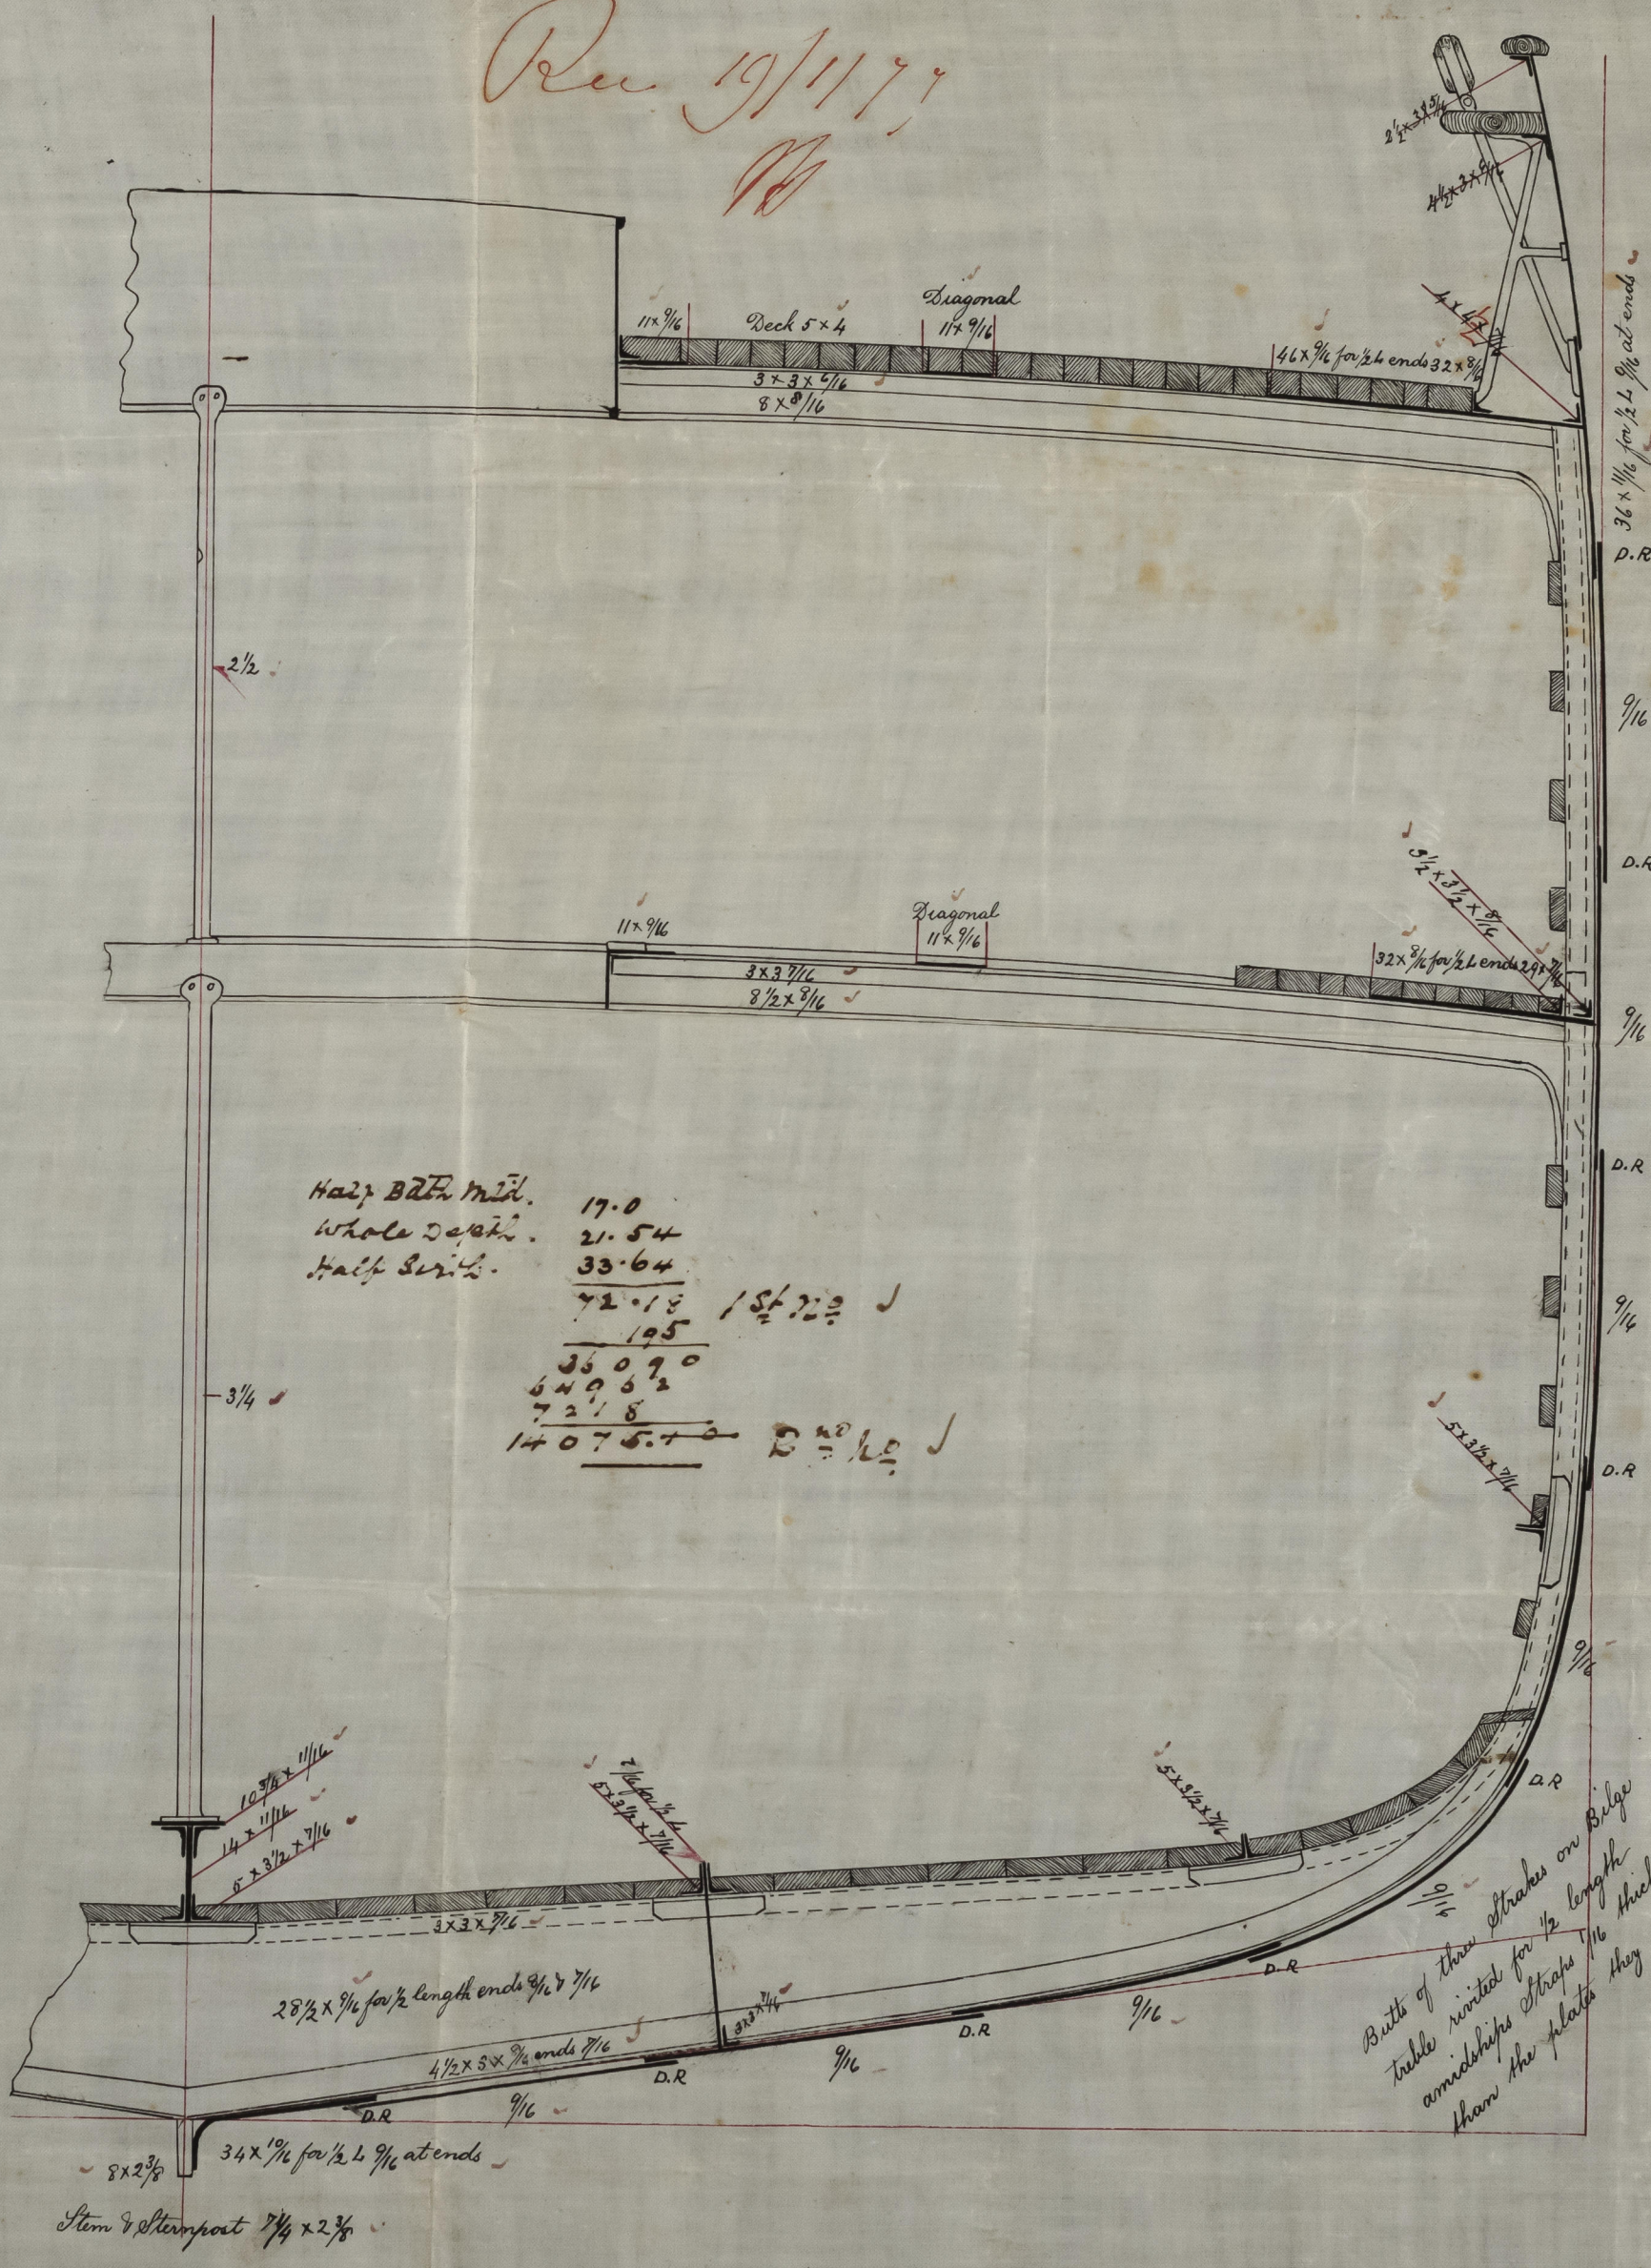

Butts of Main Stringer and Shear Strake to be riveted for 1/2 length amidships Straps 1/16 thicker than the plates they connect

Butts of these Strakes on Bilge to be riveted for 1/2 length amidships Straps 1/16 thicker than the plates they connect

Half B&F Mid. 17.0  
Whole Deck 21.54  
Half Strake 33.64  
72.18 184.22  
195  
33.070  
64.982  
72.18  
1407.570

18W  
19/1/77