


MIDSHIP SECTION FOR N^o 120

Dimensions
 Length (between perps) 180'-0"
 Breadth ----- 31'-6"
 Depth of Hold ----- 18'-3"



Sketch of Forecastle

Under 6 breadths & 9 Depths

Rev 22/9/77
 1/16

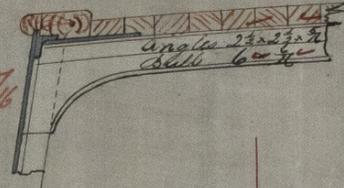

Sketch of Poop side

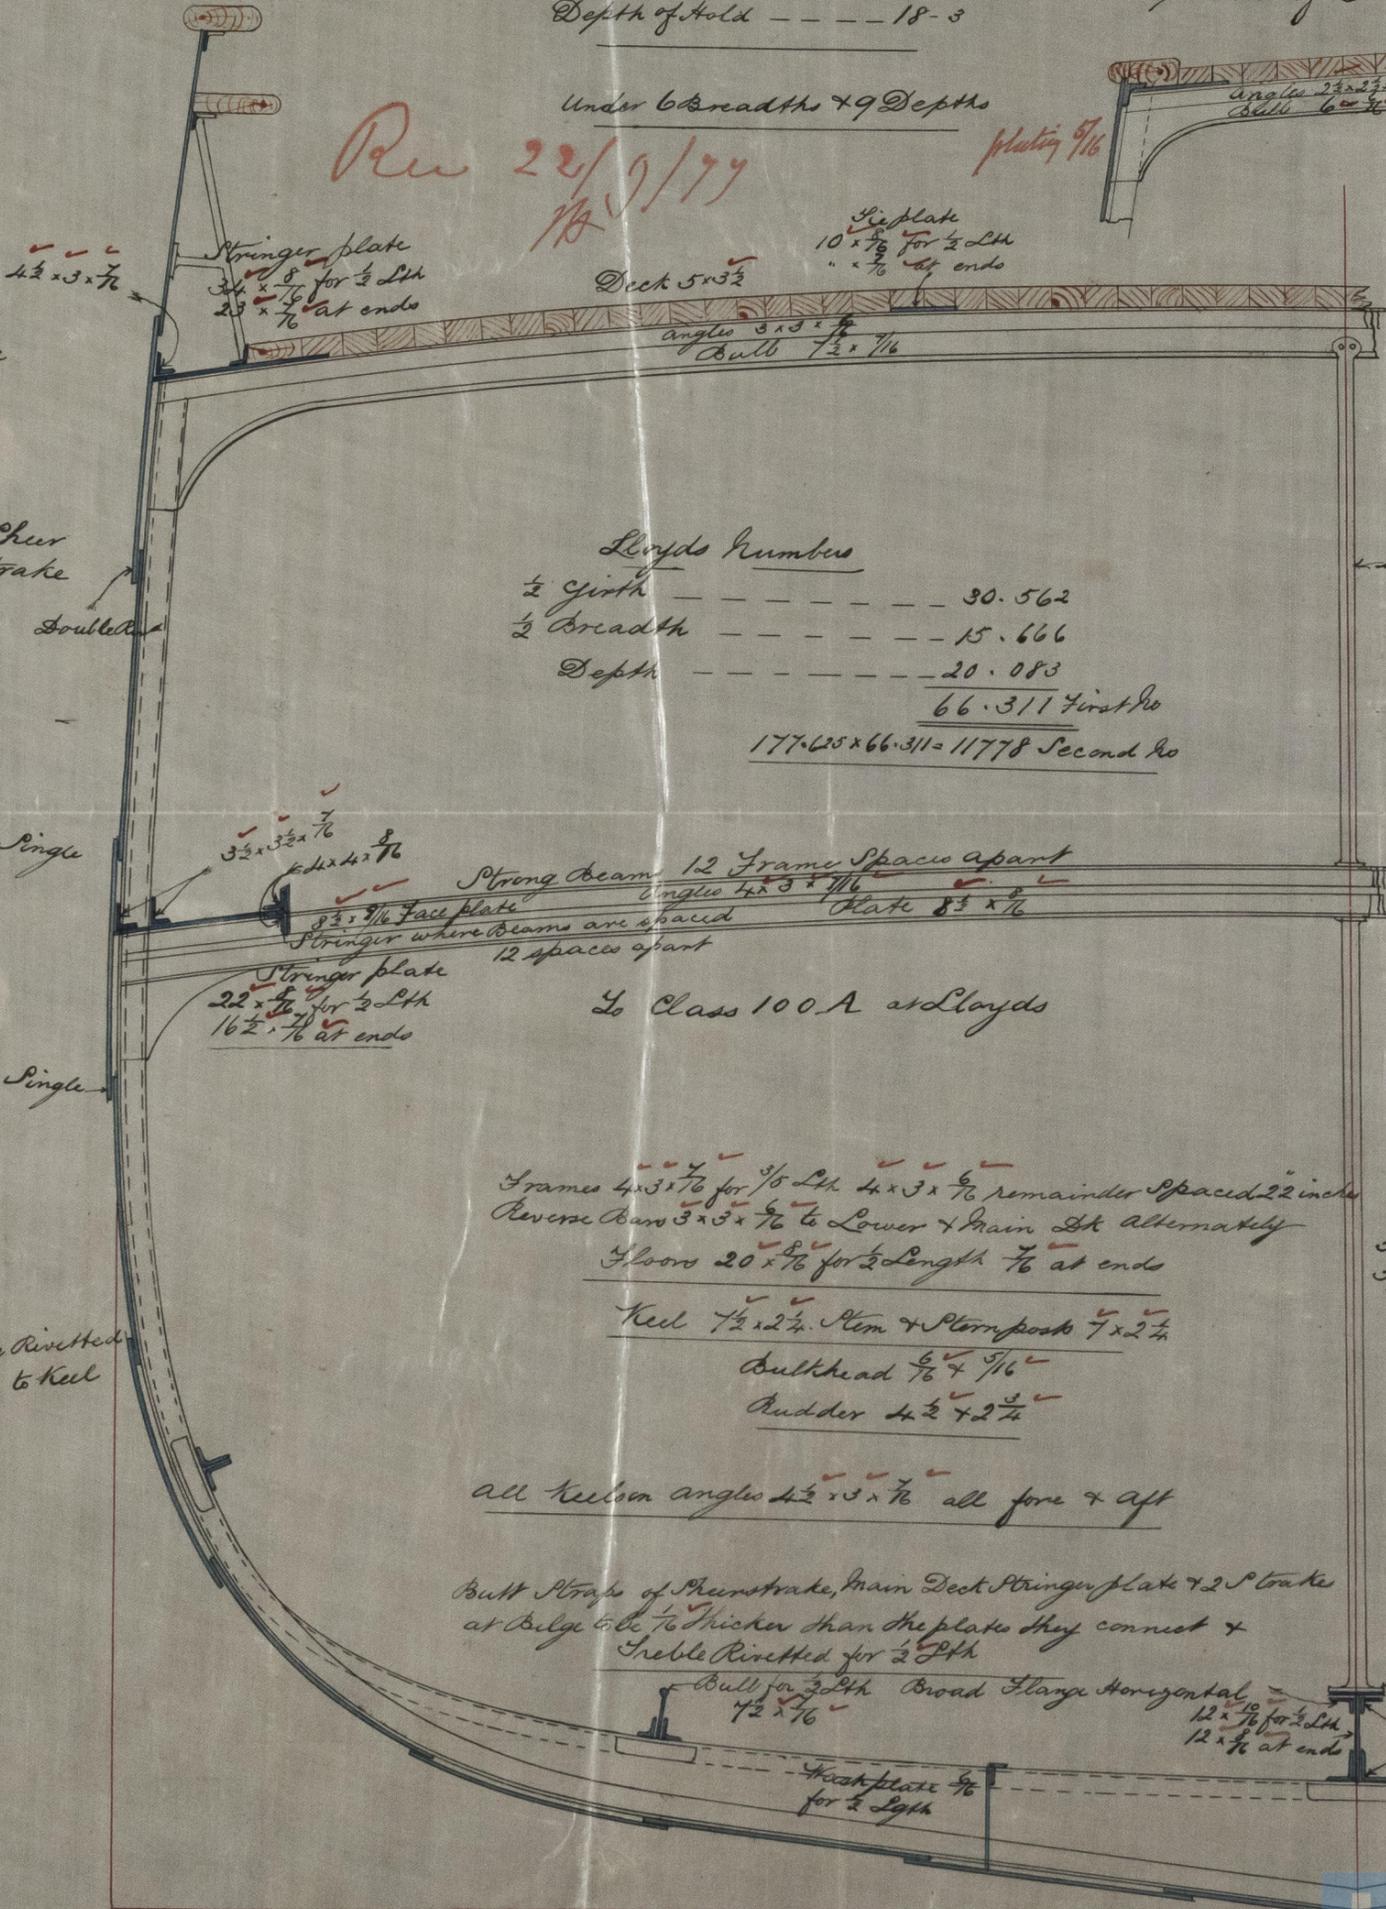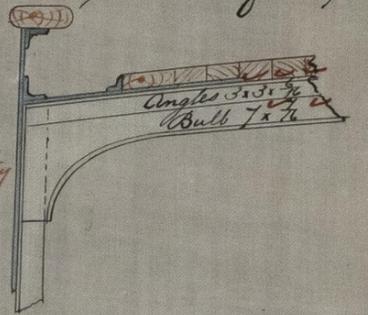

Sheer Strake
 33 x 10 for 1/2 Lth
 9 forward
 9 at end

Plating from Sheer to Gunboard Strake
 8 for 1/2 Lth
 7 at ends

Lloyds Numbers

| | |
|-------------|------------------------------------|
| 1/2 Girth | 30.562 |
| 1/2 Breadth | 15.666 |
| Depth | 20.083 |
| | 66.311 First No |
| | 177.625 x 66.311 = 11778 Second No |

Section of Hold Beams Spaced 12 Frame Spaces apart

Strong beam 12 Frame Spaces apart
 Angle 4 x 3 x 7/16
 Plate 8 x 7/16

Class 100.A at Lloyds

Frames 4 x 3 x 7/16 for 3/5 Lth 4 x 3 x 7/16 remainder Spaced 22 inches
 Reverse Bars 3 x 3 x 7/16 to Lower & Main Deck alternately
 Floors 20 x 7/16 for 1/2 Length 7/16 at ends

Keel 7 1/2 x 2 1/4 Stem & Stern posts 7 x 2 1/4
 Bulkhead 7 1/2 x 7/16
 Rudder 4 1/2 x 2 1/4

all keelson angles 4 1/2 x 3 x 7/16 all fore & aft

Butt Straps of Sheer Strake, Main Deck Stringer plate & 2^d Strake at Bilge to be 7/16 thicker than the plates they connect & Treble Rivetted for 1/2 Lth

Bull for 1/2 Lth Broad Flange Horizontal 7 1/2 x 7/16
 Wash plate 7/16 for 1/2 Lth

Rider plate 2 1/4 10 x 7/16
 4 1/2 x 3 x 7/16 No reduction at ends

32 x 7/16 for 1/2 Lth 7/16 at ends