
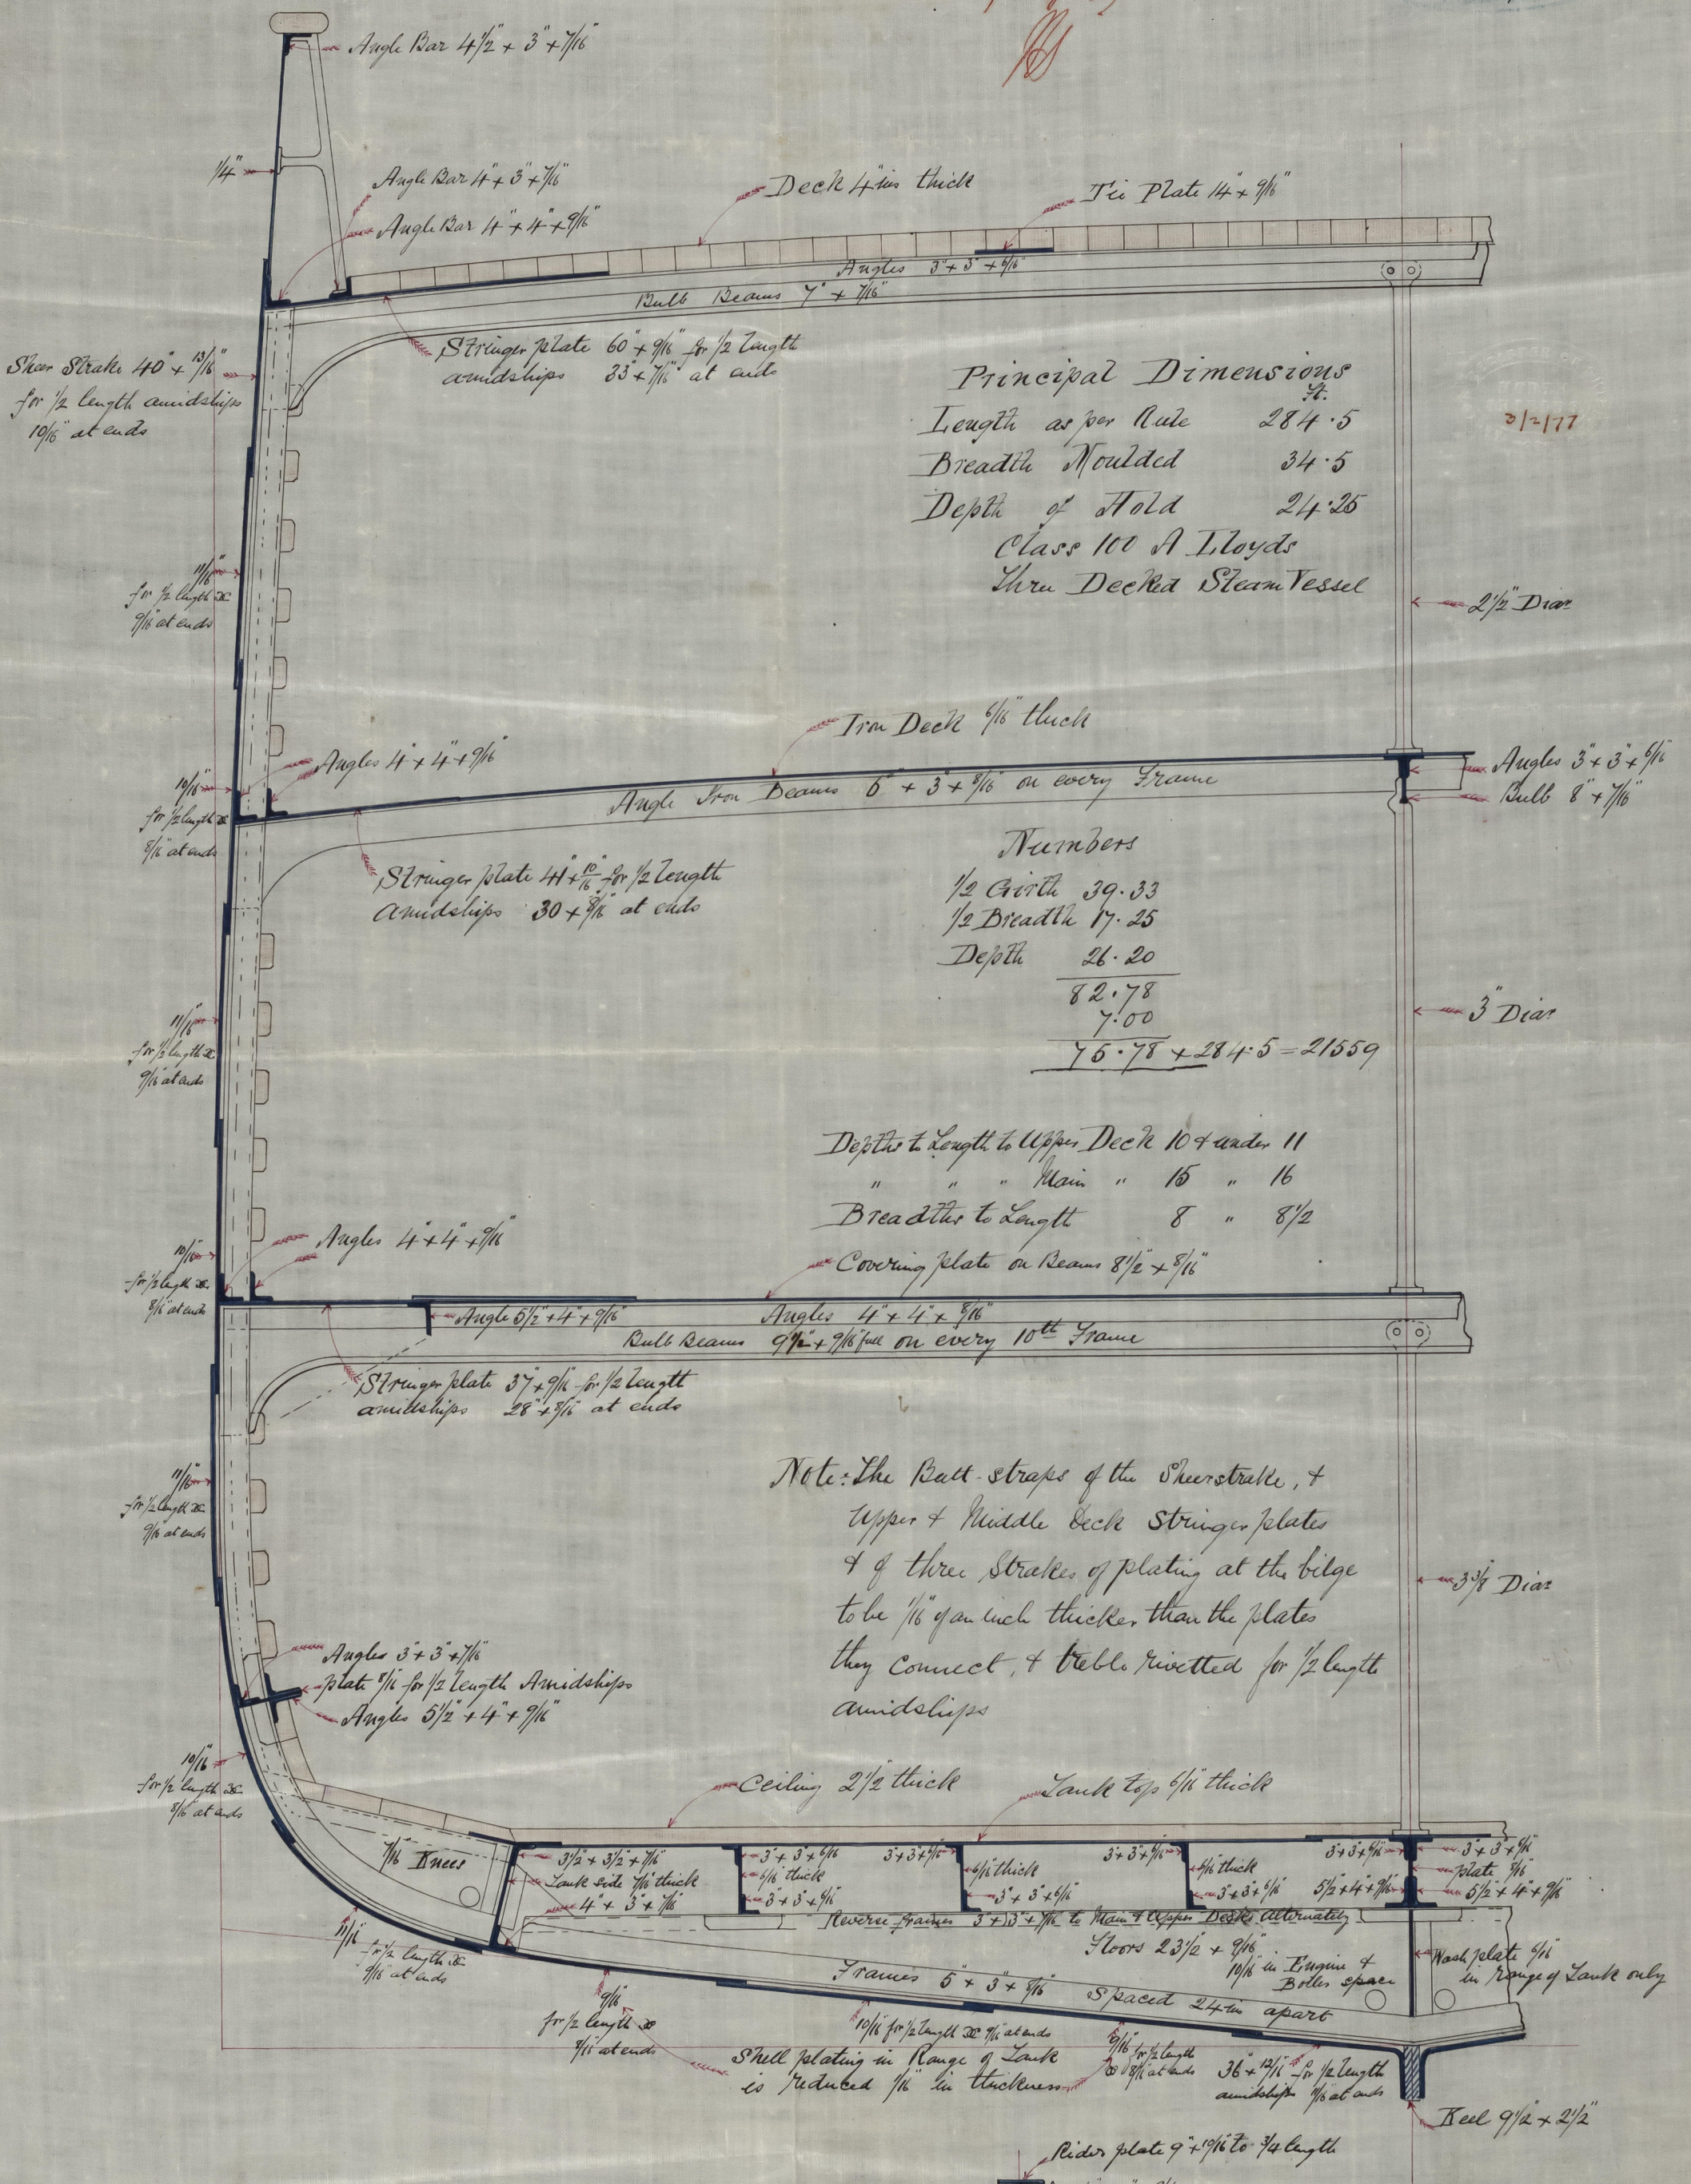
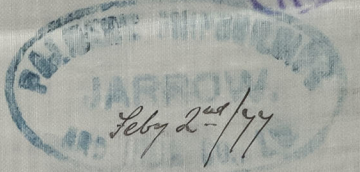


"Nerissa". Report No 1375-1.

Midship Section S.S. No 354

Scale 1/2 inch = one foot

Rev 6/2/77

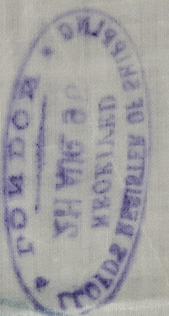

Principal Dimensions

Length as per Rule	284.5
Breadth Moulded	34.5
Depth of Hold	24.25
Class 100 A Lloyd's	
Thru Decked Steam Vessel	

Numbers

$\frac{1}{2}$ Girth	39.33
$\frac{1}{2}$ Breadth	17.25
Depth	26.20
82.78	
7.00	
75.78 + 284.5 = 2159	

Depth to Length to Upper Deck 10' under 11'


" " Main " 15' " 16'

Breadth to Length 8' " 8 1/2'

Covering plate on Beams $8 \frac{1}{2} \times 8 \frac{1}{16}$

Note: The Batt. straps of the Sherstrake, & Upper & Middle Deck Stringer plates & of three Strakes of plating at the bilge to be $\frac{1}{16}$ of an inch thicker than the plates they connect, & bebb rivetted for $\frac{1}{2}$ length amidships

Section of Centre Keelson before Water Ballast Lark

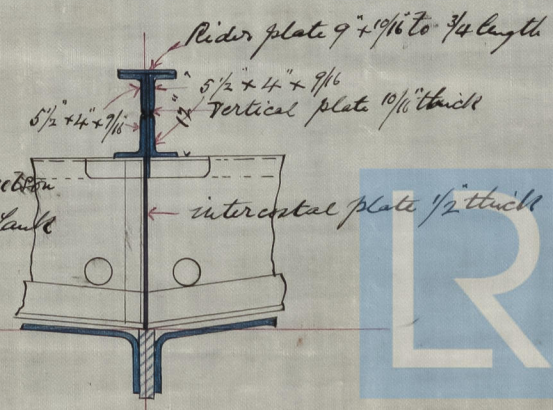

1802
672/77

LLOYD'S REGISTER OF SHIPPING
 RECEIVED
 21 AUG. 96
 LONDON

Lloyd's Register
Foundation